


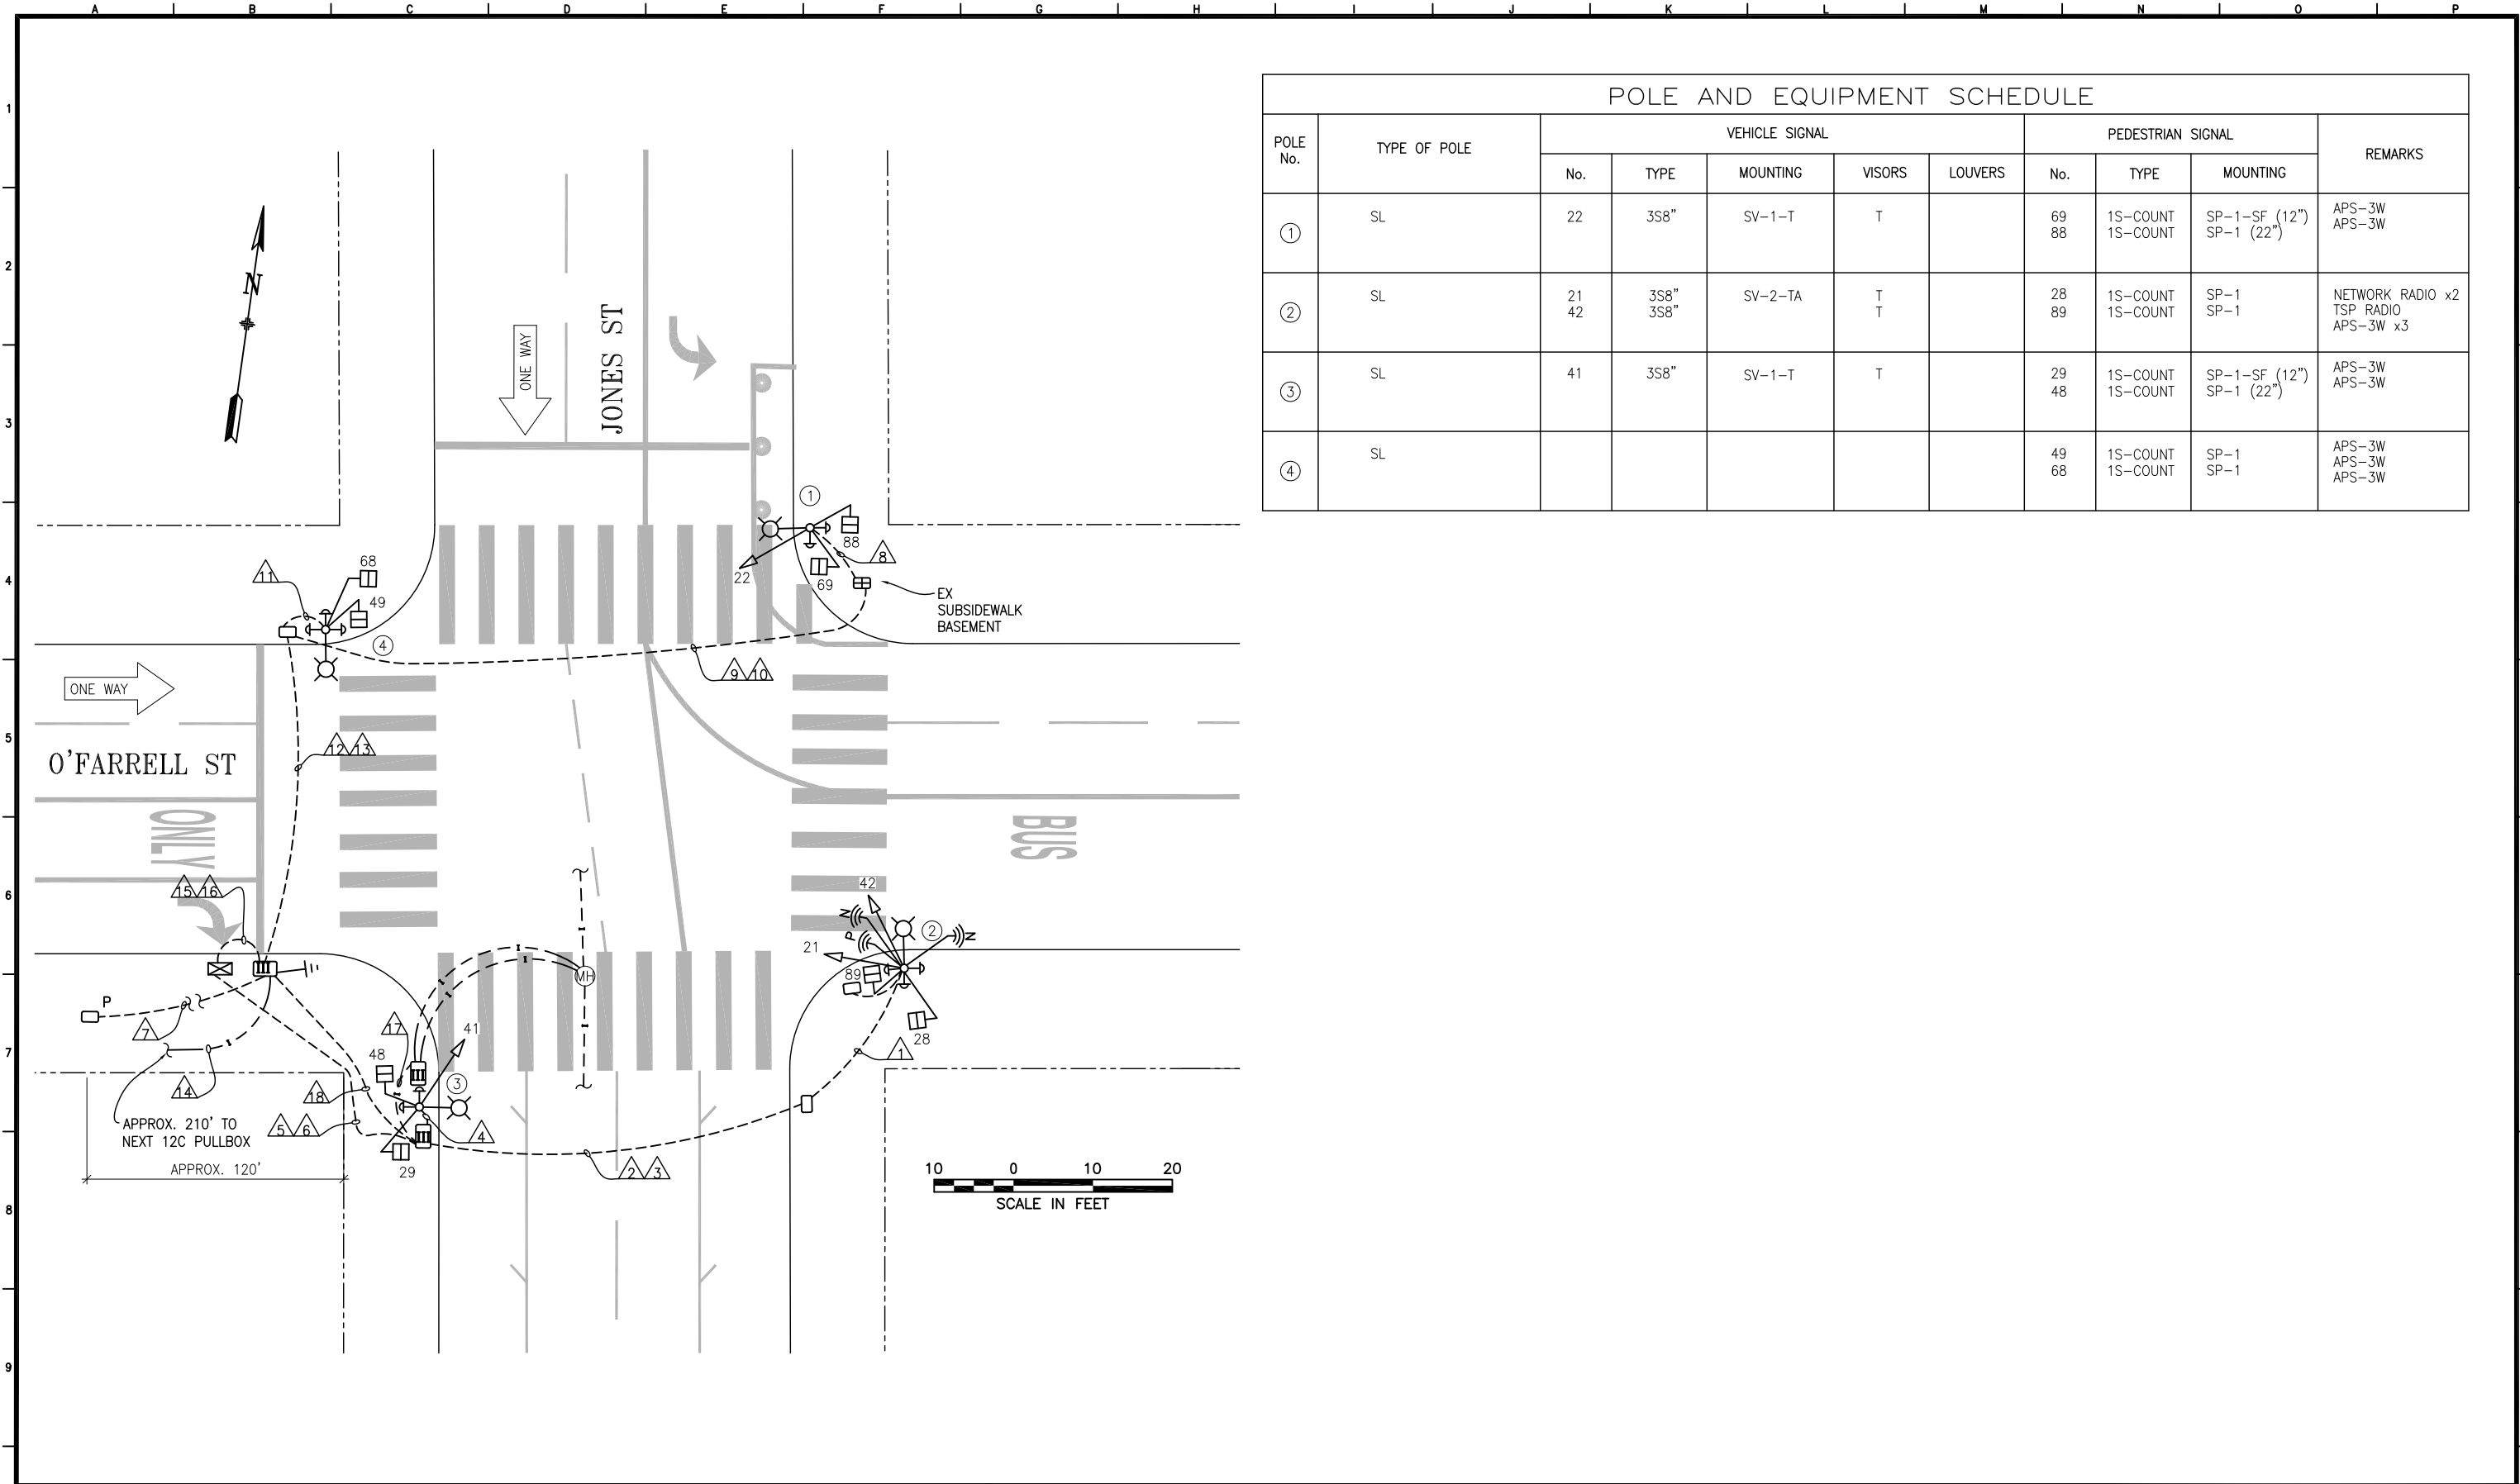

| POLE AND EQUIPMENT SCHEDULE |              |                |              |          |        |         |                   |                      |                             |                                            |
|-----------------------------|--------------|----------------|--------------|----------|--------|---------|-------------------|----------------------|-----------------------------|--------------------------------------------|
| POLE No.                    | TYPE OF POLE | VEHICLE SIGNAL |              |          |        |         | PEDESTRIAN SIGNAL |                      |                             | REMARKS                                    |
|                             |              | No.            | TYPE         | MOUNTING | VISORS | LOUVERS | No.               | TYPE                 | MOUNTING                    |                                            |
| ①                           | SL           | 22             | 3S8"         | SV-1-T   | T      |         | 69<br>88          | 1S-COUNT<br>1S-COUNT | SP-1-SF (12")<br>SP-1 (22") | APS-3W<br>APS-3W                           |
| ②                           | SL           | 21<br>42       | 3S8"<br>3S8" | SV-2-TA  | T<br>T |         | 28<br>89          | 1S-COUNT<br>1S-COUNT | SP-1<br>SP-1                | NETWORK RADIO x2<br>TSP RADIO<br>APS-3W x3 |
| ③                           | SL           | 41             | 3S8"         | SV-1-T   | T      |         | 29<br>48          | 1S-COUNT<br>1S-COUNT | SP-1-SF (12")<br>SP-1 (22") | APS-3W<br>APS-3W                           |
| ④                           | SL           |                |              |          |        |         | 49<br>68          | 1S-COUNT<br>1S-COUNT | SP-1<br>SP-1                | APS-3W<br>APS-3W<br>APS-3W                 |

| NO.                                                                | DATE    | DESCRIPTION                                                            | BY       | APPROVED   |
|--------------------------------------------------------------------|---------|------------------------------------------------------------------------|----------|------------|
| Δ                                                                  | 4/27/23 | ADD NEW APS PER SRC 2022-199. CLARIFY TSP/NETWORK EQUIPMENT            | D. YEUNG | G. DE LEON |
| Δ                                                                  | 5/23/22 | UPDATE PER FIELD: NOTE POLE 2 MOUNTING/VISORS/TSP. UPDATE CABINET SIZE | D. YEUNG | G. DE LEON |
| Δ                                                                  | 12/9/06 | UPGRADE ACTIVATED THRU 0872J - CONVERTED FROM CONTRACT PLANS           | D. YEUNG | G. DE LEON |
| TABLE OF REVISIONS                                                 |         |                                                                        |          |            |
| CHECKOUT DRAWING THROUGH THE SID CUSTODIAN FOR THE LATEST REVISION |         |                                                                        |          |            |



SFMTA

|                           |                 |
|---------------------------|-----------------|
| DRAWN BY:<br>D. YEUNG     | DATE:<br>3/2022 |
| CHECKED BY:<br>G. DE LEON | DATE:<br>3/2022 |

|                           |
|---------------------------|
| SCALE<br>AS SHOWN         |
| SHEET OF SHEETS<br>1 OF 2 |

|                                  |
|----------------------------------|
| TRAFFIC SIGNAL INVENTORY DIAGRAM |
| JONES ST & O'FARRELL ST          |

|                     |
|---------------------|
| CNN NO:<br>24945000 |
| REV NO:<br>2        |

