


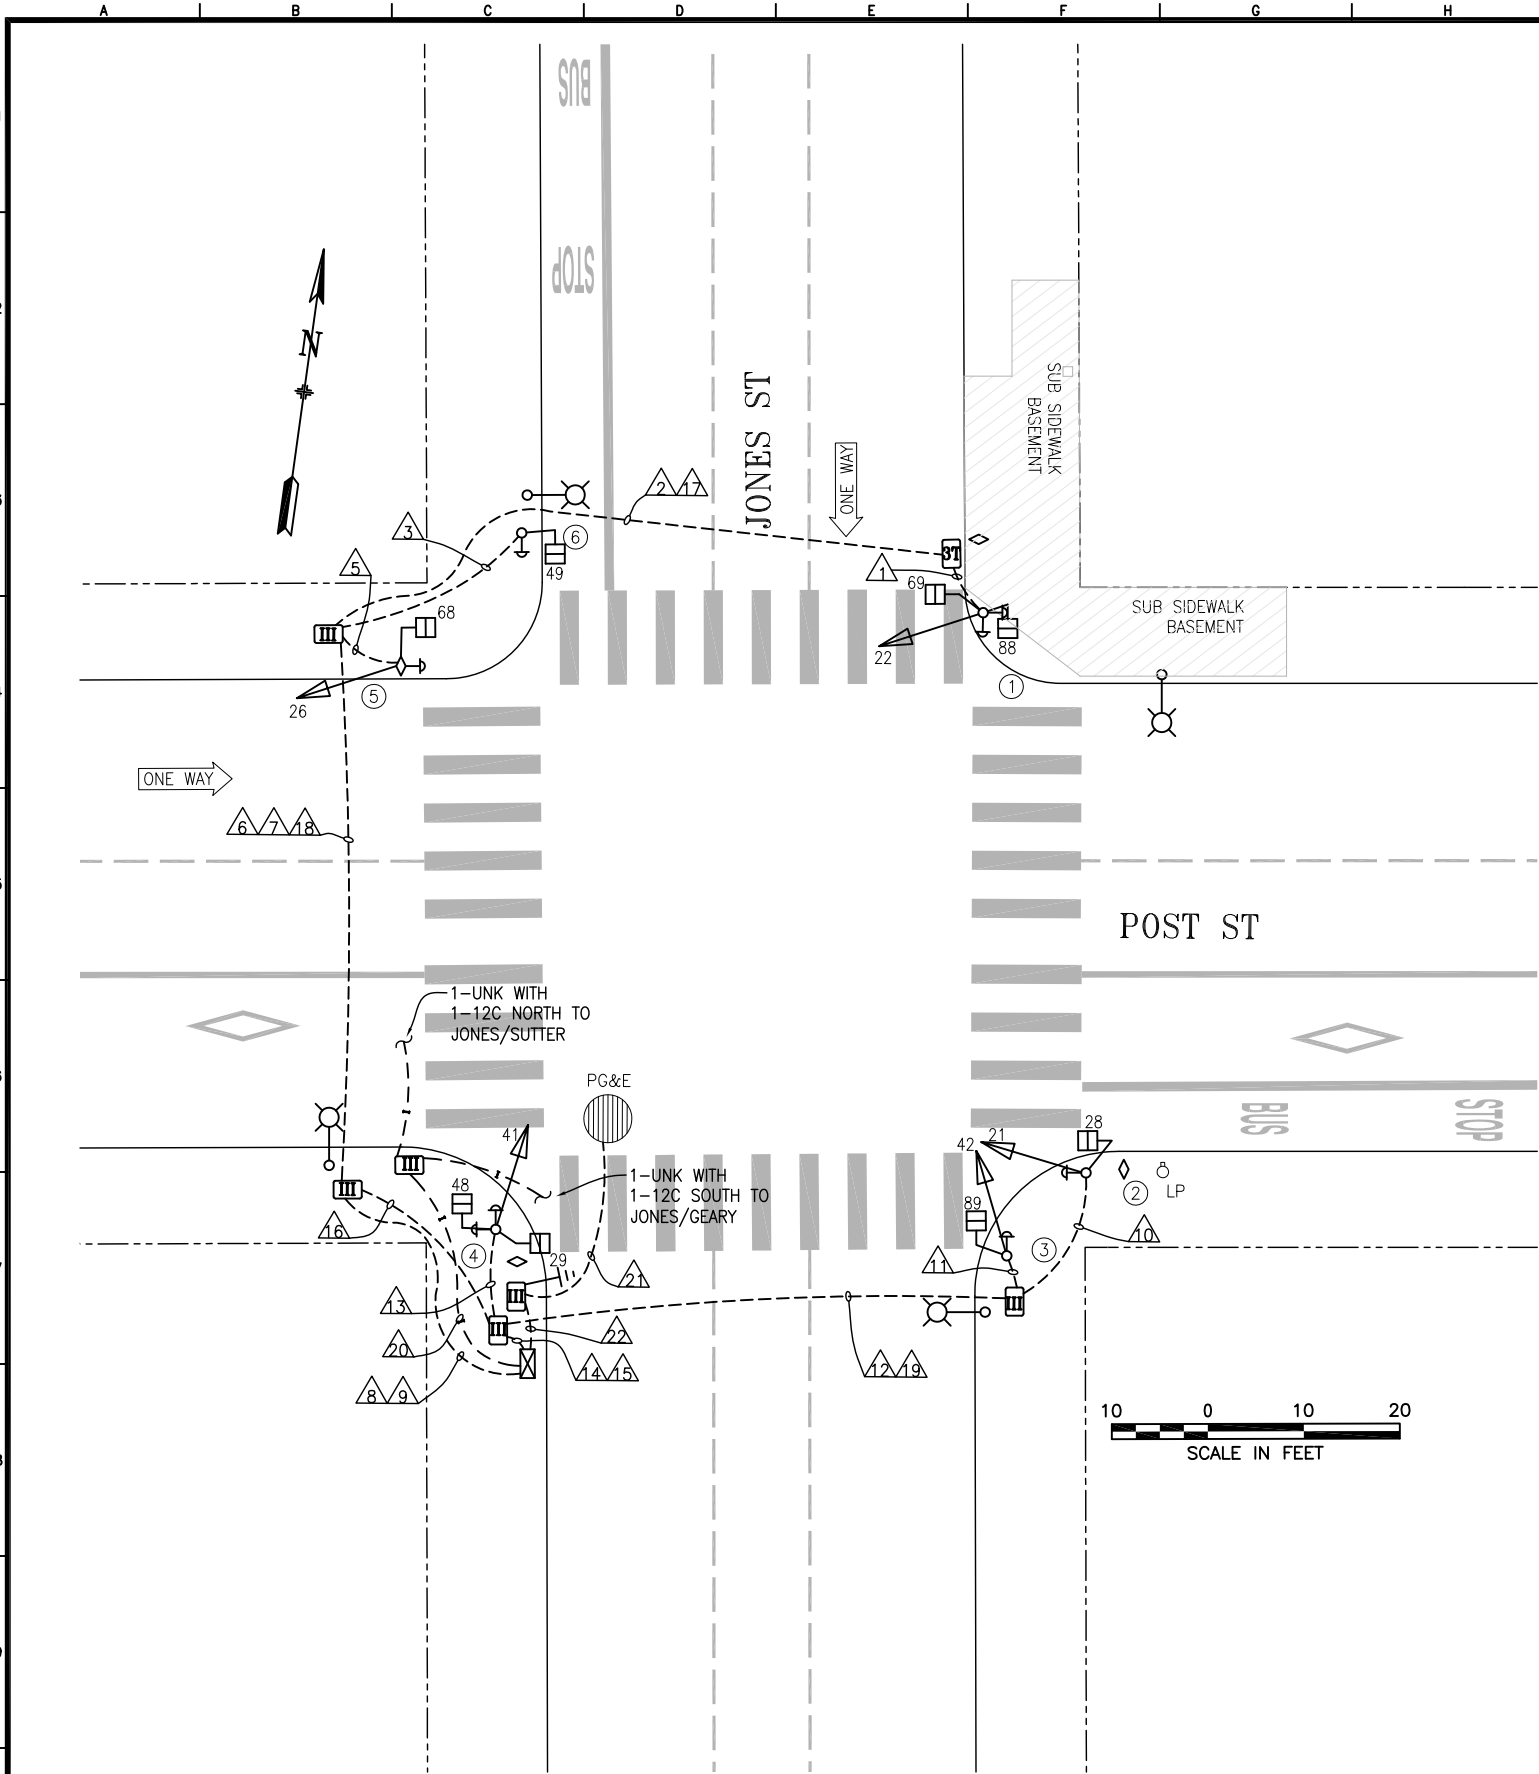

POLE AND EQUIPMENT SCHEDULE										
POLE No.	TYPE OF POLE	LUMINAIRE VOLTAGE/WATTAGE	VEHICLE SIGNAL				PEDESTRIAN SIGNAL			REMARKS
			No.	TYPE	MOUNTING	VISORS	No.	TYPE	MOUNTING	
①	1-A (10')		22	3S12"	TV-1-T	T	69 88	1S-COUNT 1S-COUNT	SP-1-SF (12") SP-1 (22")	APS-2W APS-2W
②	1-A (10')		21	3S12"	TV-1-T	T	28	1S-COUNT	SP-1	APS-2W
③	1-A (10')		42	3S12"	TV-1-T	T	89	1S-COUNT	SP-1	APS-2W
④	1-A (10')		41	3S12"	TV-1-T	T	29 48	1S-COUNT 1S-COUNT	SP-1-SF (12") SP-1 (22")	APS-2W APS-2W
⑤	MUNI POLE		26	3S12"	SV-1-T	T	68	1S-COUNT	SP-1	APS-2W
⑥	1-A (7')						49	1S-COUNT	TP-1	APS-2W

NOTE: APS BUTTONS TO BE INSTALLED AT A LATER DATE

TABLE OF REVISIONS			CHECK WITH TRACING TO SEE IF YOU HAVE LATEST REVISION	
NO.	DATE	DESCRIPTION	BY	APP.
1	7/26/21	ADD 12C NOTES AT SW CORNER, PER 2823J AS-BUILTS	DYeung	GdeLeon
0	3/6/19	SIGNAL UPGRADE ACTIVATED THROUGH 2823J	DYeung	GdeLeon

REFERENCE INFORMATION & FILE NO. OF SURVEYS



SAN FRANCISCO MUNICIPAL TRANSPORTATION AGENCY

CITY AND COUNTY OF SAN FRANCISCO

DRAWN:	DATE:
DYeung	9/2021
CHECKED:	DATE:
GdeLeon	9/2021

SCALE:
AS SHOWN
SHEET OF SHEETS
1 OF 2

TRAFFIC SIGNAL INVENTORY DIAGRAM
JONES STREET AND POST STREET

CNN NO.
24965000
REV NO.
1

