



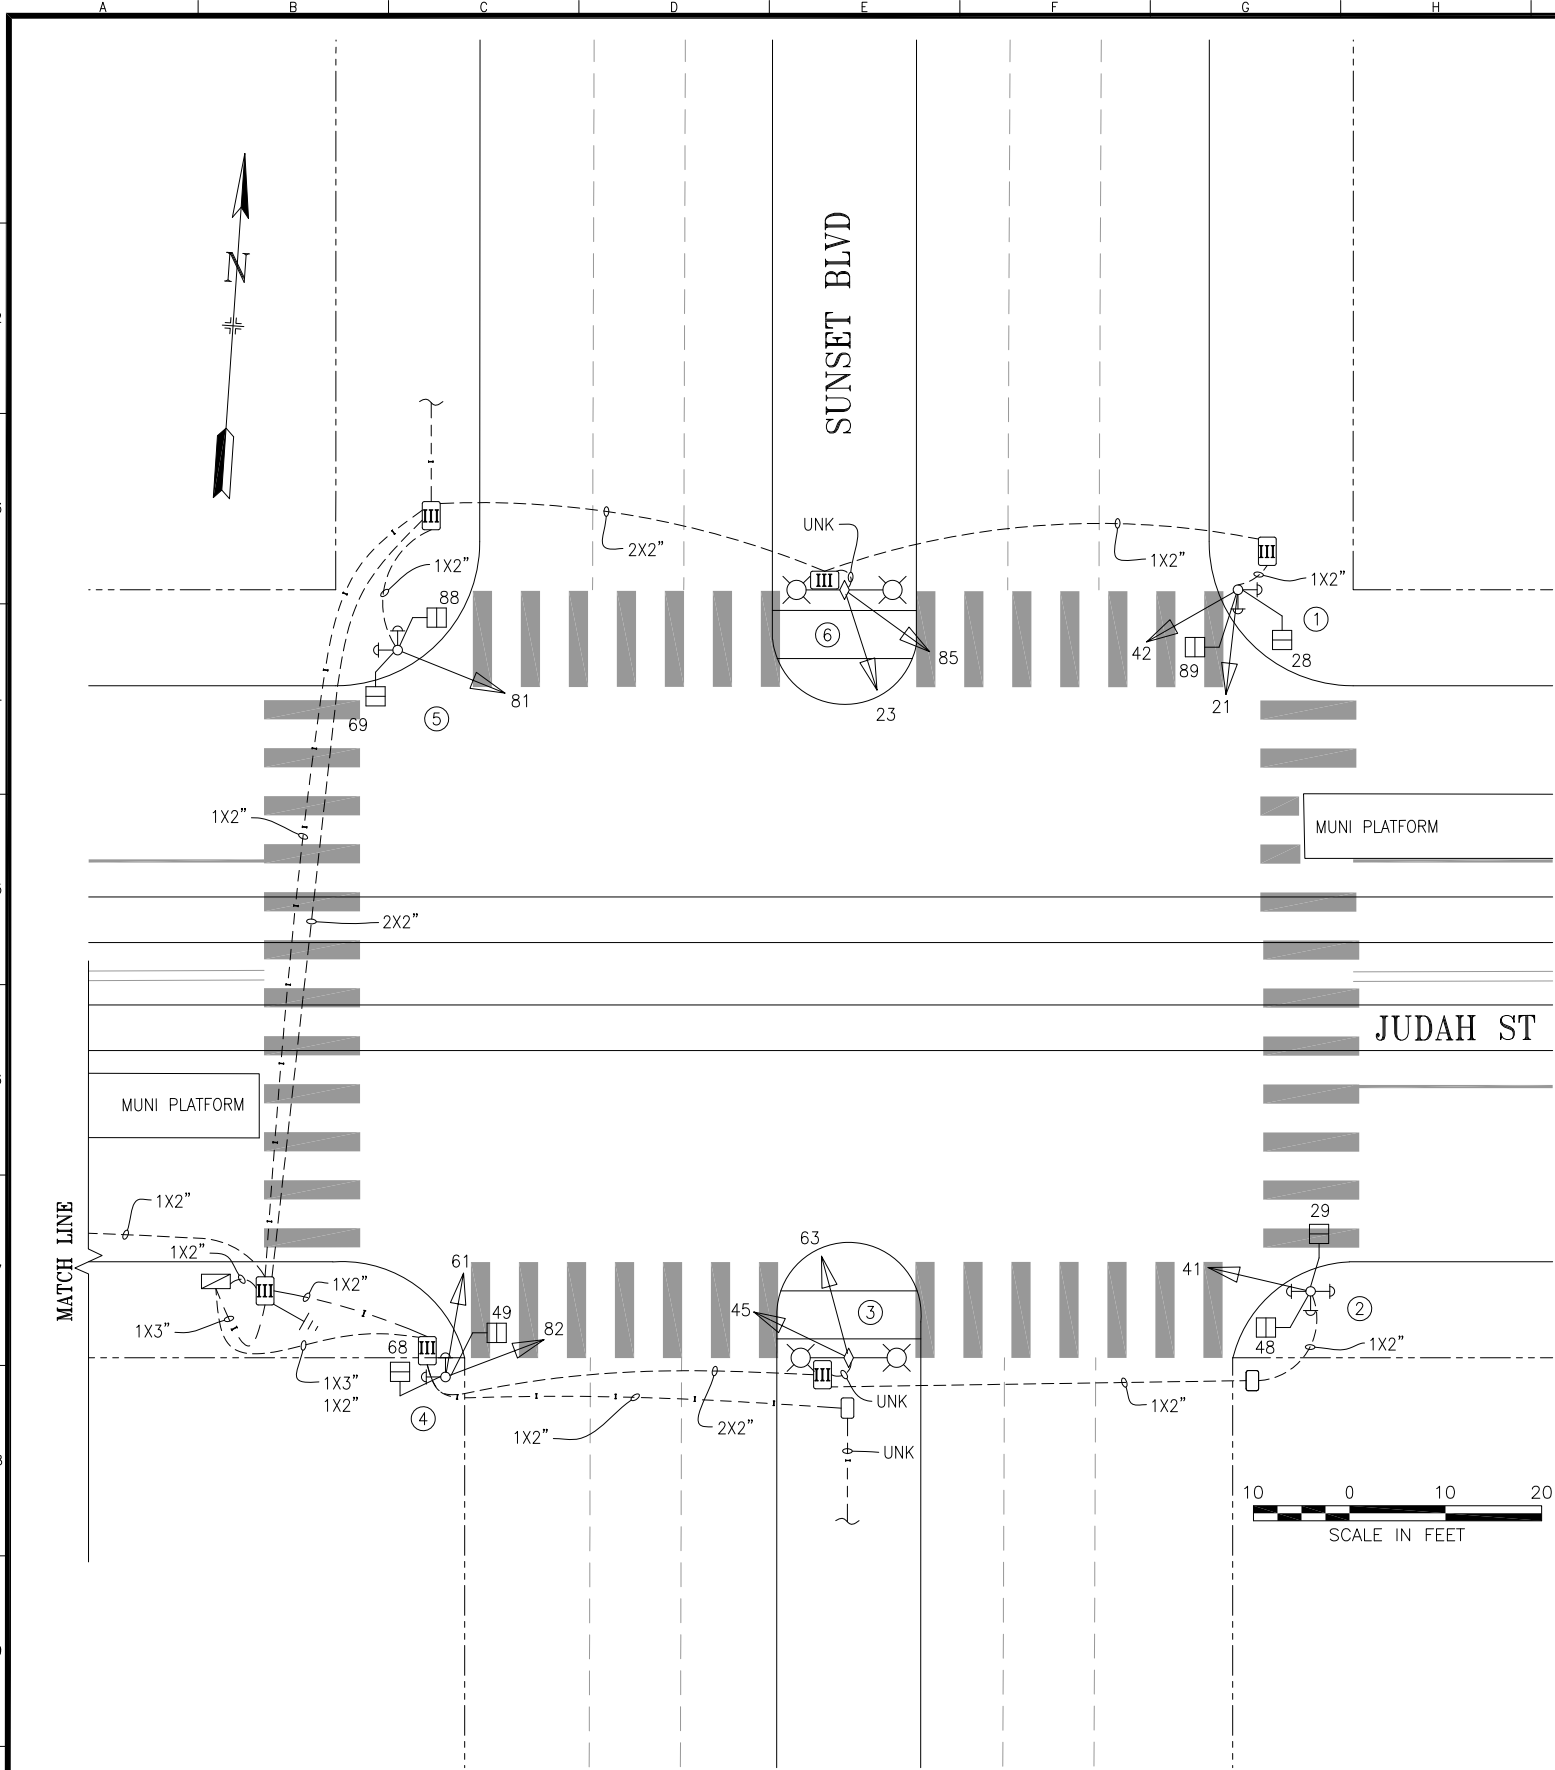

POLE AND EQUIPMENT SCHEDULE										
POLE No.	TYPE OF POLE	VEHICLE SIGNAL					PEDESTRIAN SIGNAL			REMARKS
		No.	TYPE	MOUNTING	VISORS	LOUVERS	No.	TYPE	MOUNTING	
①	PEDESTAL POLE (10')	21 42	3S12" 3S12"	TV-2-T-SFA	T T		28 89	1S-COUNT 1S-COUNT	SP-1 (22") SP-1-SF (12")	APS-3W X 2
②	MARBLELITE (10')	41	3S12"	TV-1-T	T		29 48	1S-COUNT 1S-COUNT	SP-1 SP-1	APS-3W X 3
③	MUNI WITH DUAL LUMINAIRE	45 63	3S12" 3S12"	SV-2-TC	T T					
④	MARBLELITE (10')	61 82	3S12" 3S12"	TV-2-T-SFA	T T		49 68	1S-COUNT 1S-COUNT	SP-1-SF (12") SP-1 (22")	APS-3W X 2
⑤	MARBLELITE (10')	81	3S12"	TV-1-T	T		69 88	1S-COUNT 1S-COUNT	SP-1 SP-1	APS-3W X 2
⑥	MUNI WITH DUAL LUMINAIRE	23 85	3S12" 3S12"	SV-2-TC	T T					

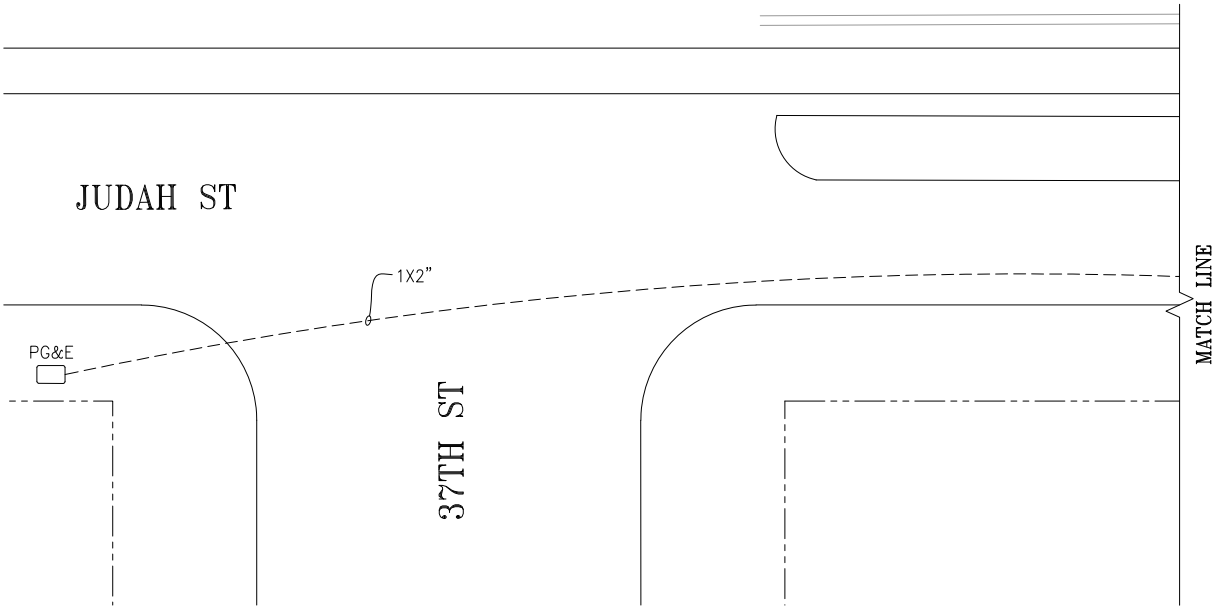

NO.	DATE	DESCRIPTION	BY	APPROVED
1	01/18/22	INSTALL APS UNITS (SRC 2021-054)	ELuu	GdeLeon
0	6/07/15	UPGRADE ALL SIGNALS TO 12". SIGNALS 22, 46, 62, AND 86 REMOVED	SShariati	MVelasco

TABLE OF REVISIONS
CHECKOUT DRAWING THROUGH THE SID CUSTODIAN FOR THE LATEST REVISION



SFMTA

DRAWN BY: ASCALES	DATE: 9/2015	SCALE AS SHOWN	TRAFFIC SIGNAL INVENTORY DIAGRAM	CNN NO: 27735000
CHECKED BY: MVELASCO	DATE: 9/2015	SHEET OF SHEETS 1 OF 1		SUNSET BOULEVARD AND JUDAH STREET

1