


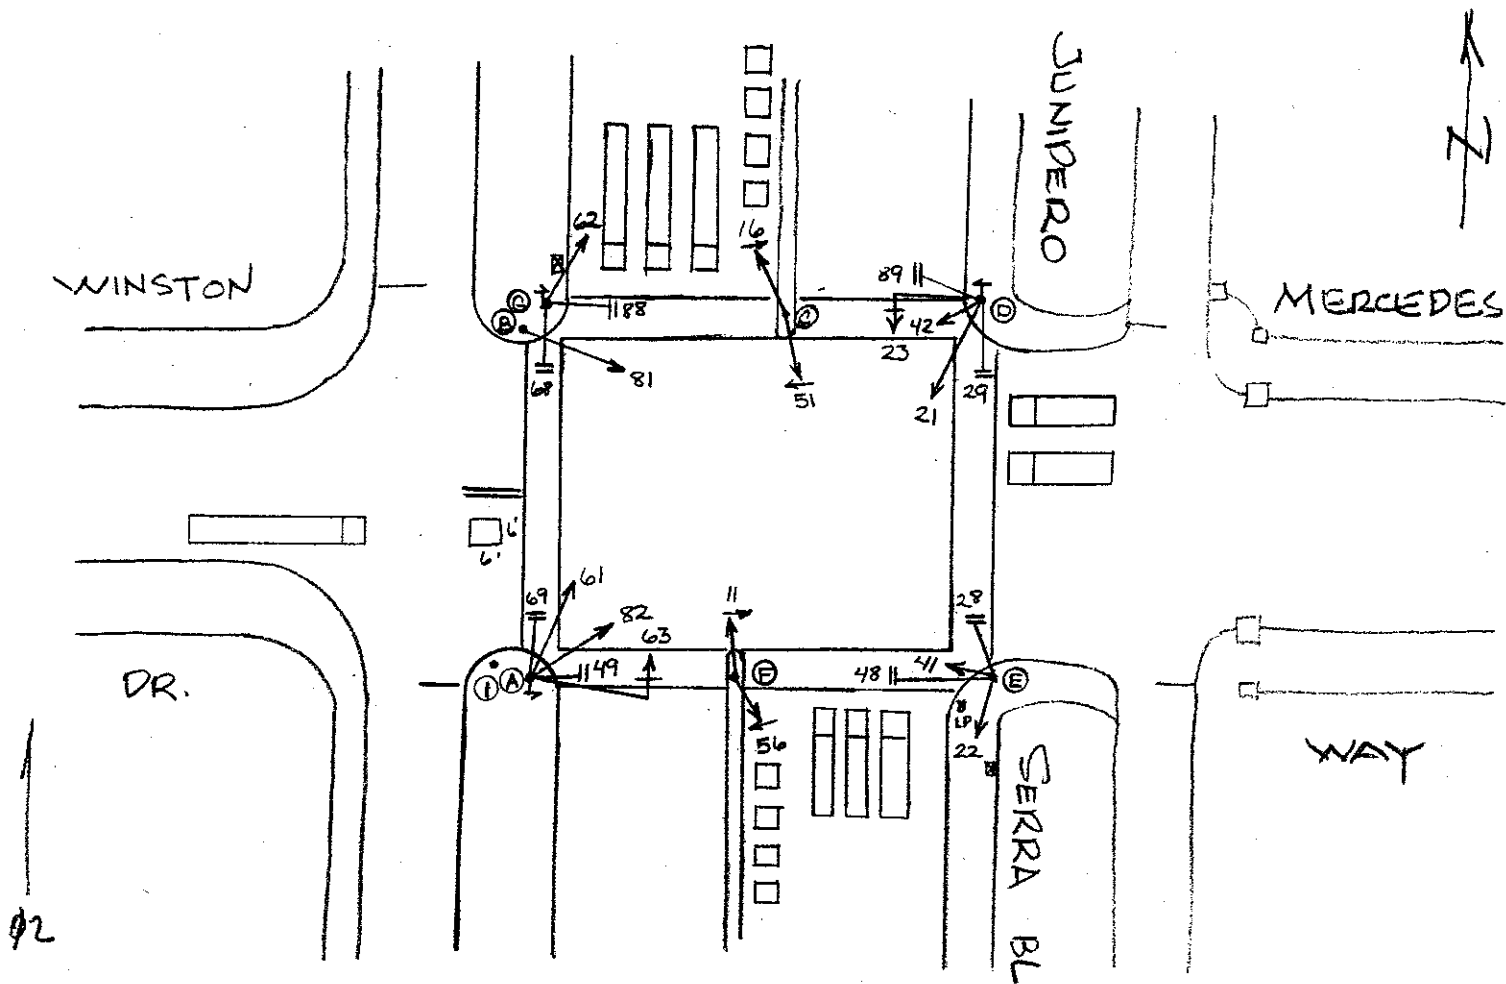

POLE	FUNC.	MAT'L	SIGNAL NO.	MAKE	NO. OF SECT.	SIZE	VISOR	B.P. or LOUVERS	MOUN'T	PED SIGNAL NO.	LEGEND	MESSAGE		MAKE	MOUN'T
												ELEMENT	COLOR		
A	S	S	11	TCT	3	12"	FC12"	-	S	28	I	15-1	W/OR	ICC	S
B	S	C	16	TCT	3	12"	FC12"	-	S	29	I	15-1	W/OR	ICC	S
C	L	C	21	TCT	3	12"	FC12"	-	T	48	I	15-1	W/OR	ICC	S
D	S	S	22	TCT	3	12"	FC12"	-	T	49	I	15-1	W/OR	ICC	S
E	S	C	23	TCT	3	12" ←	FC12"	BP	MAS	68	I	15-1	W/OR	ICC	S
F	L	C	41	TCT	3	12"	FC12"	-	T	69	I	15-1	W/OR	ICC	S
G	S	S	42	TCT	3	12"	FC12"	-	S	88	I	15-1	W/OR	ICC	S
			51	TCT	3	12"	FC12"	-	S	89	I	15-1	W/OR	ICC	S
L	L	C	56	TCT	3	12"	FC12"	-	S						
			61	TCT	3	12"	FC12"	-	S						
			62	TCT	3	12"	FC12"	-	T						
			63	TCT	3	12"	FC12"	BP	MAS						
			81	TCT	3	12"	FC12"	-	T						
			82	TCT	3	12"	FC12"	-	S						

CONTROLLER CABINET SIZE : LARGE BASE CABINET: —

COMMENTS: CONTRACT 21