


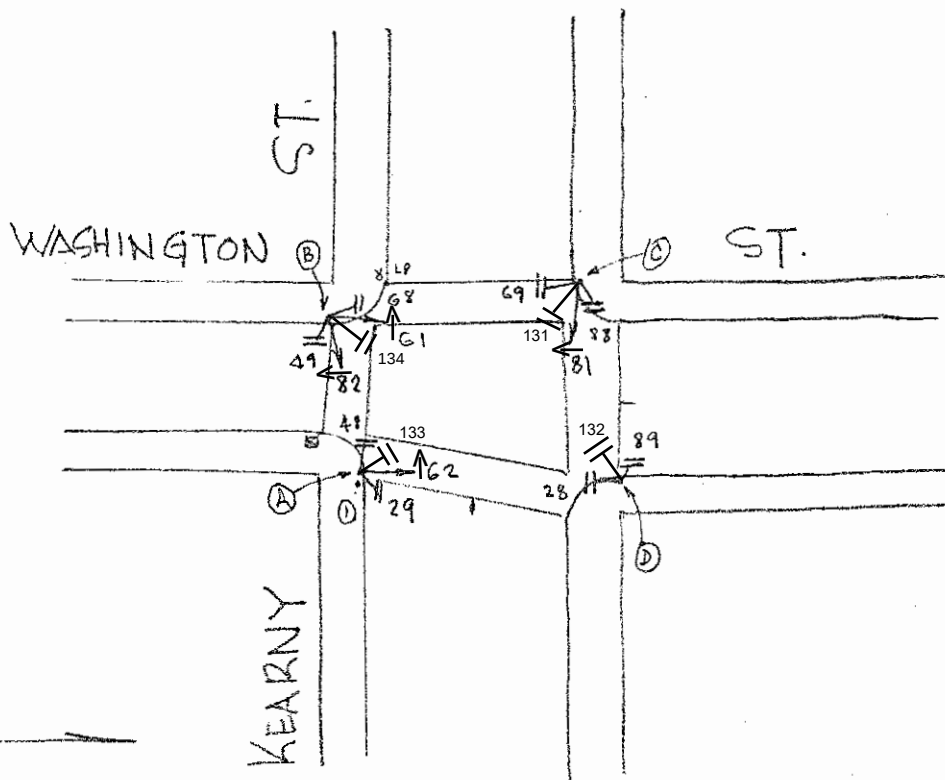

*See separate APS drawing for APS button details

5-4-2023

POLE	FUNC.	MAT'L	SIGNAL NO.	MAKE	NO. OF SECT.	SIZE	VISOR	B.P. OR LOUVERS	MOUNT	PED SIGNAL NO.	LEGEND	MESSAGE		MAKE	MOUNT
												ELEMENT	COLOR		
A	S	S	62	EC	4	12"	T 12"	NO	T	29	W/DW	GRD	W/O R	ED	SP-2-T-SF
B	L	S	82	EC	4	12"	T 12"	NO	S	48	W/DW	GRD	W/O R	ED	SP-1
C	L	S	61	EC	4	12"	T 12"	NO	S	49	W/DW	GRD	W/O R	ED	SP-1
D	L	S	81	EC	4	12"	T 12"	NO	S	68	W/DW	GRD	W/O R	ED	SP-2-T-SF
I	L	S								69	W/DW	GRD	W/O R	ED	SP-1
										88	W/DW	GRD	W/O R	ED	SP-2-T-SF
										89	W/DW	GRD	W/O R	ED	SP-1
										28	W/DW	GRD	W/O R	ED	SP-2-T-SF
										131	1S-C				SP-2-T-SF
										132	1S-C				SP-2-T-SF
										133	1S-C				SP-2-T-SF
										134	1S-C				SP-2-T-SF

CONTROLLER CABINET SIZE : ORDINARY BASE CABINET: YES

COMMENTS :

Per SRC 2022-199 install new 3-wire APS

5-4-23 D. Yeung