




POLE AND EQUIPMENT SCHEDULE

POLE No.	TYPE OF POLE	LUMINAIRE VOLTAGE/ WATTAGE	VEHICLE SIGNAL					PEDESTRIAN SIGNAL			REMARKS
			No.	TYPE	MOUNTING	VISORS	LOUVERS	No.	TYPE	MOUNTING	
1	1-A (12')		21	3S12"	TV-1-T	T		89	1S-COUNT	SP-1	
2	1-A (10')		41	3S12"	TV-1-T	T		48	1S-COUNT	SP-1	
3	SL	HPS 120V/200W	63	3S8"	SV-1	T					
4	MARBELITE		45 61	3S8" 3S8"	TV-2-T	T T		49 68	1S-COUNT 1S-COUNT	SP-1 SP-1	
5	1-A (12')		22	3S12"	TV-1-T	T		69 88	1S-COUNT 1S-COUNT	SP-1 SP-1	
6	SL	HPS 120V/200W	23 43	3S8" 3S8"	SV-2-TC	T T					EXTERNAL CONDUIT

2	9/14/23	PER CT-65 AND FIELD, UPDATE POLE 2 TO 1-A (10')	C. SKERRIT		G. DELEON
1	2/5/14	NEW XWALK ON EAST & PEDESTRIAN HEADS FOR NORTH XWALK	M. GROWNEY		D. VALLE-SCHWENK
NO.	DATE	DESCRIPTION	BY		APPROVED
TABLE OF REVISIONS					
CHECKOUT DRAWING THROUGH THE SID CUSTODIAN FOR THE LATEST REVISION					

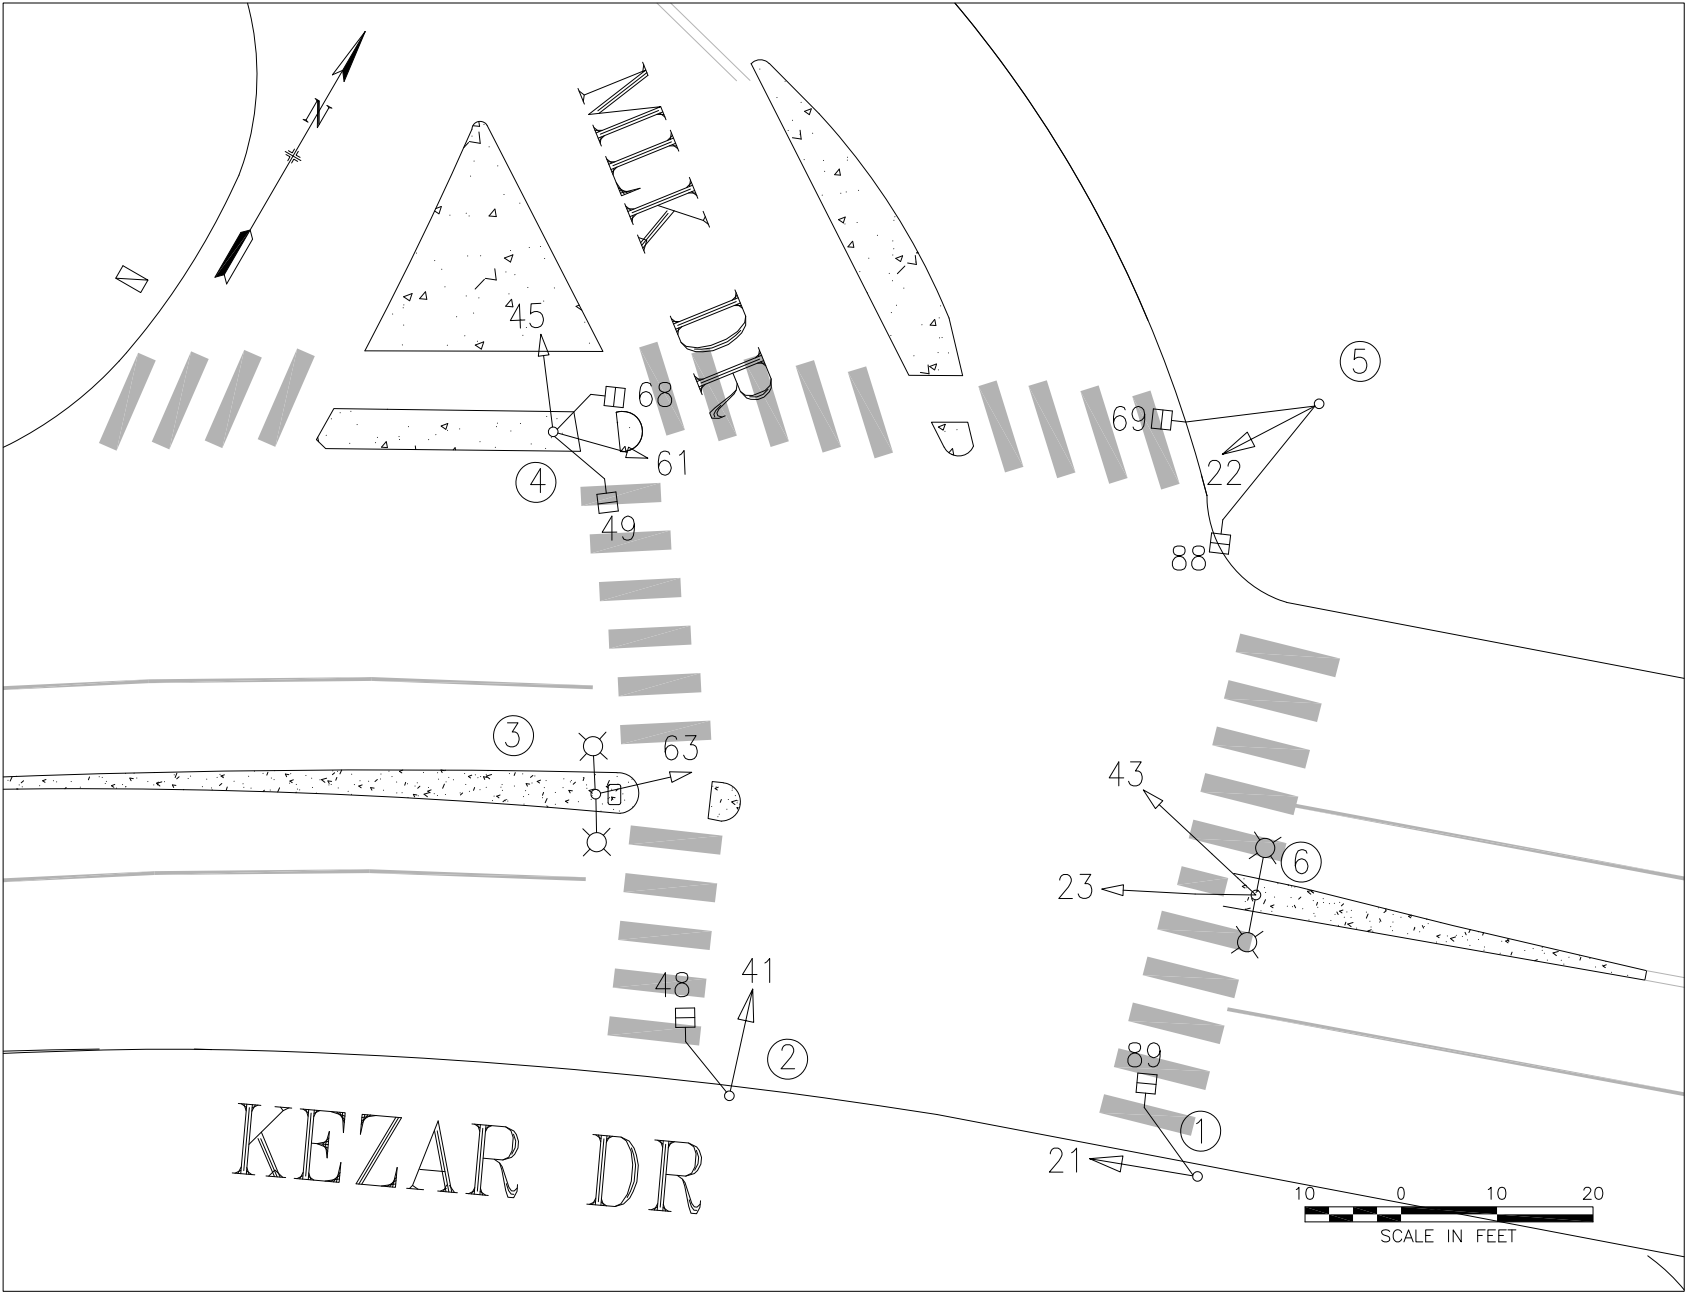

SFMTA

DRAWN BY: RDM	DATE: 06/13	SCALE 1"=20'	TRAFFIC SIGNAL INVENTORY DIAGRAM	CNN NO: 27183000
CHECKED BY: MG	DATE: 6/13	SHEET OF SHEETS 1 OF 1	MARTIN LUTHER KING JR DR & KEZAR DR	REV NO: 2