


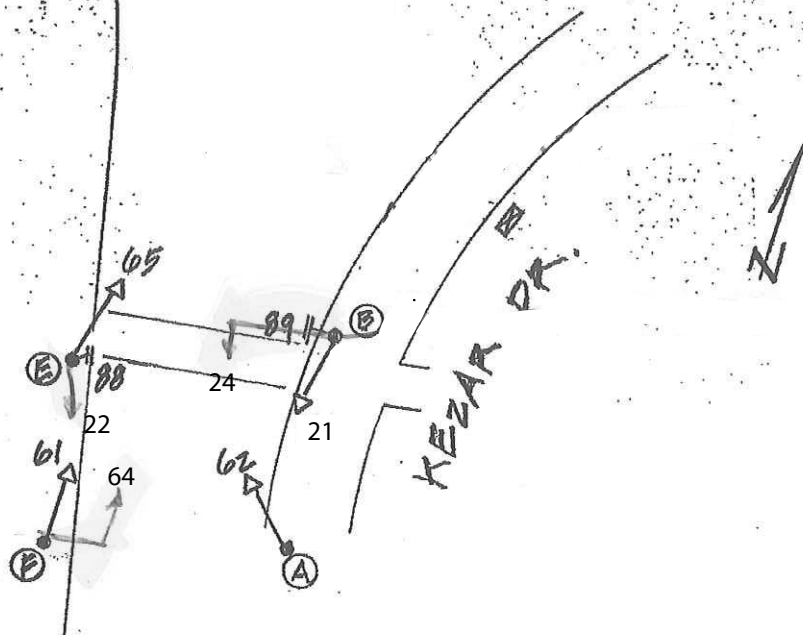

3-15-2021

[illegible]

COMMENTS :