

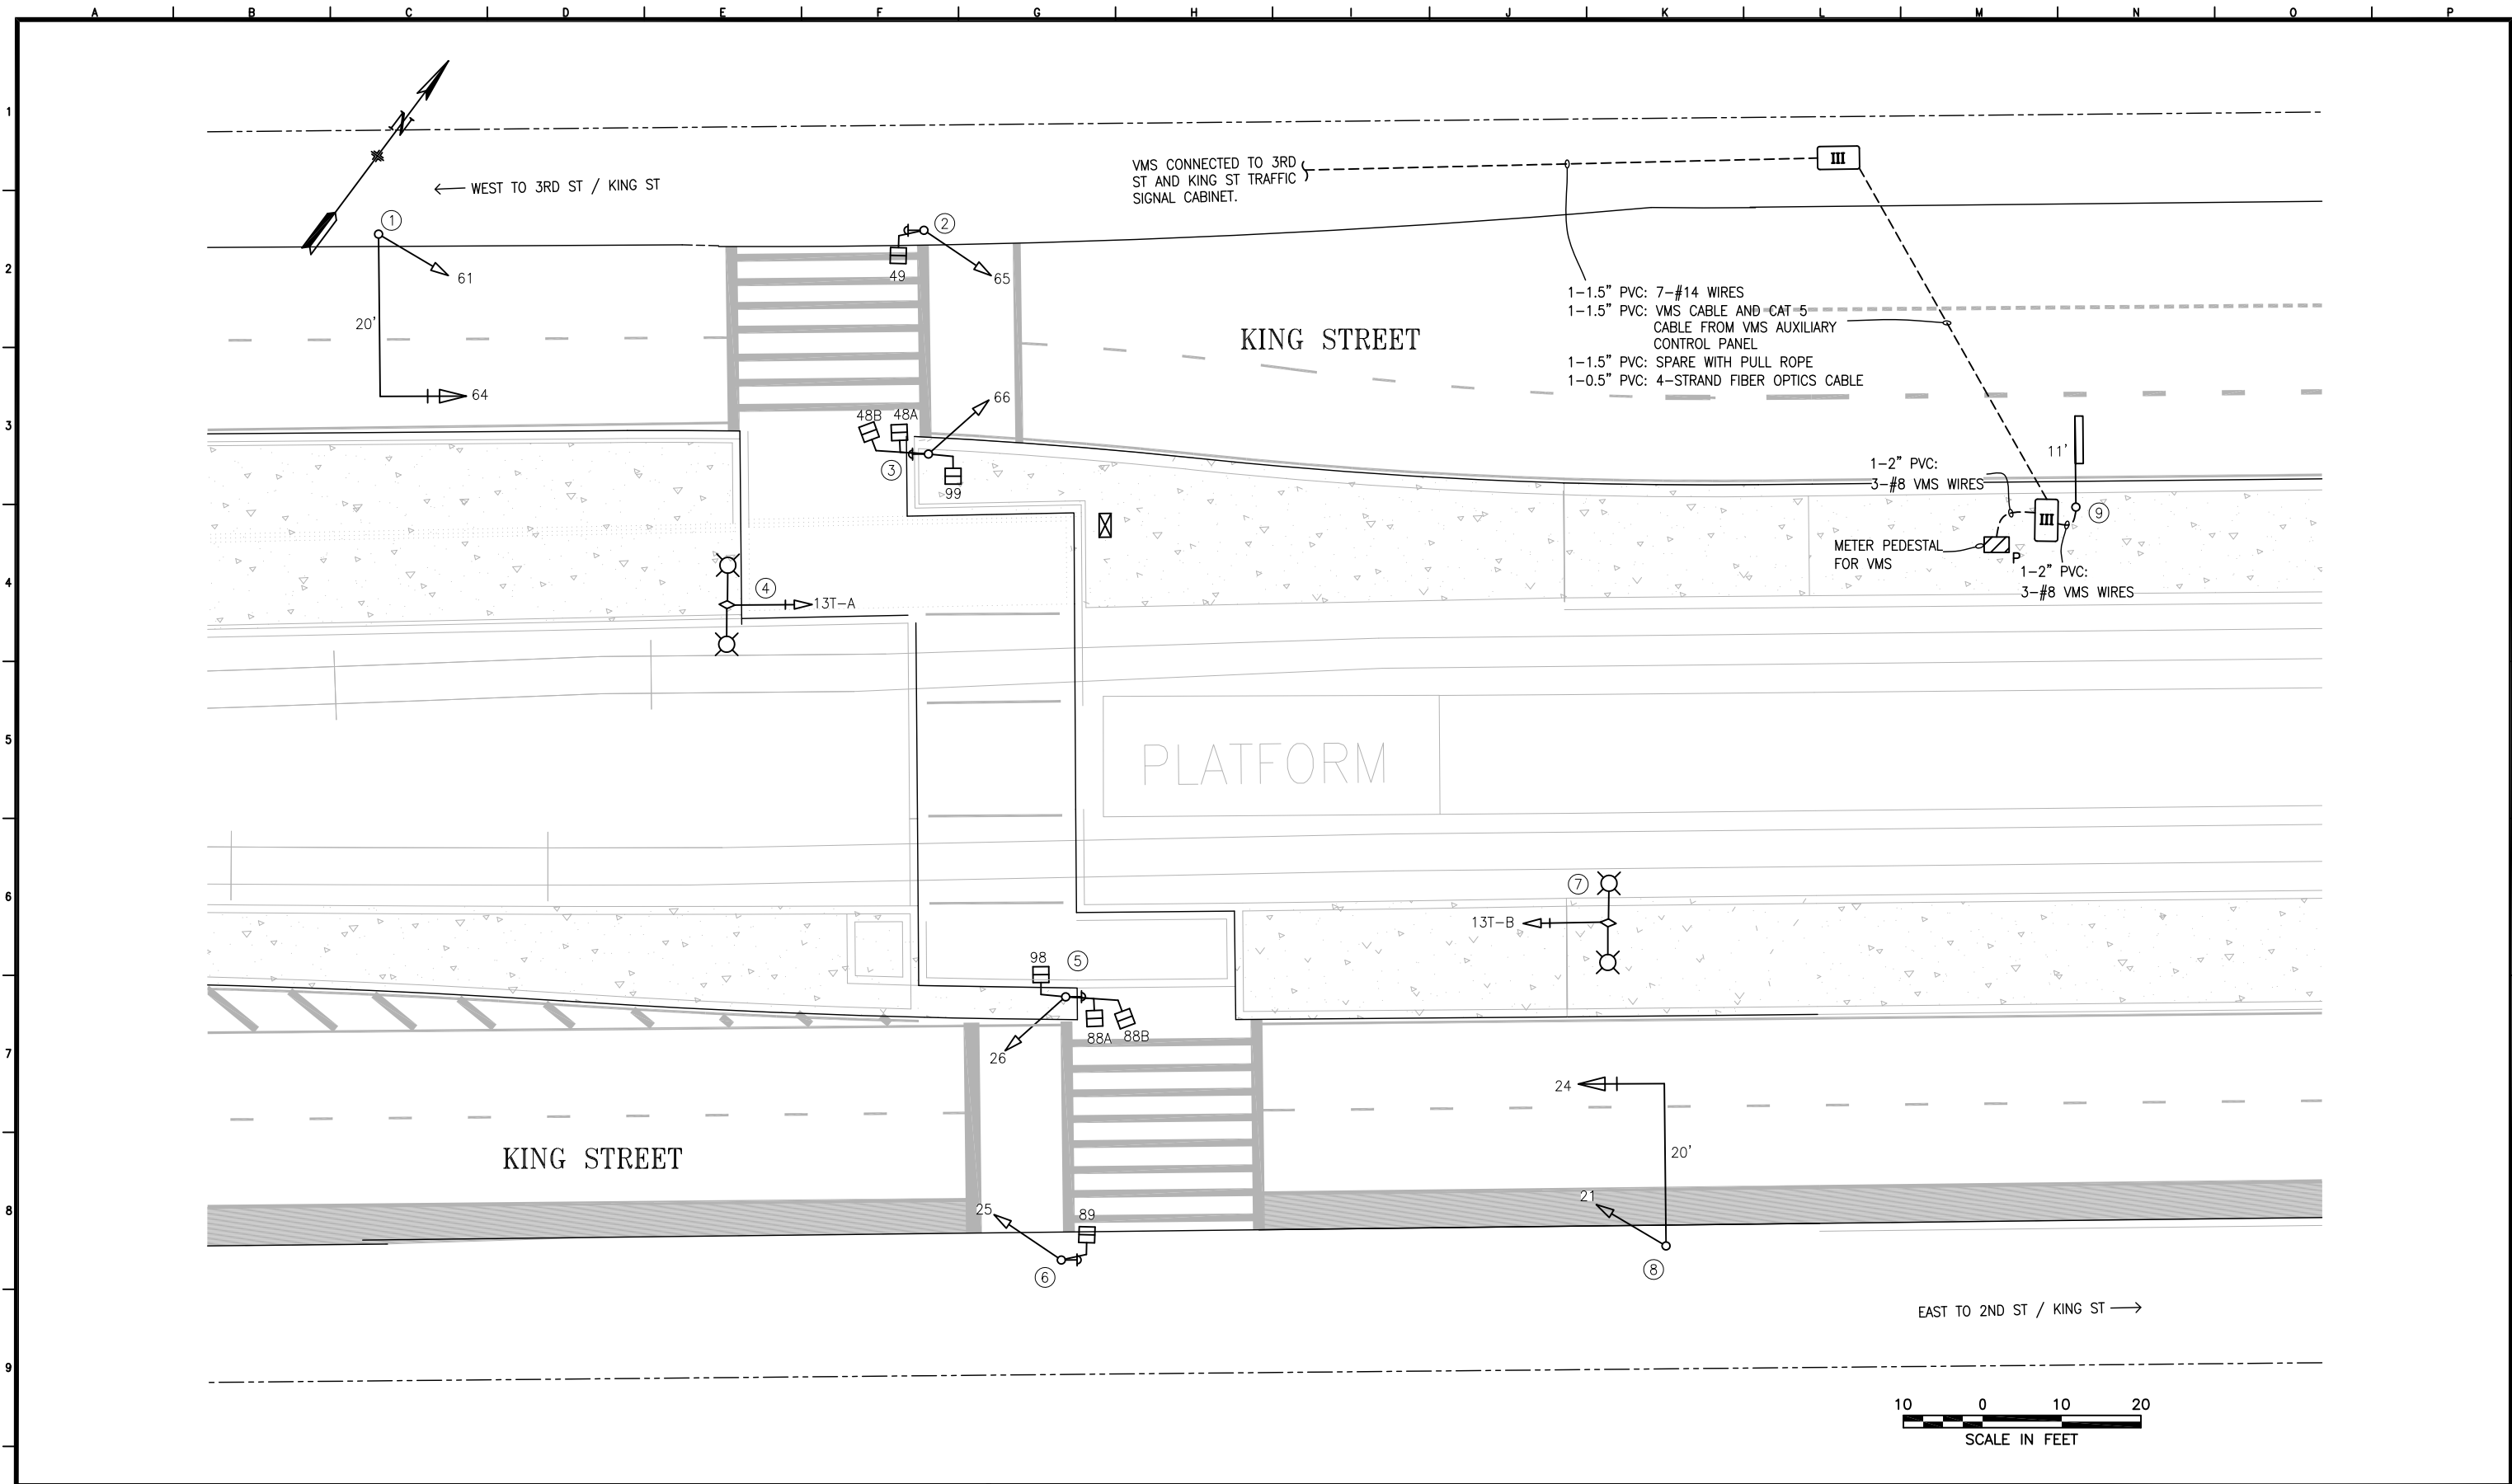


TABLE OF REVISIONS			CHECKOUT DRAWING THROUGH THE SID CUSTODIAN FOR THE LATEST REVISION	
NO.	DATE	DESCRIPTION	BY	APPROVED
0	01/xx/23	CONVERTED FROM MSID AND 3RD/KING ST VMS AS-BUILT; UPDATED PER FIELD	C. SKERRIT	G. DELEON



SFMTA

DRAWN BY:
C. SKERRIT

DATE:
07/26/2023

CHECKED BY:
G. DELEON

DATE:
07/31/2023

SCALE
AS SHOWN
SHEET OF SHEETS
01 of 02

TRAFFIC SIGNAL INVENTORY DIAGRAM

KING STREET MIDBLOCK BETW
02ND STREET & 03RD STREET

CNN NO:
7832201
REV NO:
0

