


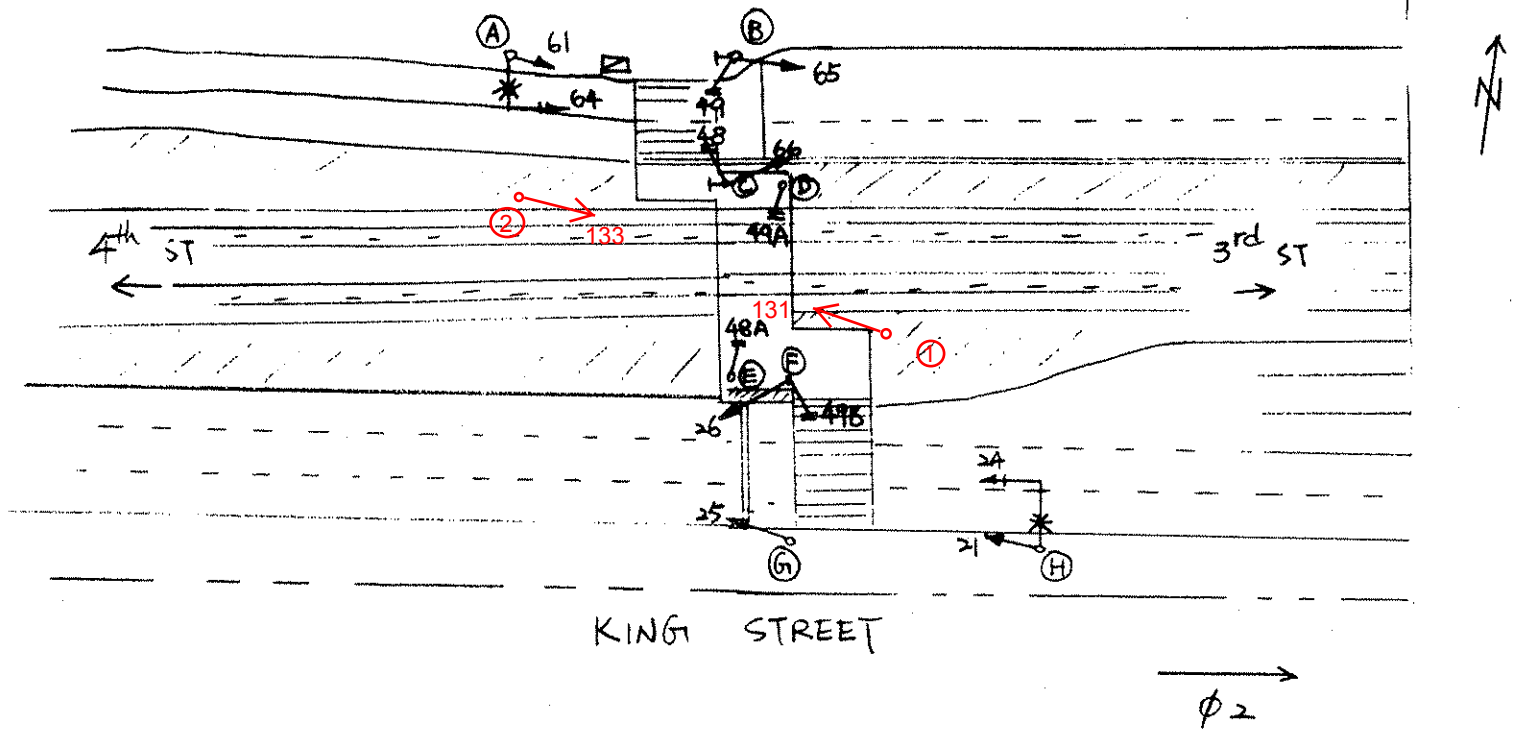

4/9/2017

[illegible]

CONTROLLER CABINET SIZE: 11 ON BASE SPRINT BASE CABINET: STANDARD (LMD-40 CONTROLLER

REMARKS: * - 2 PED SIGNALS

INSTALLED TRANSIT SIGNALS PER SRC 2017-069 - A. LAM