


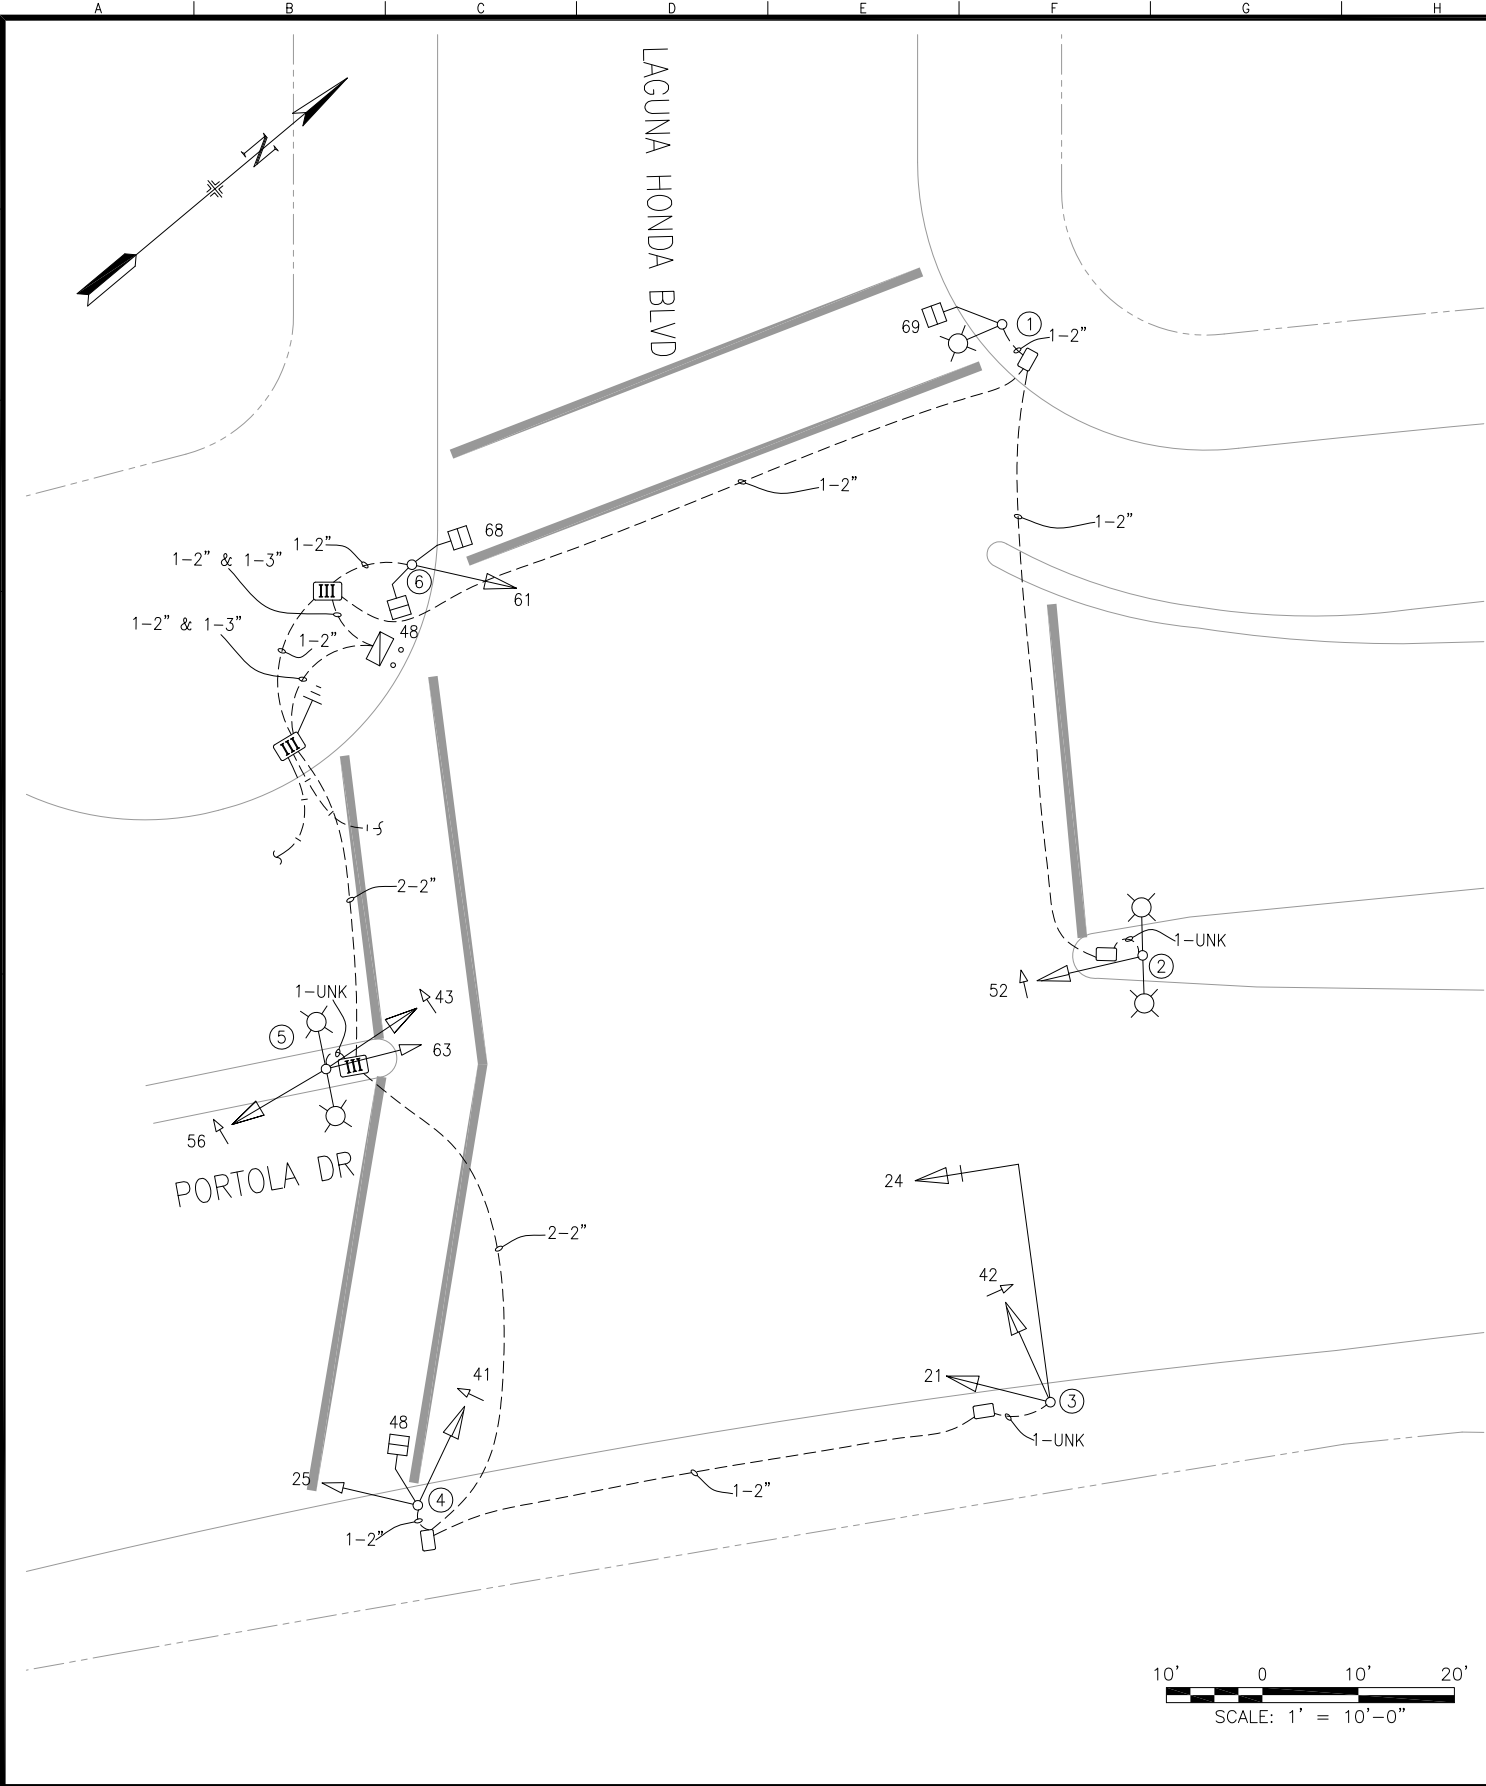

POLE AND EQUIPMENT SCHEDULE										
POLE No.	TYPE OF POLE	VEHICLE SIGNAL					PEDESTRIAN SIGNAL			REMARKS
		No.	TYPE	MOUNTING	VISORS	LOUVERS	No.	TYPE	MOUNTING	
①	STREET LIGHT						69	1S-COUNT	SP-1	
②	MARBELITE STREET LIGHT	52	3S12"LA	SV-1	FC					
③	MAST ARM	24 21 42	3S12" 3S12" 4S12"GLA	MAS SV-2-TC	T T T					BP
④	MARBELITE (10')	25 41	3S8" 5S12"GYRA	TV-2-T	FC FC		48	1S-COUNT	SP-1	
⑤	MARBELITE STREET LIGHT	56 63 43	3S12"LA 3S8" 5S12"GYRA	SV-1 SV-1 SV-1	T FC FC					
⑥	1 - A (10')	61	3S12"	TV-1-T	T		49 68	1S-COUNT 1S-COUNT	SP-1 SP-1	

NO.	DATE	DESCRIPTION	BY	APP.
2	3/22/17	REPLACE 42 WITH 4S12"GLA; UPGRADE 21 TO 12" PER SRC 2016-345	JH	ET
1	8/31/16	SIGNAL 22 REMOVED PER SRC 2016-204	JH	ET
0	1/25/07	SIGNAL UPGRADE BY 0872J; CONVERTED FROM CONTRACT PLANS	JH	ET

TABLE OF REVISIONS
CHECK WITH TRACING TO SEE IF YOU HAVE LATEST REVISION

REFERENCE INFORMATION
& FILE NO. OF SURVEYS



SAN FRANCISCO MUNICIPAL TRANSPORTATION AGENCY
CITY AND COUNTY OF SAN FRANCISCO

DRAWN: DATE:
JH 8/2016
CHECKED: DATE:
ET 8/2016

SCALE:

AS SHOWN

SHEET OF SHEETS
1 OF 1

TRAFFIC SIGNAL INVENTORY DIAGRAM

LAGUNA HONDA BLVD & PORTOLA DR

CNN NO.

22840000

REV NO.