

NEW TRAFFIC SIGNAL CABINET REPLACED ON
9/22/2020 AT 11:30 AM

SIGNAL SHOP ELECTRICIAN: MARCUS TODD
SSD ENGINEER: KEVIN SHUE

NO.	DATE	DESCRIPTION	BY	APP.
TABLE OF REVISIONS				
THIS DRAWING WAS LAST MODIFIED: 01/24/18 10:43, BY: dgorgoriano				

REFERENCE INFORMATION
& FILE NO. OF SURVEYS




DESIGN & ENGINEERING
PUBLIC WORKS
CITY & COUNTY OF SAN FRANCISCO
30 VAN NESS AVENUE, 5TH FLOOR
SAN FRANCISCO, CA 94102 - 6028


Section Mgr: PHILIP THWIN
Deputy Division Mgr: IQBALBHAI DHAPA
Division Mgr: PATRICK RIVERA

Date:

DESIGNED: DATE: 01/2018
KS/DG
DRAWN: DATE: 01/2018
KS/DG
CHECKED: DATE: 01/2018
MV/SL

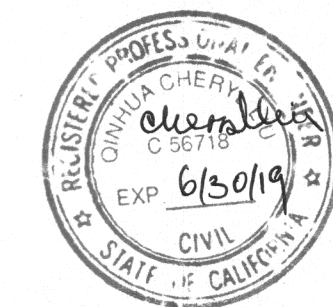

PLAN APPROVAL DATE	CONTRACT No.	PROJECT ID	DISTRICT	COUNTY	ROUTE	POST MILES TOTAL PROJECT
	04-4J7904	0416000004	04	SF	101	6.71/8.02

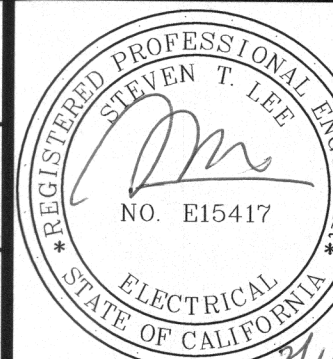

SCALE:
AS SHOWN
SHEET OF SHEETS
78 OF 164

LOMBARD STREET
VISION ZERO
LOMBARD STREET AND LAGUNA STREET
TRAFFIC SIGNAL WORK

CONTRACT NO.
2532J
DRAWING NO.
E-11.0
FILE NO.
111,105
REV. NO.

CONDUIT


- F/I 2-2" PVC AND 1-2" GRS CO. IN SAME TRENCH
- F/I 1-2" GRS CO.
- F/I 1-2" GRS (SEE SHEET NOTE 3)

SHEET NOTES


- CONTRACTOR TO ABANDON LOOP DETECTORS. CITY FORCES TO INSTALL WIRELESS SENSYS DETECTORS IN PLACE OF LOOP DETECTORS AS SHOWN.
- ADJUST POLE TO FINISHED GRADE AND COUPLE AND EXTEND ANCHOR BOLTS PER CALTRANS REVISED STANDARD PLAN RSP ES-7B DETAIL C.
- PROVIDE NEW WIRING TO MATCH EXISTING WIRING AND QUANTITY BACK TO CONTROLLER WITHOUT SPLICING. IF EXISTING WIRING HAS ENOUGH SLACK, CONTRACTOR HAS OPTION TO REUSE WITH SFMTA APPROVAL.
- RS MAST ARM POLE AND TRAFFIC SIGNAL EQUIPMENT. RC LUMINAIRE AND POLE FOUNDATION.
- EXISTING CONTROLLER CABINET TO REMAIN.
- CITY FORCES TO PROVIDE APS PUSH BUTTON PER ADA REQUIREMENTS USING SPARE WIRING.
- CITY FORCES TO INSTALL RECEIVER FOR WIRELESS SENSYS DETECTOR ON POLE. EXACT LOCATION TO BE DETERMINED.
- RS ALL STREET AND TRAFFIC SIGNS.
- CITY FORCES TO INSTALL STREET AND TRAFFIC SIGNS ON POLE.
- FOR FIXTURE TYPE, REFER TO FIXTURE SCHEDULE ON E-0.1.

POLE AND EQUIPMENT SCHEDULE

(EXISTING POLE AND EQUIPMENT
UNLESS OTHERWISE NOTED)

POLE	STANDARD			VEHICLE SIGNAL			PEDESTRIAN SIGNAL			APS	LUMINAIRE (WATTS)	SPECIAL REQUIREMENT
	TYPE	SMA	LMA	No.	TYPE	MOUNTING	No.	TYPE	MOUNTING			
A	17-2-80	—	12	81	3S12”	SV-1-T	88	1S-COUNT	SP-1-T	Ø6P	200(HPS)	BACKPLATE
B	1-A (10’)	—	—	22 65	3S12” 3S12”	TV-2-T	69	1S-COUNT	SP-1-T	Ø8P	—	BACKPLATE
C(N)	19A-2-100	25	12	21 24	3S12” 3S12”	SV-1-T MAS	28	1S-COUNT	SP-1	Ø8P		BACKPLATE
D	1-A (10’)	—	—	85 42	3S12” 3S12”	TV-2-T	89	1S-COUNT	SP-1-T	Ø2P	—	BACKPLATE
E	17-2-80	—	12	41	3S12”	SV-1-T	48	1S-COUNT	SP-1-T	Ø2P	200(HPS)	BACKPLATE
F	1-A (10’)	—	—	25 62	3S12” 3S12”	TV-2-T	29	1S-COUNT	SP-1-T	Ø4P	—	BACKPLATE
G	19A-2-80	25	12	61 64	3S12” 3S12”	SV-1-T MAS	68	1S-COUNT	SP-1-T	Ø4P	150(HPS)	BACKPLATE
H	1-A (10’)	—	—	45 82	3S12” 3S12”	TV-2-T	49	1S-COUNT	SP-1-T	Ø6P	—	BACKPLATE

PHASE DIAGRAM

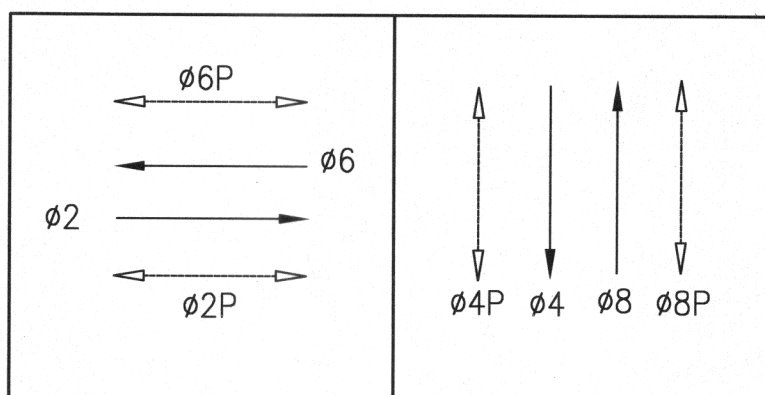

10 0 10 20
SCALE: 1"=10'-0"

Xrefs: SFMTA SID Title Block (2012).dwg
FLATTENED LOMBARD ST TOPO.dwg
V:\2532J_Lombard_ST_Improvements\2_Design\Working_Drawings\EEL\XREF\DE1_TBD.dwg
LogIn: dgorgoriano
Model Units: Feet
Drawing Path: V:\2532J_Lombard_ST_Improvements\2_Design\Working_Drawings\EEL\XREF\DE1_TBD.dwg
Plot Time: Tue, 30 Jan 2018 - 2:54pm