


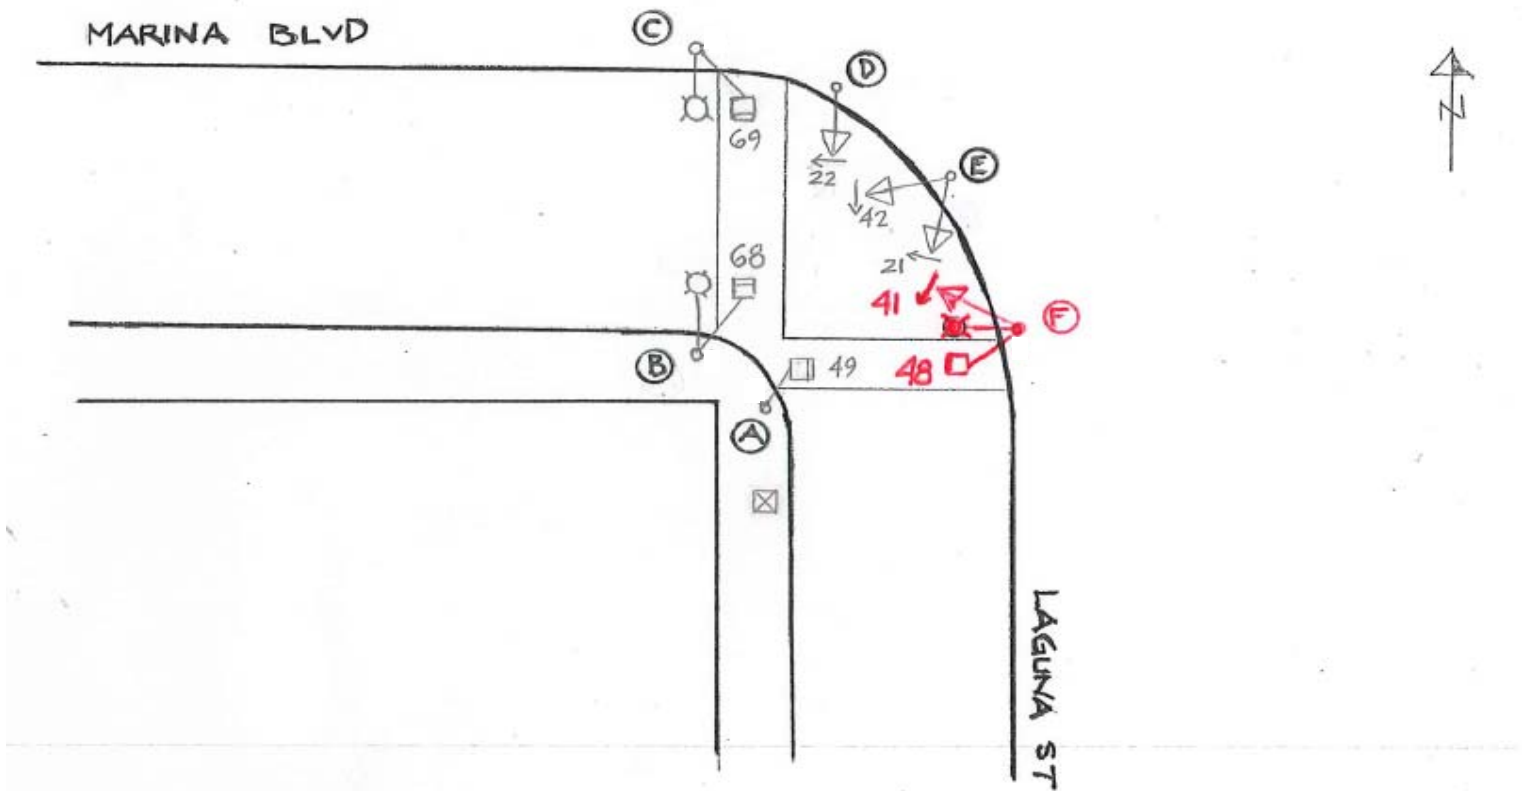

Pole	Function	Type	Mat'l	Signal No.	Sections	Size	Visor	BP or Louvers	Mount	Ped Signal	Legend	Message		Mount
												Element	Color	
A	S	1-A (7')	S	22	3	12" LA	Tunnel	No	TV-1-T	48	I	PCS	OR/W	SP-1
B	L	SL	C	42	3	12" RA	Tunnel	No	TV-2-T	49	I	PCS	OR/W	TP-1
C	L	SL	C	21	3	12" LA	Tunnel	No	TV-2-T	68	I	PCS	OR/W	SP-1
D	S	1-A (10')	S	41	3	12" RA	Tunnel	No	SV-1-T	69	I	PCS	OR/W	SP-1
E	S	1-A (10')	S											
F	L	SL	C											

Controller Cabinet Standard
Base Cabinet Yes

Comments
PER SRC 2021-047 REMOVED ALL PPBs (J.TOM 3/15/2021)