


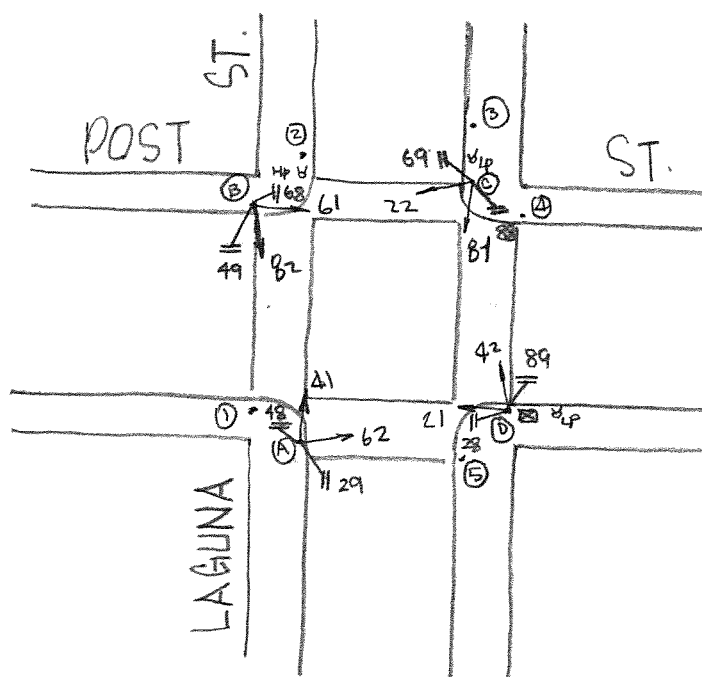

$\phi 2$ —————

5-26-16

[illegible]

CONTROLLER CABINET SIZE : ORDINARY BASE CABINET: YES

COMMENTS :

ADDED PCS in SRC # 16-023
- D. CHAIN