


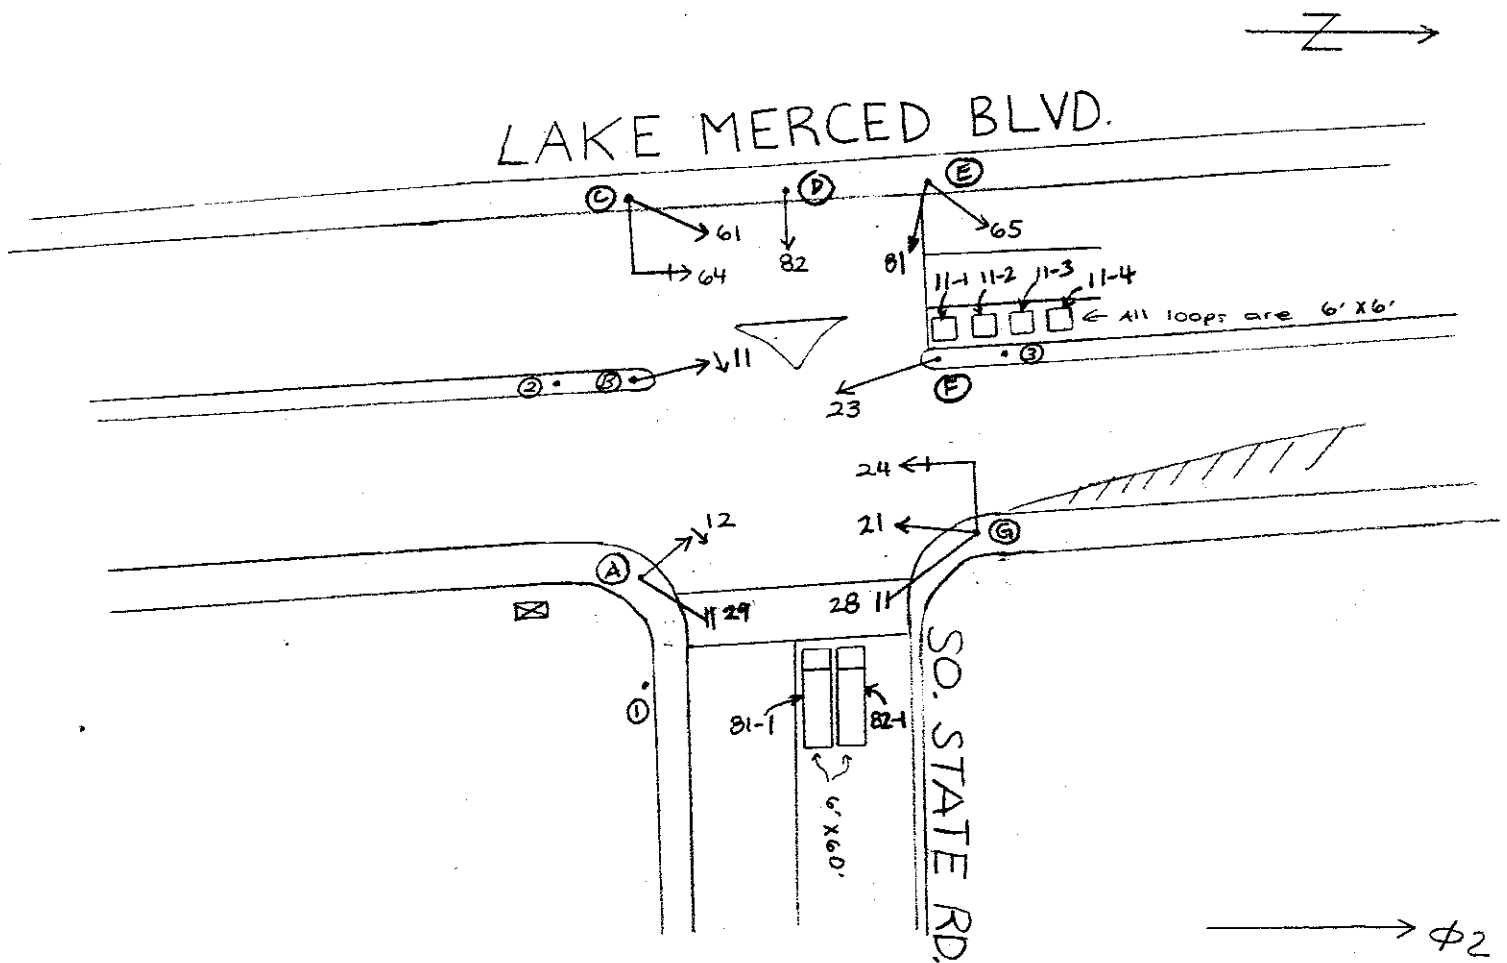


Per field check 8-3-99

POLE	FUNC.	MAT'L	SIGNAL NO.	MAKE	NO. OF SECT.	SIZE	VISOR	B.P. OR LOUVERS	MOUNT	PED SIGNAL NO.	LEGEND	MESSAGE		MAKE	MOUNT
												ELEMENT	COLOR		
A	S	S	12	CH	3	12" $\leftarrow R \leftarrow Y \leftarrow G$	T 12"	NO	T	29	I	1S-I	WH/OR	ICC	S
B	S	S	11	CH	3	12" $\leftarrow R \leftarrow Y \leftarrow G$	T 12"	NO	T	28	I	1S-I	WH/OR	ICC	S
C	S	S	64	ICC	3	12"	FC 12"	BP	A						
D	S	S	61	TCT	3	8"	T 8"	NO	S						
E	S	S	82	CH	3	8"	T 8"	NO	T						
F	S	S	81	CH	3	8"	T 8"	NO	T						
G	S	S	65	CH	3	8"	T 8"	NO	T						
			23	CH	3	12"	T 12"	NO	T						
			24	CH	3	12"	T 12"	BP	A						
1	L	S	21	CH	3	8"	T 8"	NO	S						
2	L	C													
3	L	C													

CONTROLLER CABINET SIZE : ORDINARY BASE CABINET: YES

COMMENTS : Contract 49 , fixed loops & added ped heads.

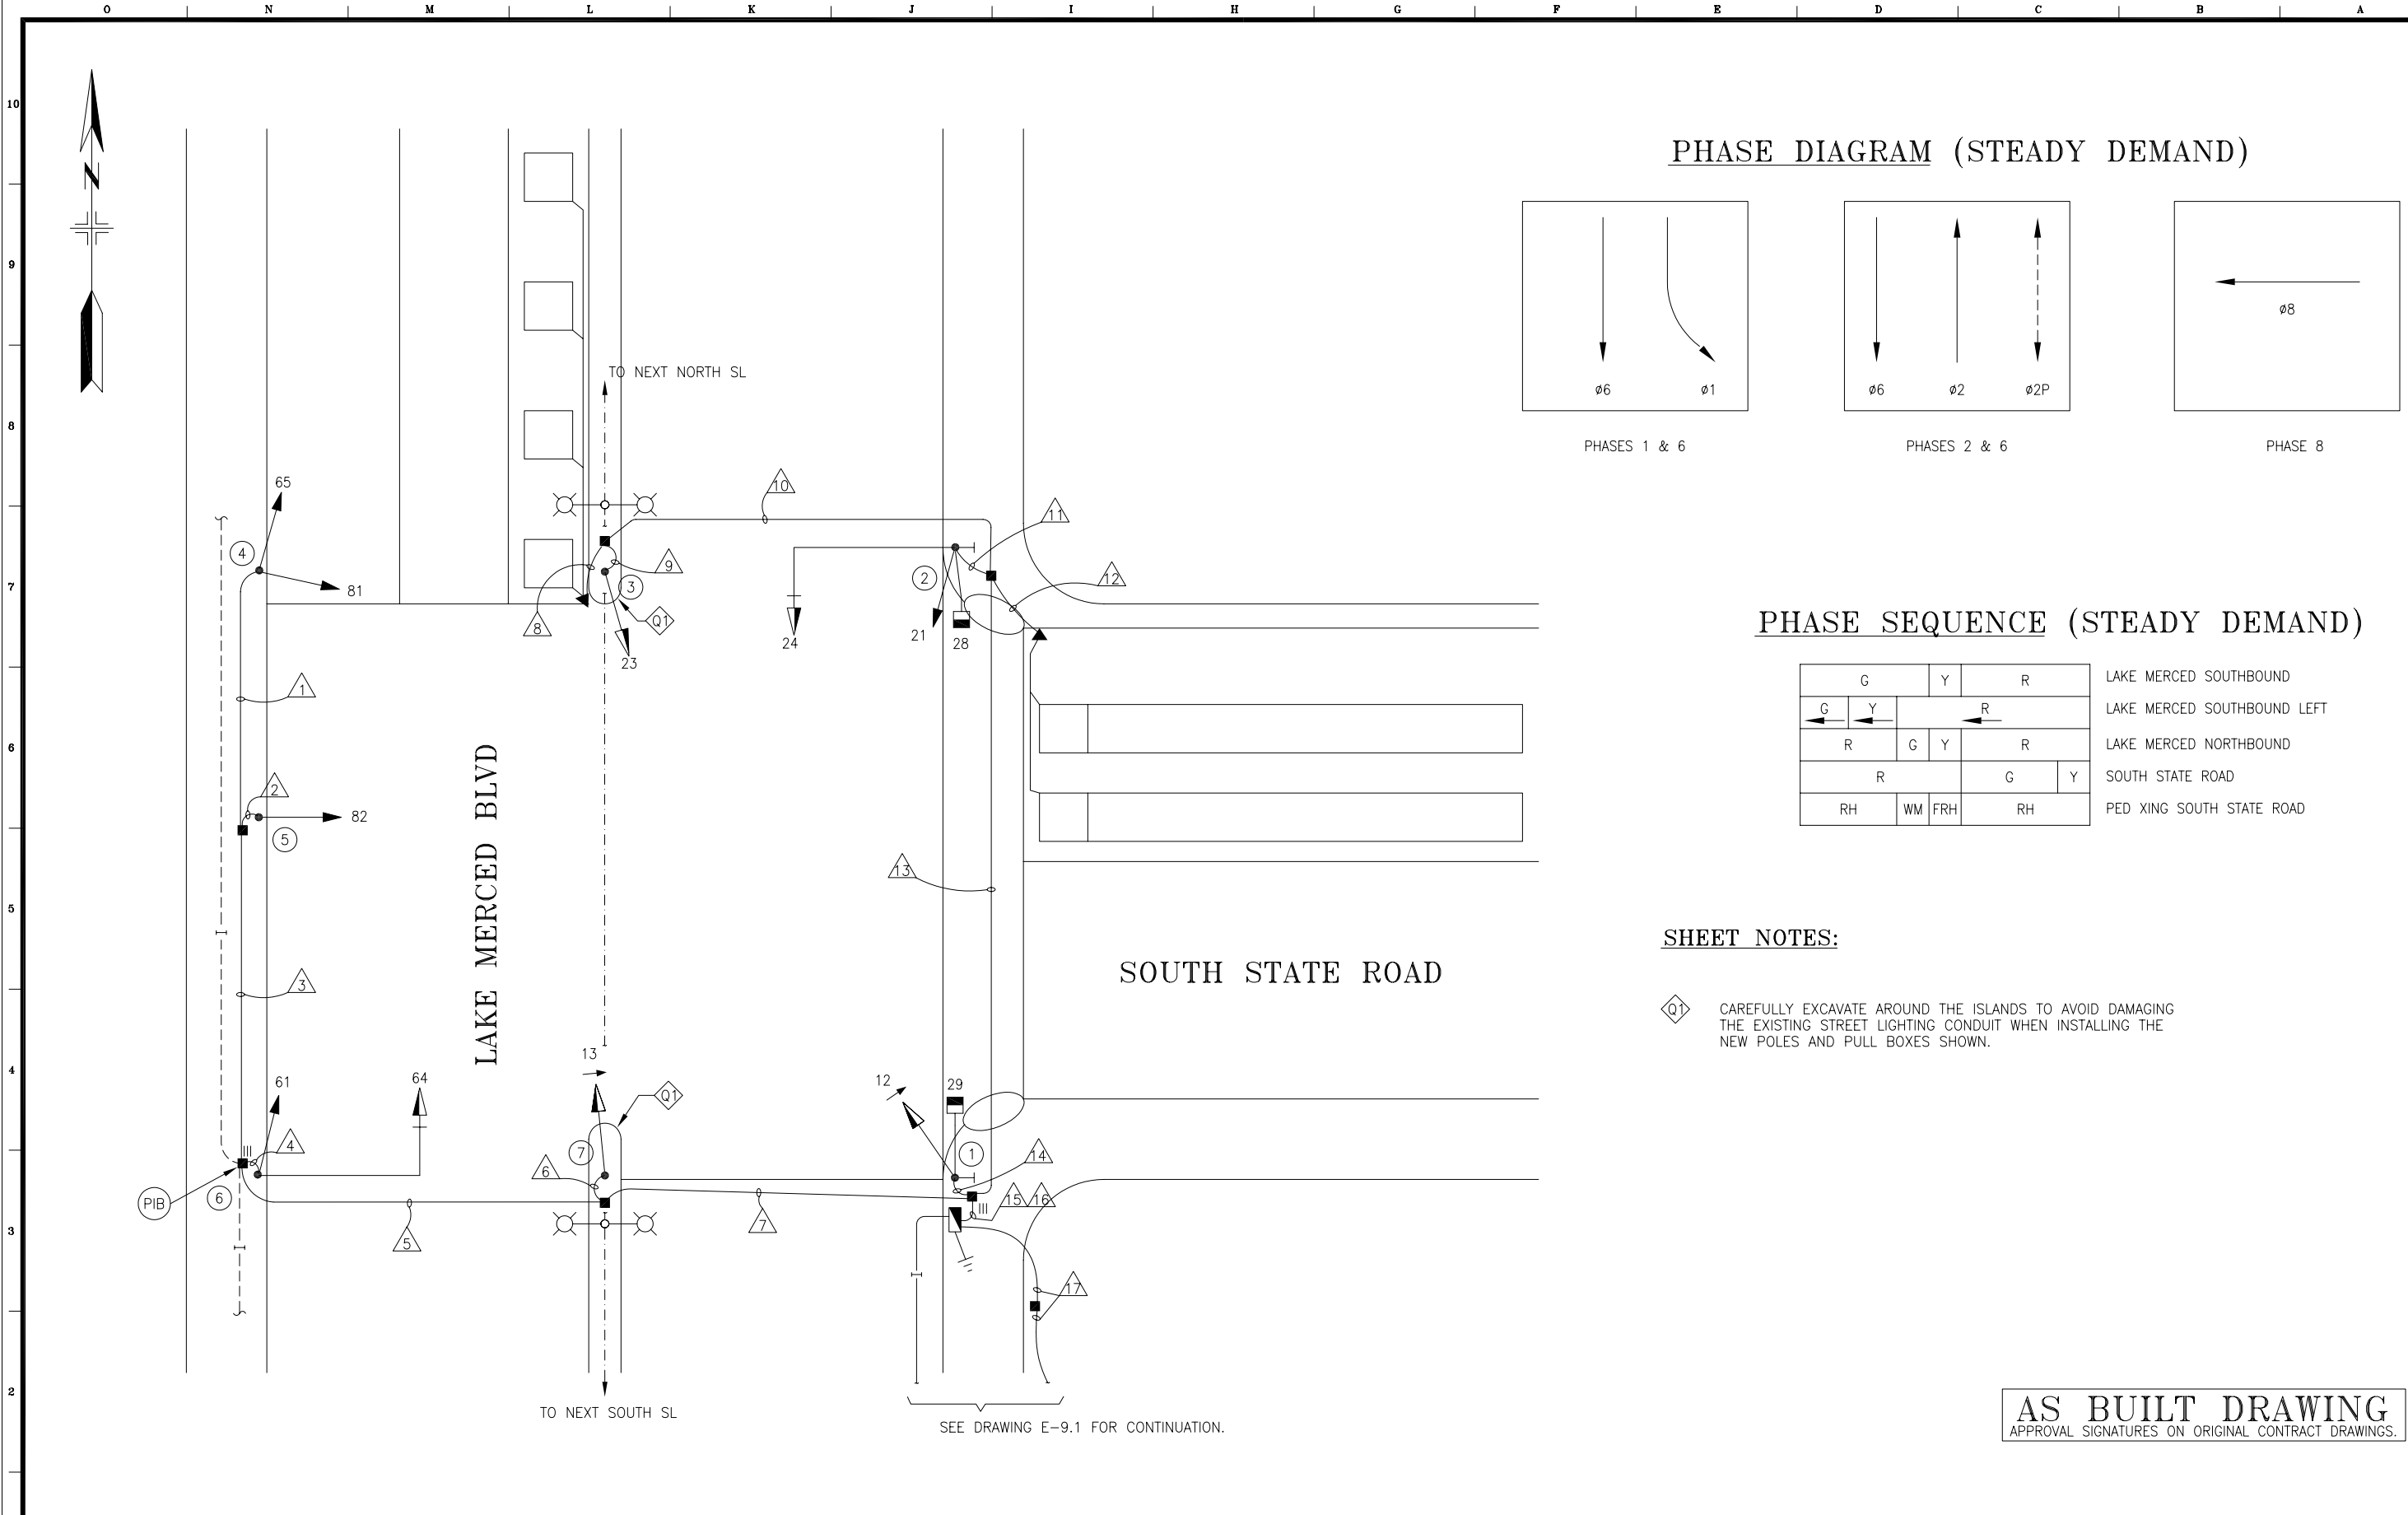

1				REFERENCE INFORMATION & FILE No. OF SURVEYS			BUREAU OF ENGINEERING DEPARTMENT OF PUBLIC WORKS CITY AND COUNTY OF SAN FRANCISCO	DESIGNED: DVS/SB	DATE: 4/98	APPROVED		SCALE: 1"=10'-0"	VARIOUS LOCATIONS TRAFFIC SIGNAL WORK CONTRACT 49	SPECIFICATION NO. 1428N	
								DRAWN: RT/SB	DATE: 4/98	SECTION MANAGER		DATE:		SHEET OF SHEETS	FILE NO. 69,370
								CHECKED: CF	DATE: 4/98	DIVISION MANAGER		DATE:		10 OF 18	REV. NO. 0
TABLE OF REVISIONS CHECK WITH TRACING TO SEE IF YOU HAVE LATEST REVISION										CITY ENGINEER		DATE:			

T:\E-FILES\Official_Records\Signal_Inventory\As_Built\Signal_Inventory\1428N\1428N-E09.DWG, Model: 9/25/2007 4:08:59 PM, CLEUNG2

