


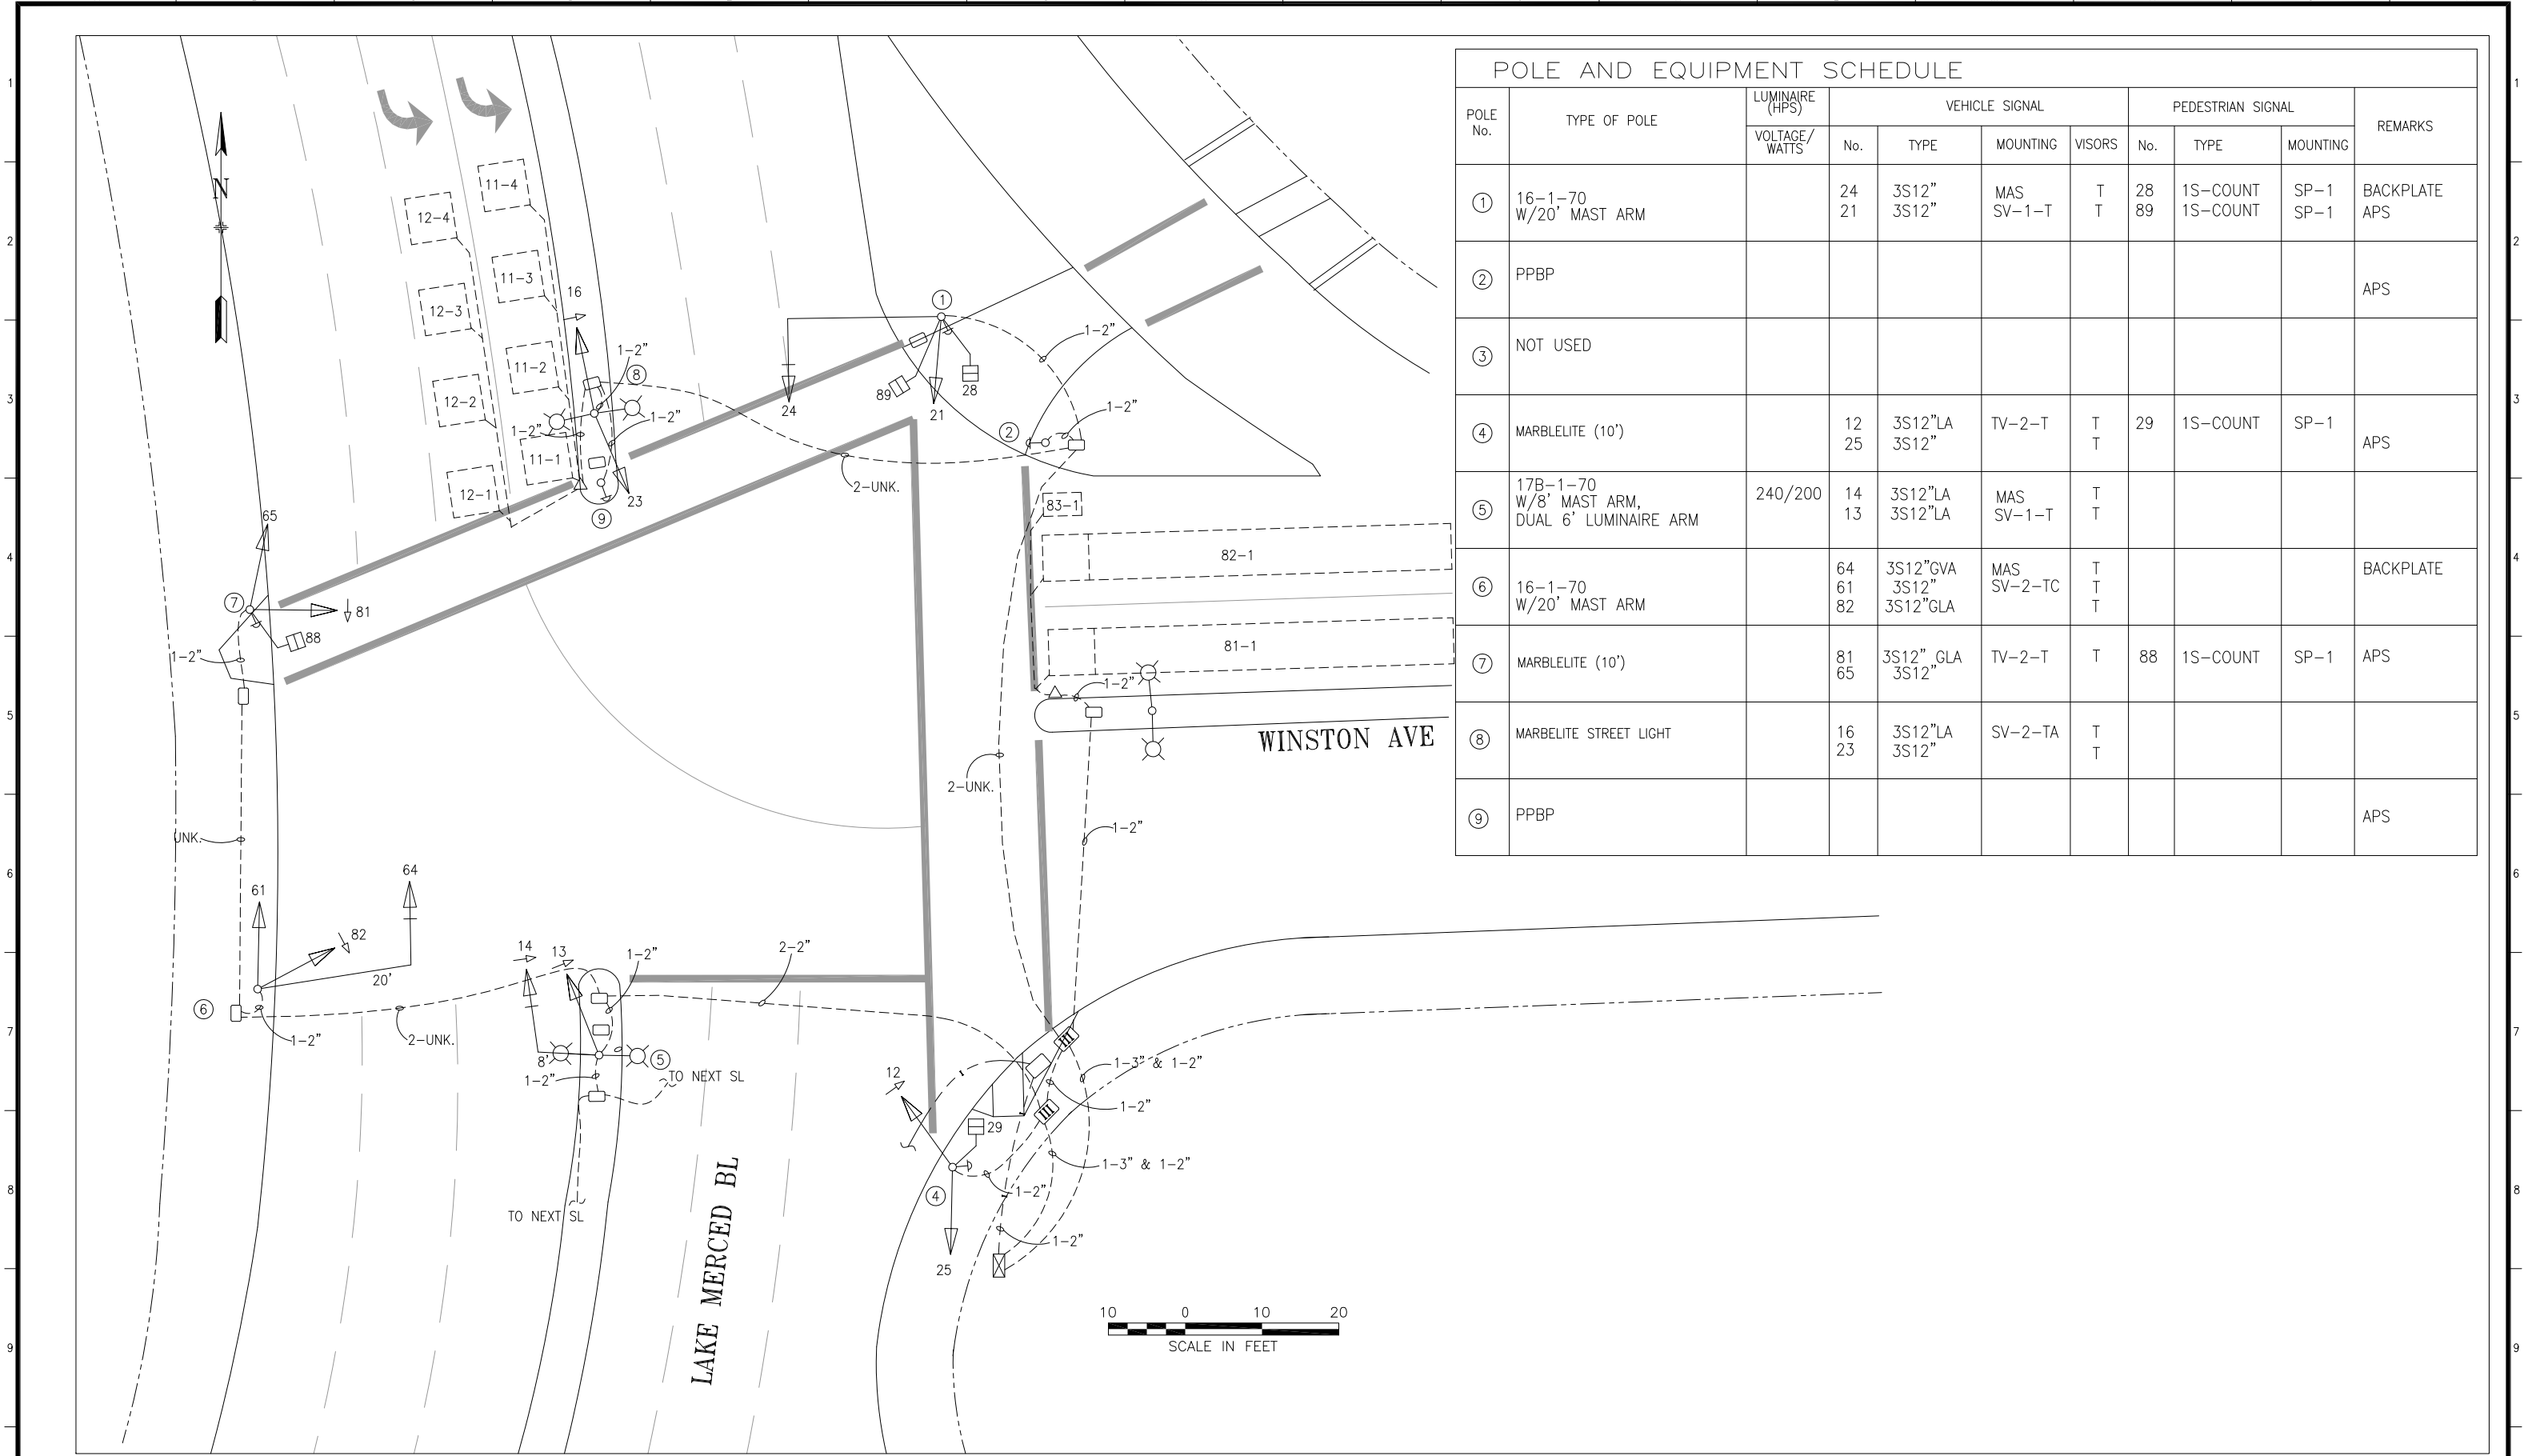

POLE AND EQUIPMENT SCHEDULE										
POLE No.	TYPE OF POLE	LUMINAIRE (HPS)	VEHICLE SIGNAL				PEDESTRIAN SIGNAL			REMARKS
		VOLTAGE/ WATTS	No.	TYPE	MOUNTING	VISORS	No.	TYPE	MOUNTING	
①	16-1-70 W/20' MAST ARM		24 21	3S12" 3S12"	MAS SV-1-T	T T	28 89	1S-COUNT 1S-COUNT	SP-1 SP-1	BACKPLATE APS
②	PPBP									APS
③	NOT USED									
④	MARBLELITE (10')		12 25	3S12"LA 3S12"	TV-2-T	T T	29	1S-COUNT	SP-1	APS
⑤	17B-1-70 W/8' MAST ARM, DUAL 6' LUMINAIRE ARM	240/200	14 13	3S12"LA 3S12"LA	MAS SV-1-T	T T				
⑥	16-1-70 W/20' MAST ARM		64 61 82	3S12"GVA 3S12" 3S12"GVA	MAS SV-2-TC	T T T				BACKPLATE
⑦	MARBLELITE (10')		81 65	3S12" GLA 3S12"	TV-2-T	T	88	1S-COUNT	SP-1	APS
⑧	MARBLELITE STREET LIGHT		16 23	3S12"LA 3S12"	SV-2-TA	T T				
⑨	PPBP									APS

5	7/26/18	REMOVE UNUSED POLE #3	DY	GD
4	7/23/18	ADD APS TO POLES 1,2,4,7 & 9 PER SRC 2018-145	DY	GD
3	11/5/15	SIGNAL 63 BECOMES 14 3S12"LA PER SRC 2015-343	ET	MV
2	4/27/12	REMOVE PPB CROSSING WINSTON, PER SRC 2011-286	DY	MV
1	6/21/06	63 AND 64 BECOMES GVA PER SRC 2006-089	ET	BBD
0	2/9/2005	UPGRADE ACTIVATED THRU 04356 CONVERTED FROM AS-BUILTS	JH	ET
NO.	DATE	DESCRIPTION	BY	APP.
TABLE OF REVISIONS				
CHECK WITH TRACING TO SEE IF YOU HAVE LATEST REVISION				

REFERENCE INFORMATION & FILE NO. OF SURVEYS



SAN FRANCISCO MUNICIPAL TRANSPORTATION AGENCY
CITY AND COUNTY OF SAN FRANCISCO

DRAWN:	DATE:
JH	09/2015
CHECKED:	DATE:
ET	09/2015

SCALE:
AS SHOWN
SHEET OF SHEETS
1 OF 1

TRAFFIC SIGNAL INVENTORY DIAGRAM
LAKE MERCED BLVD AND WINSTON AVE

CNN NO.
33512000
REV NO.
5