


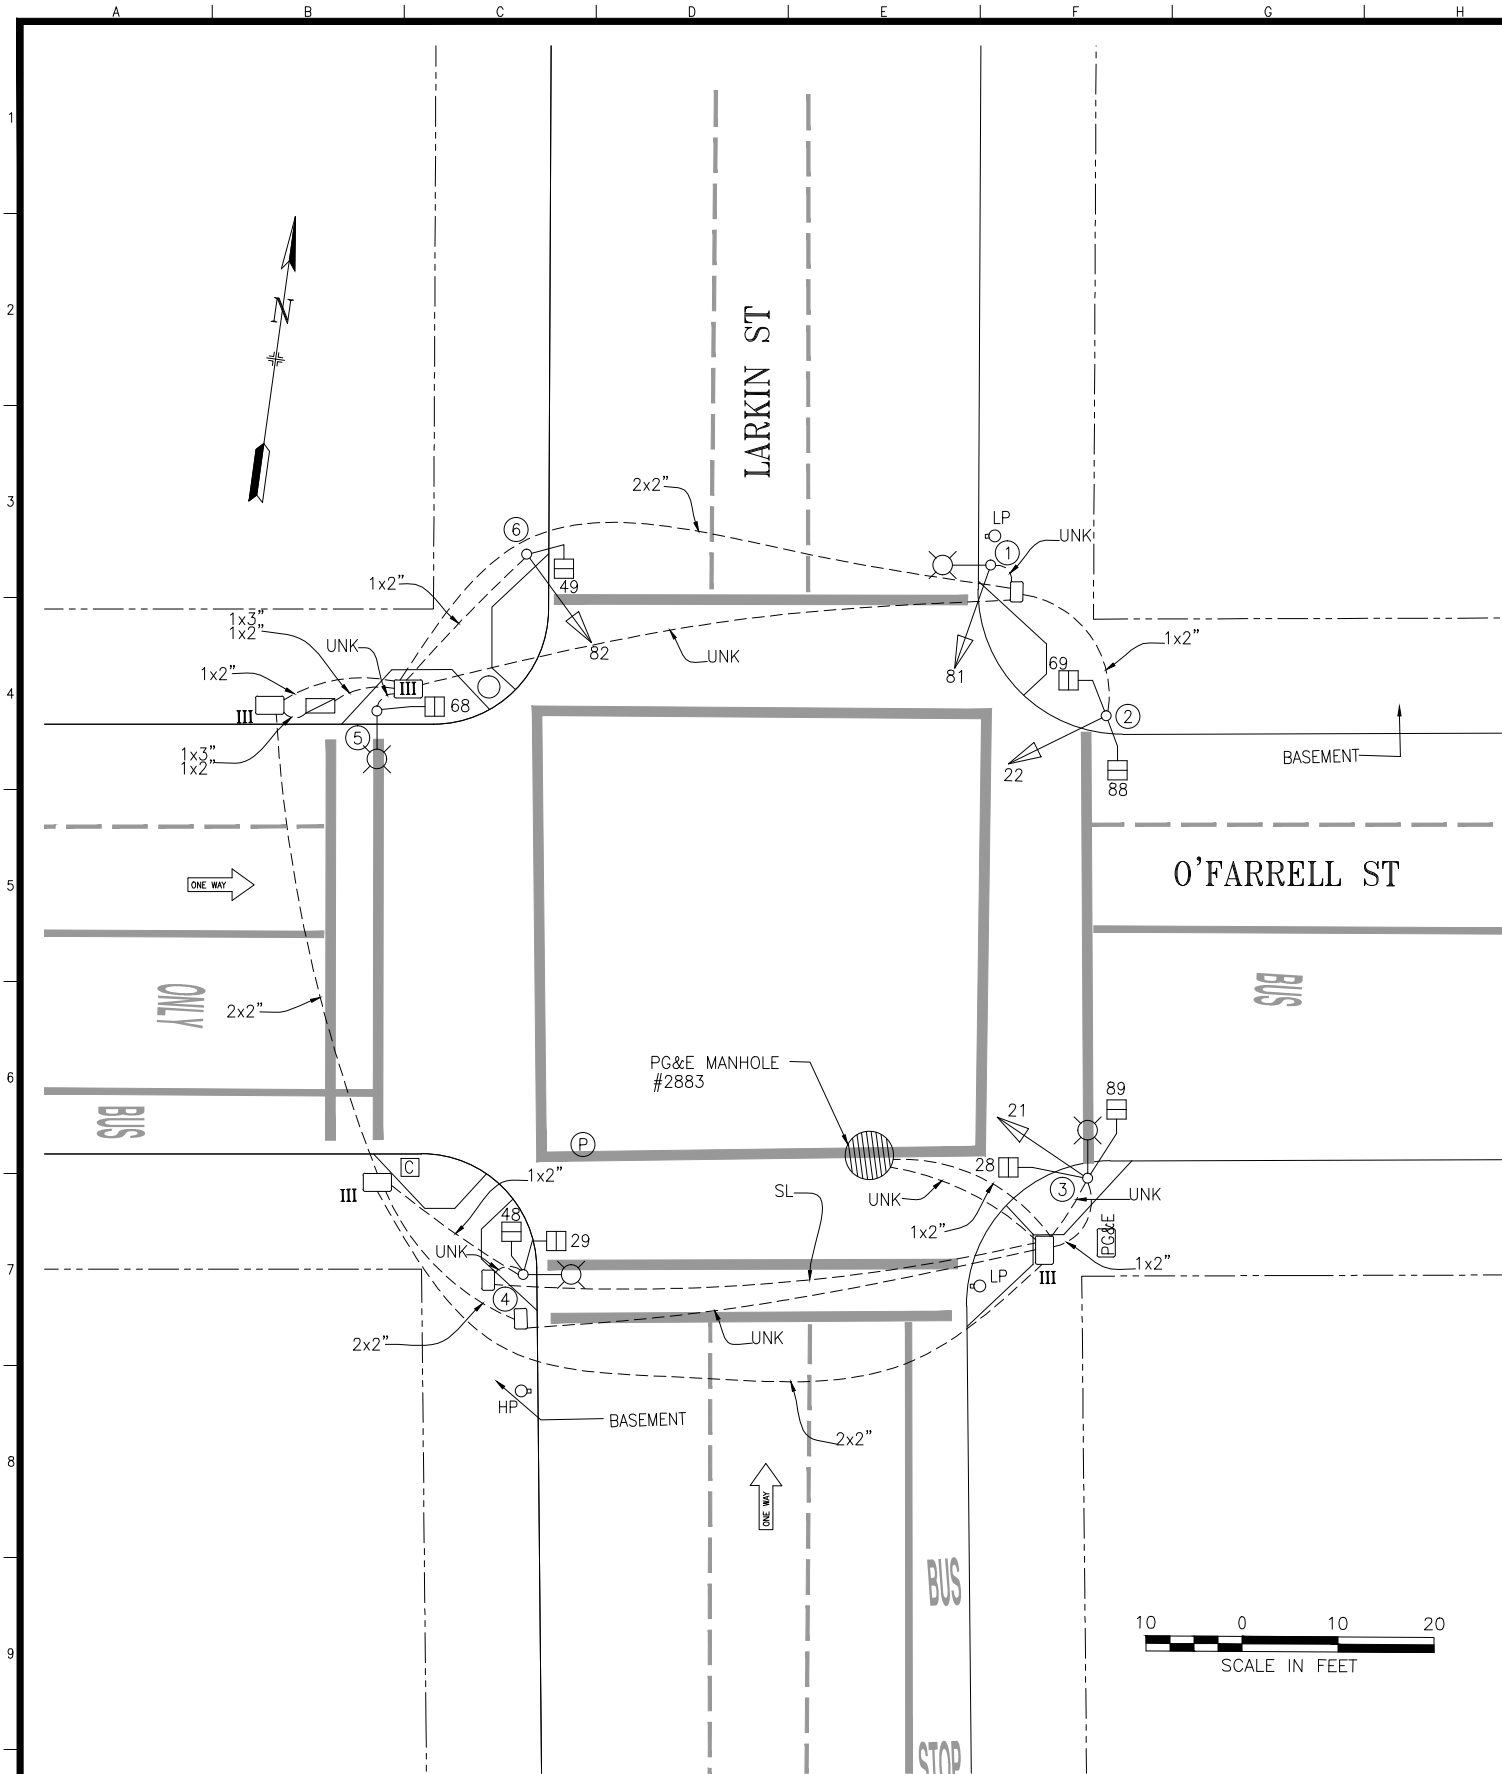

POLE AND EQUIPMENT SCHEDULE										
POLE No.	TYPE OF POLE	VEHICLE SIGNAL					PEDESTRIAN SIGNAL			REMARKS
		No.	TYPE	MOUNTING	VISORS	LOUVERS	No.	TYPE	MOUNTING	
①	SL	81	3S12"	SV-1-T-SF	T					
②	1-A (10')	22	3S12"	TV-1-T	T		69 88	1S-COUNT 1S-COUNT	SP-1 (22") SP-1-SF (12")	
③	SL	21	3S12"	SV-1 (16")	T		28 89	1S-COUNT 1S-COUNT	SP-1 (22") SP-1-SF (12")	
④	SL						29 48	1S-COUNT 1S-COUNT	SP-1-SF (12") SP-1 (22")	
⑤	SL						68	1S-COUNT	SP-1	
⑥	1-A (10')	82	3S12"	TV-1-T	T		49	1S-COUNT	SP-1	

0	07/02/14	SIGNAL UPGRADE ACTIVATED THRU 1901J AND CONVERTED FROM AS-BUILTS	GD	MVelasco
NO.	DATE	DESCRIPTION	BY	APP.
TABLE OF REVISIONS				
CHECK WITH TRACING TO SEE IF YOU HAVE LATEST REVISION				

COMPLETION DATE /
ELECTRICIAN INITIAL



SAN FRANCISCO MUNICIPAL TRANSPORTATION AGENCY
TRANSPORTATION ENGINEERING
CITY AND COUNTY OF SAN FRANCISCO

DRAWN: DATE: SCALE:
AScales 07/06/2015 AS SHOWN
CHECKED: DATE: SHEET OF SHEETS
MVelasco 07/2015 1 OF 1

TRAFFIC SIGNAL INVENTORY DIAGRAM

LARKIN STREET AND O'FARRELL STREET

CNN NO.
25152000
REV. NO.
0