


MCALLISTER & LEAVENWORTH

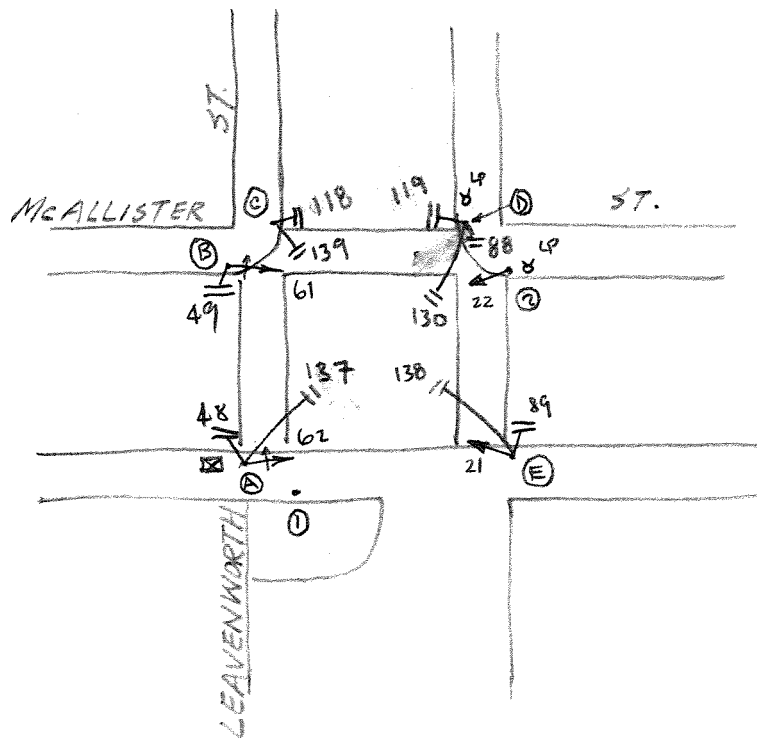

4-28-21

POLE	FUNC.	MAT'L	SIGNAL NO.	MAKE	NO. OF SECT.	SIZE	VISOR	B.P. OR LOUVERS	MOUN'T	PED SIGNAL NO.	LEGEND	MESSAGE		MAKE	MOUN'T
												ELEMENT	COLOR		
A	M	S	62		4	12"	T12"	NO	S	48	15-C	GRD	G/R	WM	S
B	L	S	61		4	12"	T12"	NO	S	49	15-C	GRD	G/R	WM	S
C	S	S	22		3	12"	CAP12"	NO	S	118	15-C	GRD	G/R	WM	S
D	L	S	21		3	12"	T12"	NO	S	119	15-C	GRD	G/R	WM	S
E	S	S								88	15-C	GRD	G/R	WM	S
										89	15-C	B.T.	G/R	WM	T
1	L	S								130	15-C				
2	M	S								137	15-C				
										138	15-C				
										139	15-C				

CONTROLLER CABINET SIZE : ORDINARY BASE CABINET : YES

COMMENTS : Add Diagonal Ped Heads SRC 2021-056

- D. YEUNG 4-28-21