


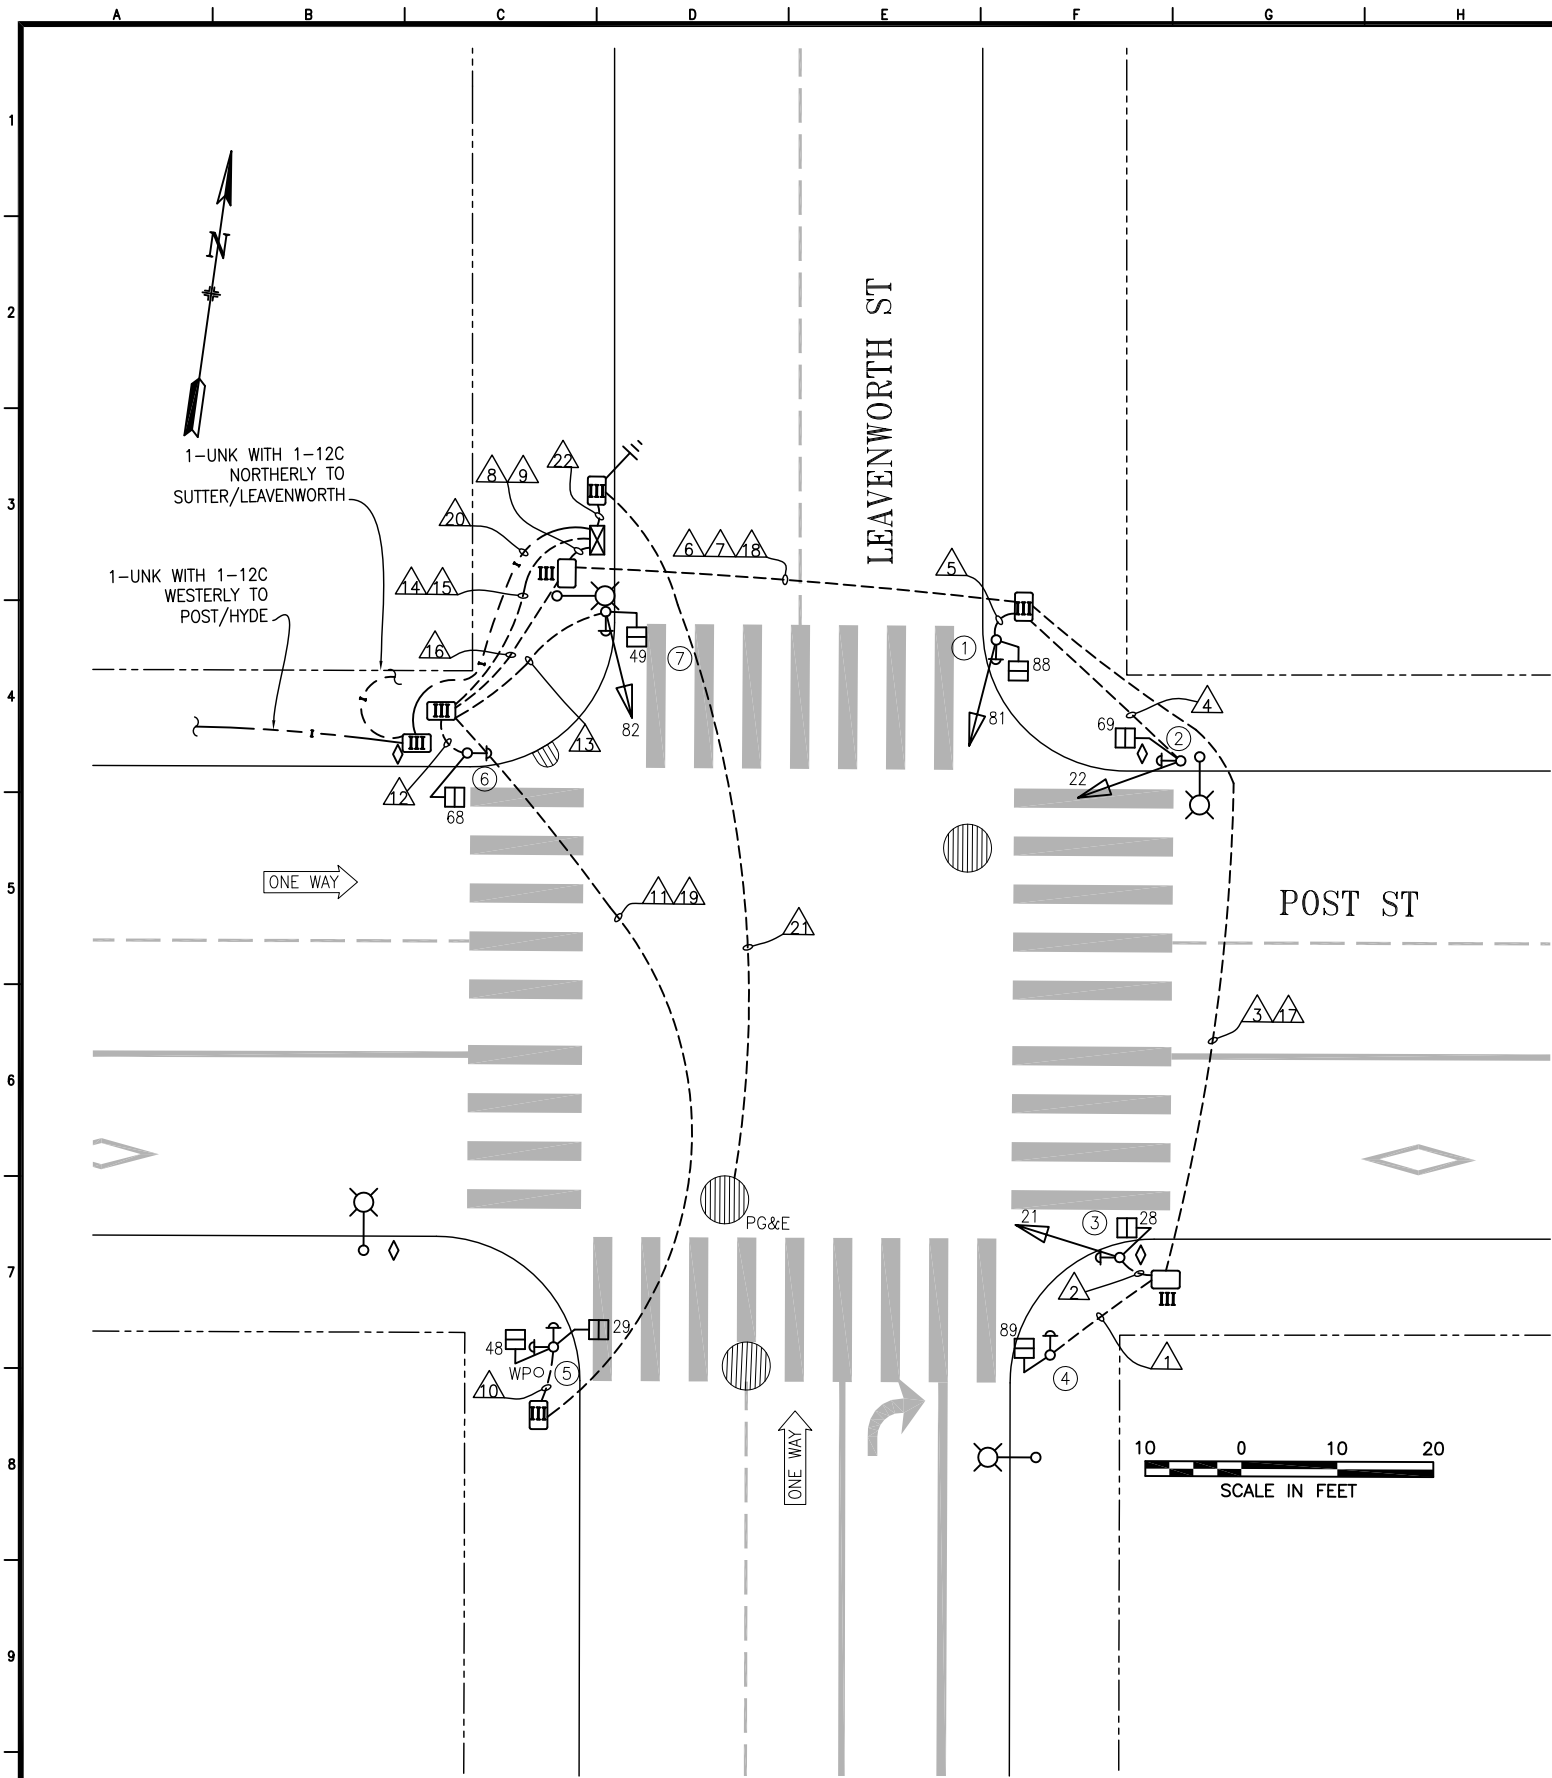

POLE AND EQUIPMENT SCHEDULE									
POLE No.	TYPE OF POLE	LUMINAIRE VOLTAGE/WATTAGE	VEHICLE SIGNAL				PEDESTRIAN SIGNAL		
			No.	TYPE	MOUNTING	VISORS	No.	TYPE	MOUNTING
①	1-A (13')		81	3S12"	TV-1-T	T	88	1S-COUNT	SP-1
②	1-A (13')		22	3S12"	TV-1-T	T	69	1S-COUNT	SP-1 (22")
③	1-A (13')		21	3S12"	TV-1-T	T	28	1S-COUNT	SP-1
④	1-A (7')						89	1S-COUNT	TP-1
⑤	1-A (10')						29 48	1S-COUNT 1S-COUNT	SP-1-SF (12") SP-1 (22")
⑥	1-A (7')						68	1S-COUNT	TP-1
⑦	1-A (13')		82	3S12"	TV-1-T	T	49	1S-COUNT	SP-1

NOTE: APS BUTTONS TO BE INSTALLED AT A LATER DATE

TABLE OF REVISIONS				
NO.	DATE	DESCRIPTION	BY	APP.
1	4/17/20	ADD CONDUIT LABELS PER #2823J AS-BUILT	DYeung	GDeLeon
0	11/14/18	SIGNAL UPGRADE BY 2823J, CONVERTED FROM CONTRACT PLNS	DYeung	GDeLeon
CHECK WITH TRACING TO SEE IF YOU HAVE LATEST REVISION				

REFERENCE INFORMATION & FILE NO. OF SURVEYS



SAN FRANCISCO MUNICIPAL TRANSPORTATION AGENCY
CITY AND COUNTY OF SAN FRANCISCO

DRAWN:	DATE:
DYeung	1/17/2019
CHECKED:	DATE:
GDeLeon	3/20/2019

SCALE:
AS SHOWN
SHEET OF SHEETS
1 OF 2

TRAFFIC SIGNAL INVENTORY DIAGRAM
LEAVENWORTH STREET AND POST STREET

CNN NO.
25157000
REV NO.
1

[illegible][illegible]