




Δ	5/6/21	ADD DIAG PEDS, RENUMBER WEST/SOUTH XWALKS PER NEW PHASING (SRC 2021-046)	DYeung	EWoo	
Δ	10/20/19	NOMA RETIMING; UPDATE PED PHASE #; CHANGE 61/82 TO 4-SECTIONS (SRC 2019-312)	DYeung	CDelton	
Δ	08/06/19	2543J PUNCHLIST WALKTHROUGH; UPGRADE 62 & 81 TO 12"	DYeung	MVelasco	
NO.	DATE	DESCRIPTION	BY	APP.	
TABLE OF REVISIONS CHECK WITH TRACING TO SEE IF YOU HAVE LATEST REVISION					

REFERENCE INFORMATION & FILE NO. OF SURVEYS

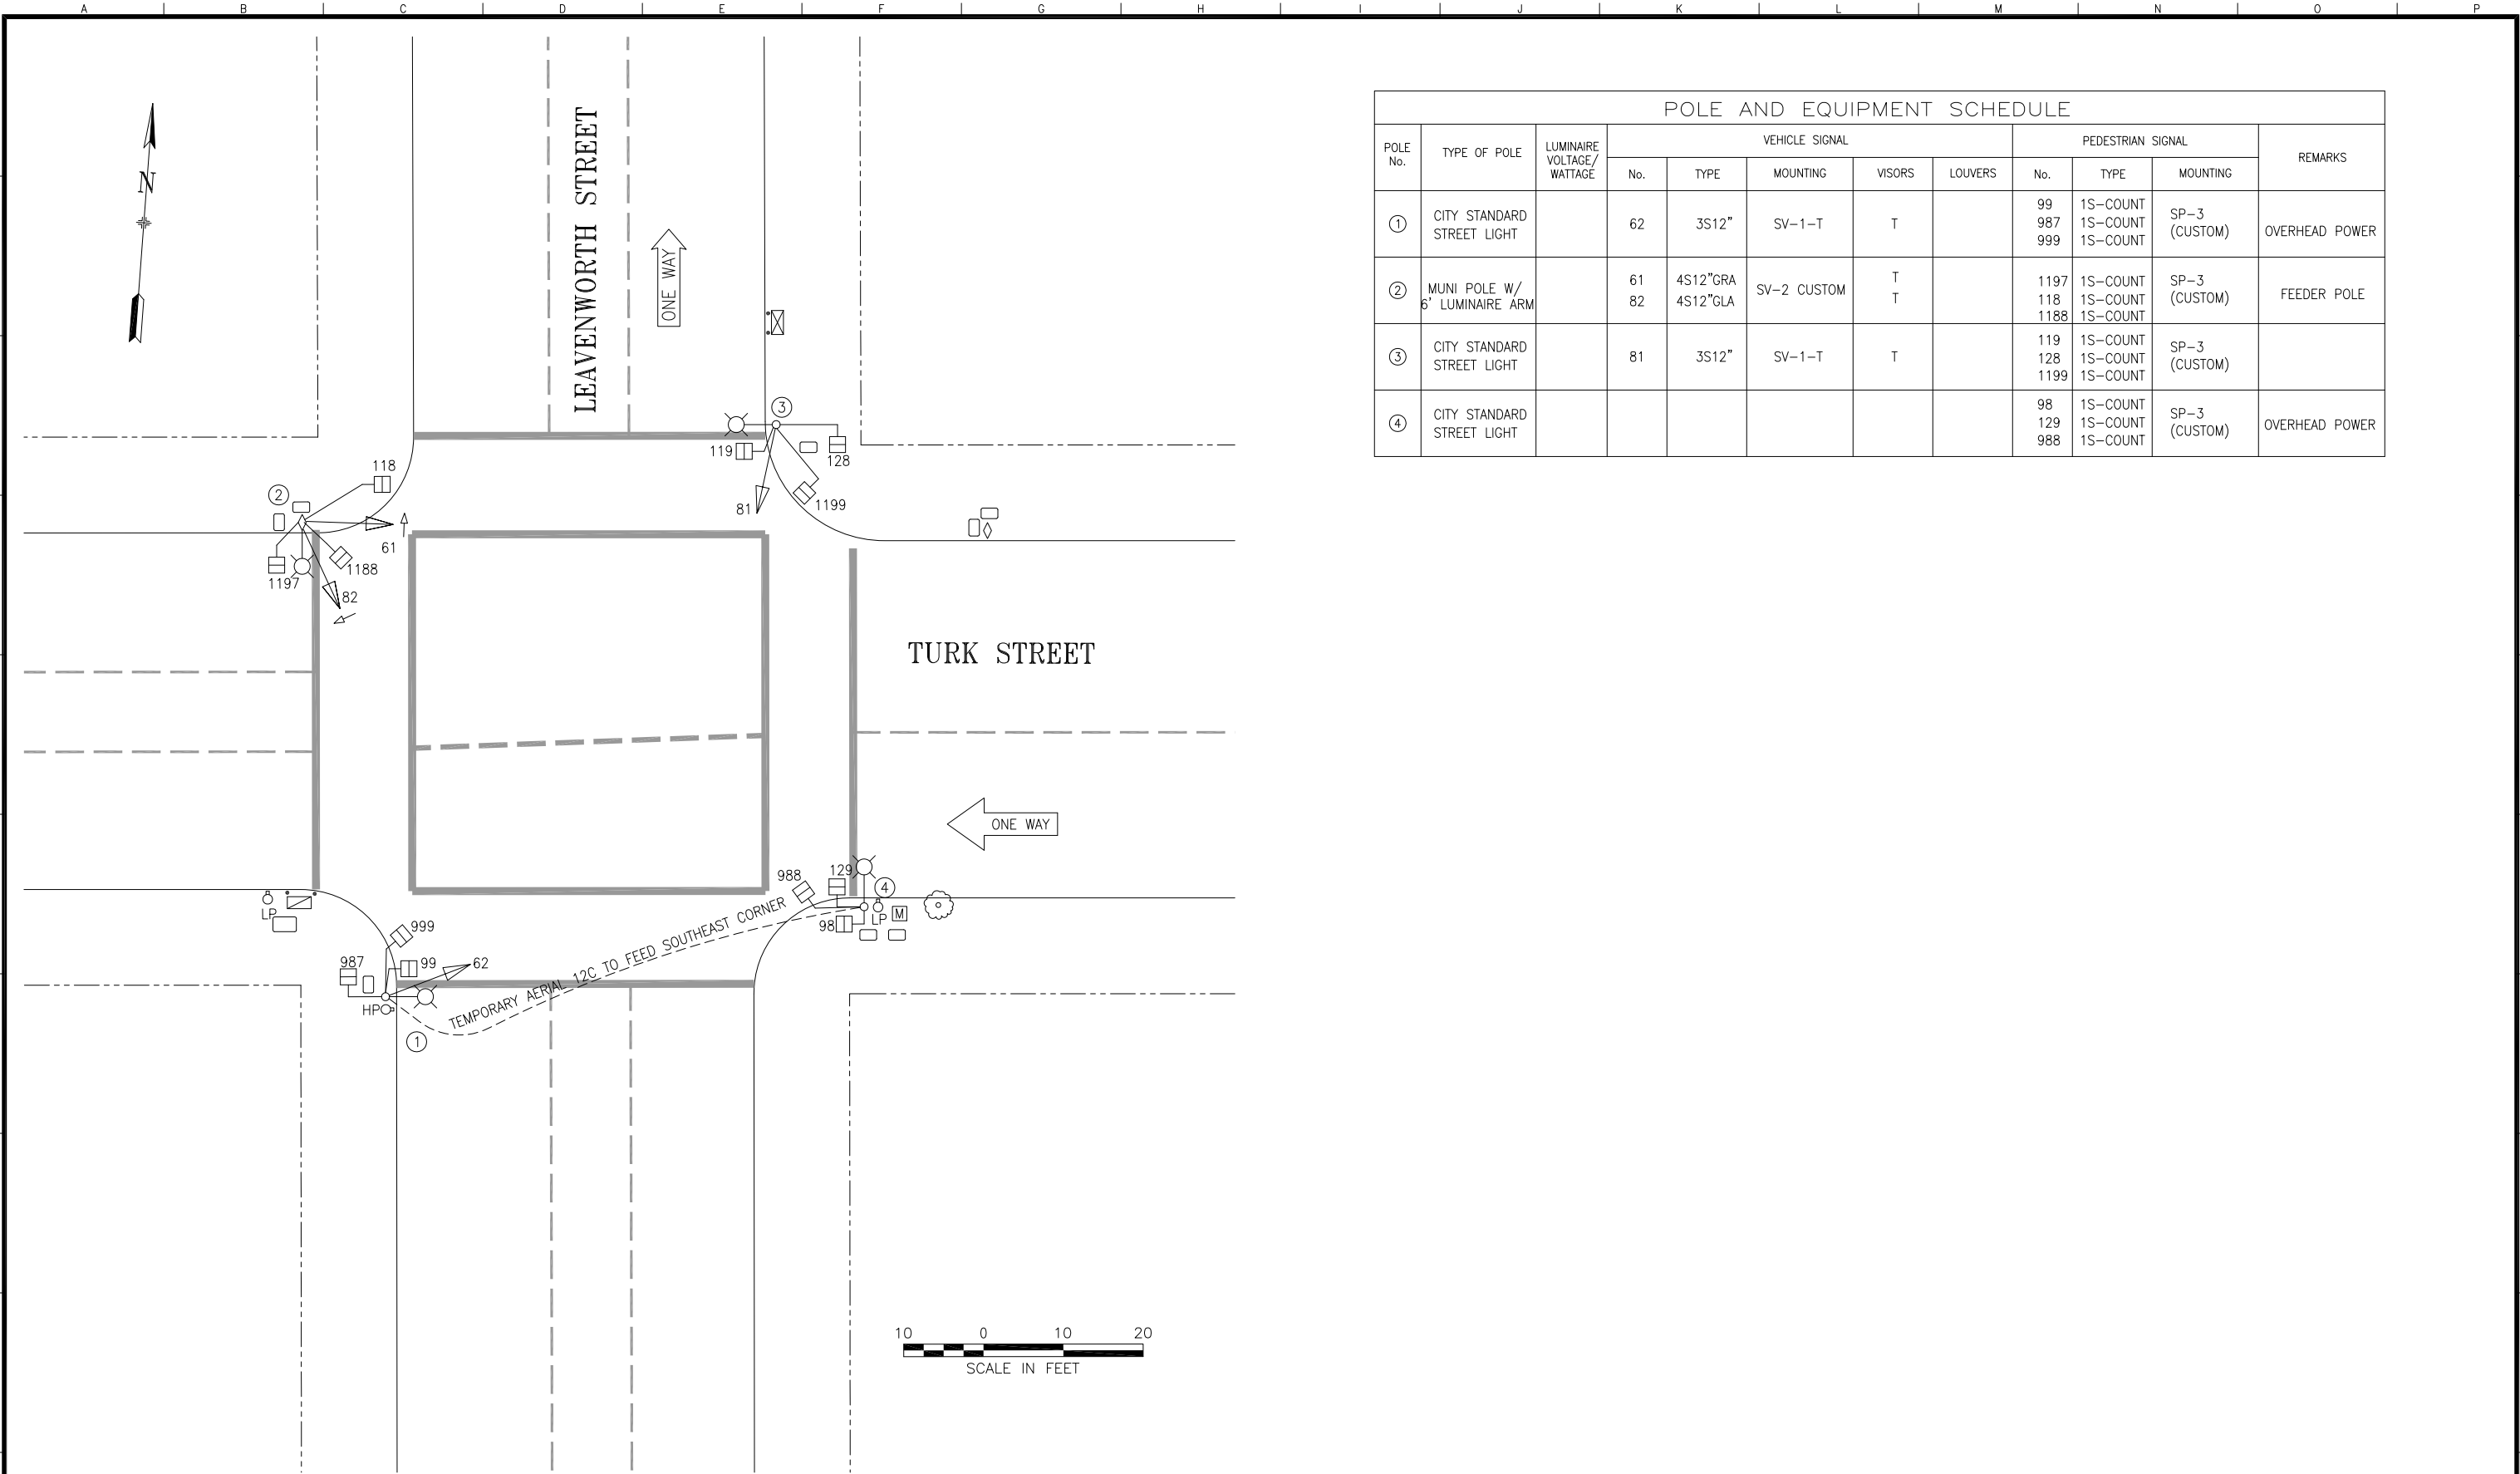

SAN FRANCISCO MUNICIPAL TRANSPORTATION AGENCY

CITY AND COUNTY OF SAN FRANCISCO

DRAWN: AScales	DATE: 12/2015
CHECKED: MVelasco	DATE: 12/2015

SCALE: AS SHOWN
SHEET OF SHEETS 1 OF 1

TRAFFIC SIGNAL INVENTORY DIAGRAM
LEAVENWORTH STREET AND TURK STREET

CNN NO. 24934000
REV NO. 2