


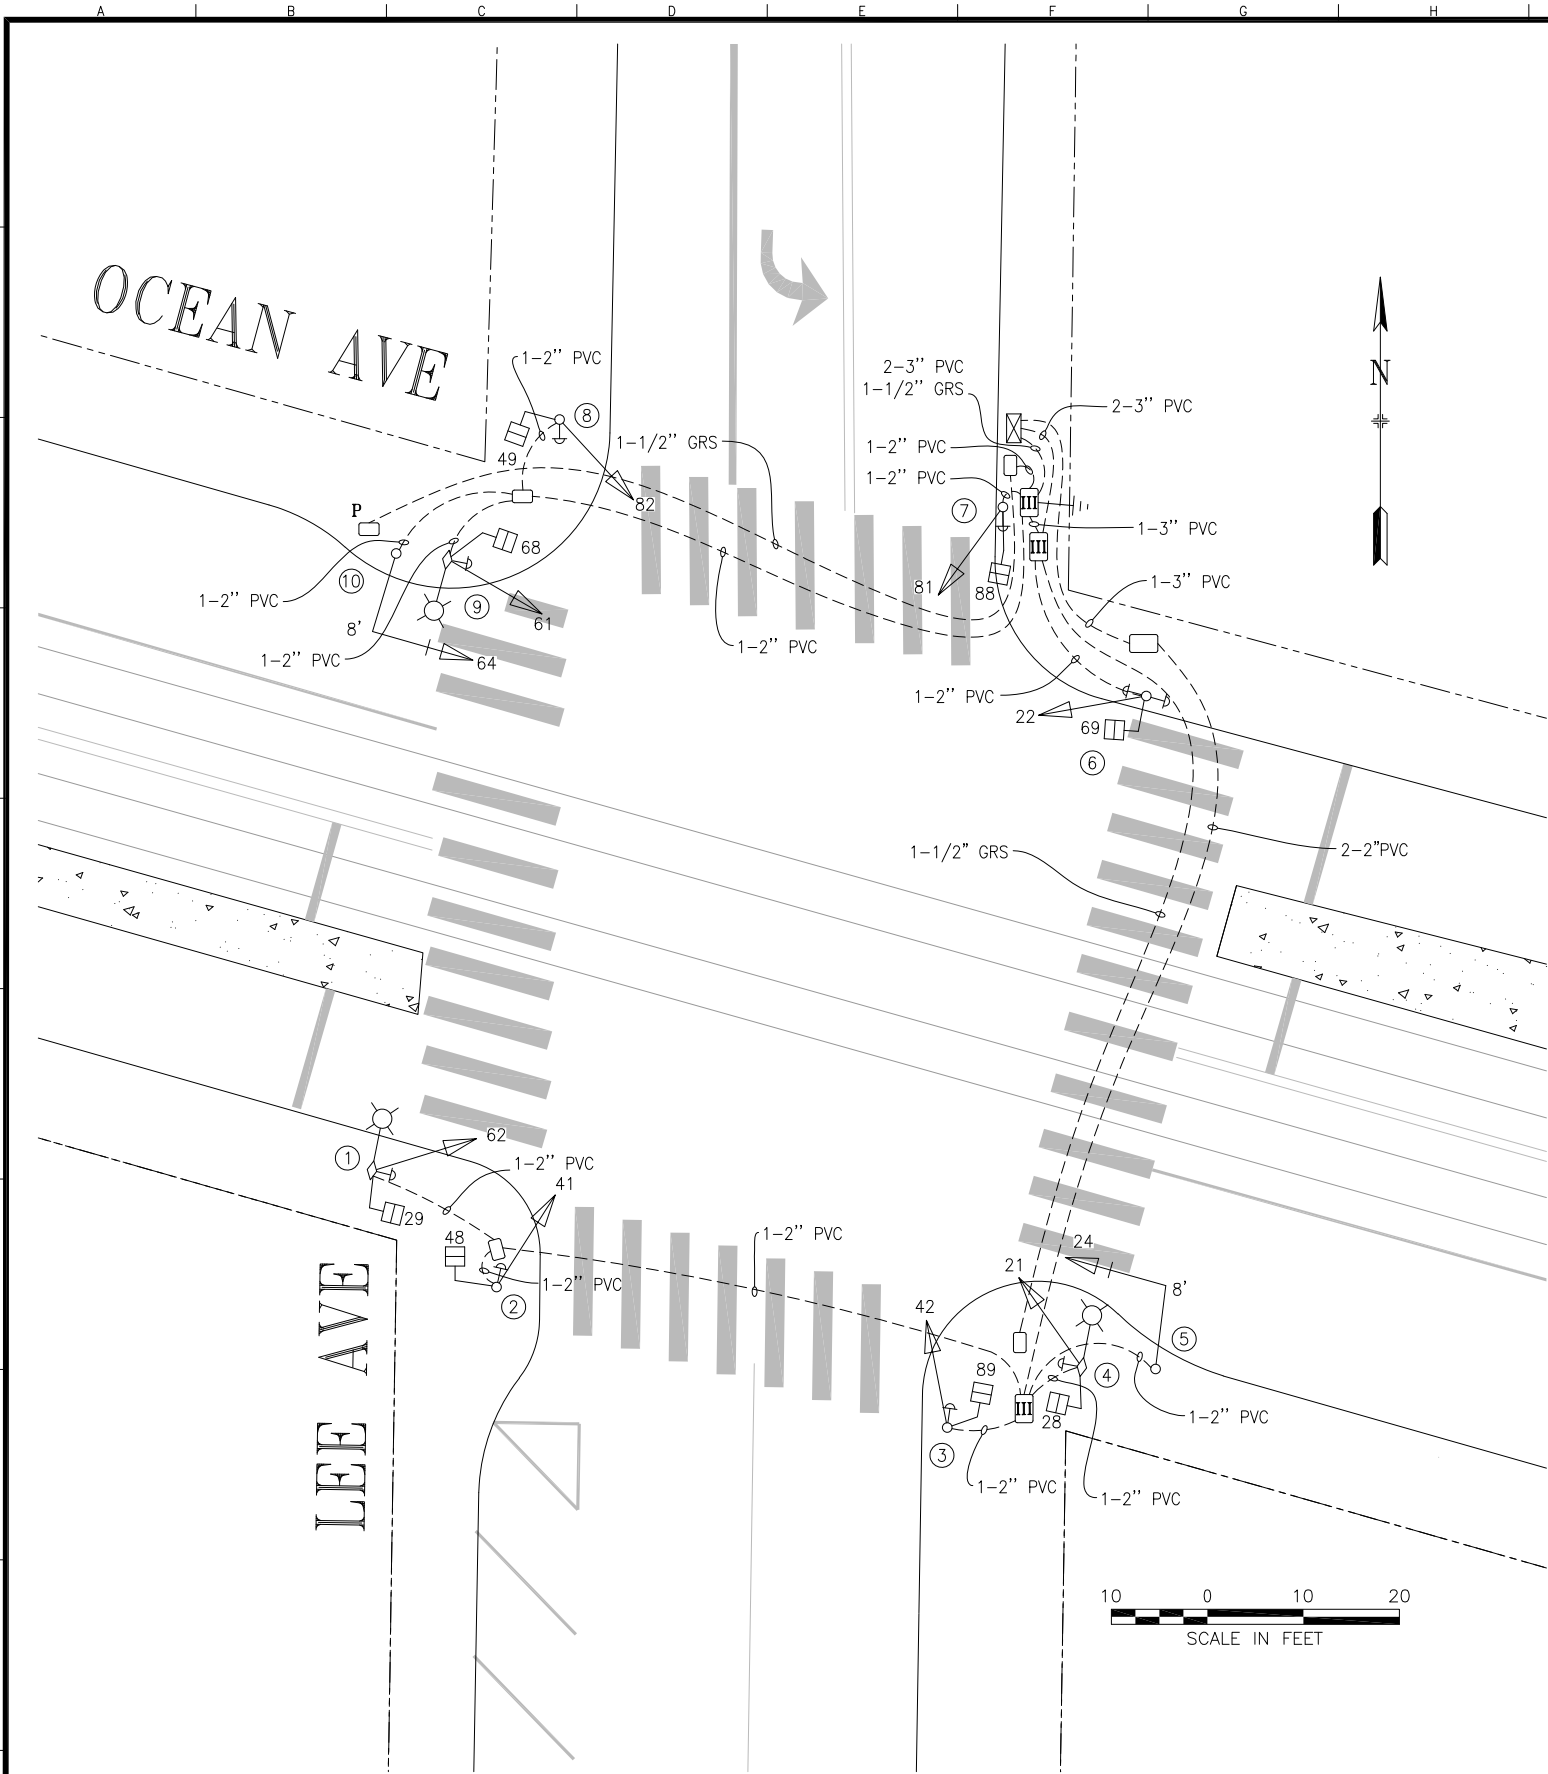

POLE AND EQUIPMENT SCHEDULE									
POLE No.	TYPE OF POLE	VEHICLE SIGNAL				PEDESTRIAN SIGNAL			REMARKS
		No.	TYPE	MOUNTING	VISORS	No.	TYPE	MOUNTING	
①	MUNI STEEL TROLLEY POLE	62	3S12"	SV-1-T	T	29	1S-COUNT	SP-1	APS-3W
②	TYPE 1-A (10-FT)	41	3S12"	TV-1-T	T	48	1S-COUNT	SP-1	APS-3W
③	TYPE 1-A (10-FT)	42	3S12"	TV-1-T	T	89	1S-COUNT	SP-1	APS-3W
④	MUNI STEEL TROLLEY POLE	21	3S12"	SV-1-T	T	28	1S-COUNT	SP-1	APS-3W
⑤	16-1-70 W/ 8-FT MAST ARM	24	3S12"	MAS	T				
⑥	TYPE 1-A (10-FT)	22	3S12"	TV-1-T	T	69	1S-COUNT	SP-1	APS-3W x 2
⑦	TYPE 1-A (10-FT)	81	3S12"	TV-1-T	T	88	1S-COUNT	SP-1	APS-3W
⑧	TYPE 1-A (10-FT)	82	3S12"	TV-1-T	T	49	1S-COUNT	SP-1	APS-3W
⑨	MUNI STEEL TROLLEY POLE	61	3S12"	SV-1-T	T	68	1S-COUNT	SP-1	APS-3W
⑩	16-1-70 W/ 8-FT MAST ARM	64	3S12"	MAS	T				

NO.	DATE	DESCRIPTION	BY	APPROVED
3	3/20/22	INSTALL APS (SRC 2021-058)	E.Luu	G.deLeon
2	02/2020	UPDATE AS PER FIELD	E.Luu	G.deLeon
1	08/13	CONTRACT NO. 1263 SIGNAL WORK	MS	JT
NO.	DATE	DESCRIPTION	BY	APPROVED
TABLE OF REVISIONS				
CHECKOUT DRAWING THROUGH THE SID CUSTODIAN FOR THE LATEST REVISION				



SFMTA

DRAWN BY:	DATE:
MS	7/2015
CHECKED BY:	DATE:
JT	7/2015

SCALE
AS SHOWN
SHEET OF SHEETS
1 of 1

TRAFFIC SIGNAL INVENTORY DIAGRAM
LEE AVENUE & OCEAN AVENUE

CNN NO:
22223000
REV NO:
3