


DIST	COUNTY	ROUTE	KILOMETER POST TOTAL PROJECT	SHEET No	TOTAL SHEETS
04	SF	101	10.8/12.9	35	61

8-9-04



The State of California or its officers or agents shall not be responsible for the accuracy or completeness of electronic copies of this plan sheet.

Caltrans now has a web site! To get to the web site, go to: <http://www.dot.ca.gov>

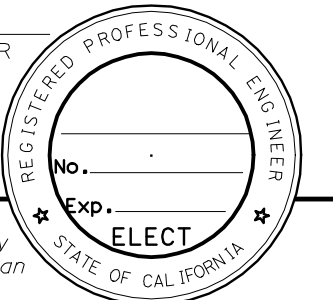


CONTRACT NO. 04-171204
DATE ACCEPTED 12/20/06
AS BUILT
RESIDENT ENGINEER F Duan

SIGNATURE _____ DATE 12/12/07
CHECKED BY R.L. DATE 04/08

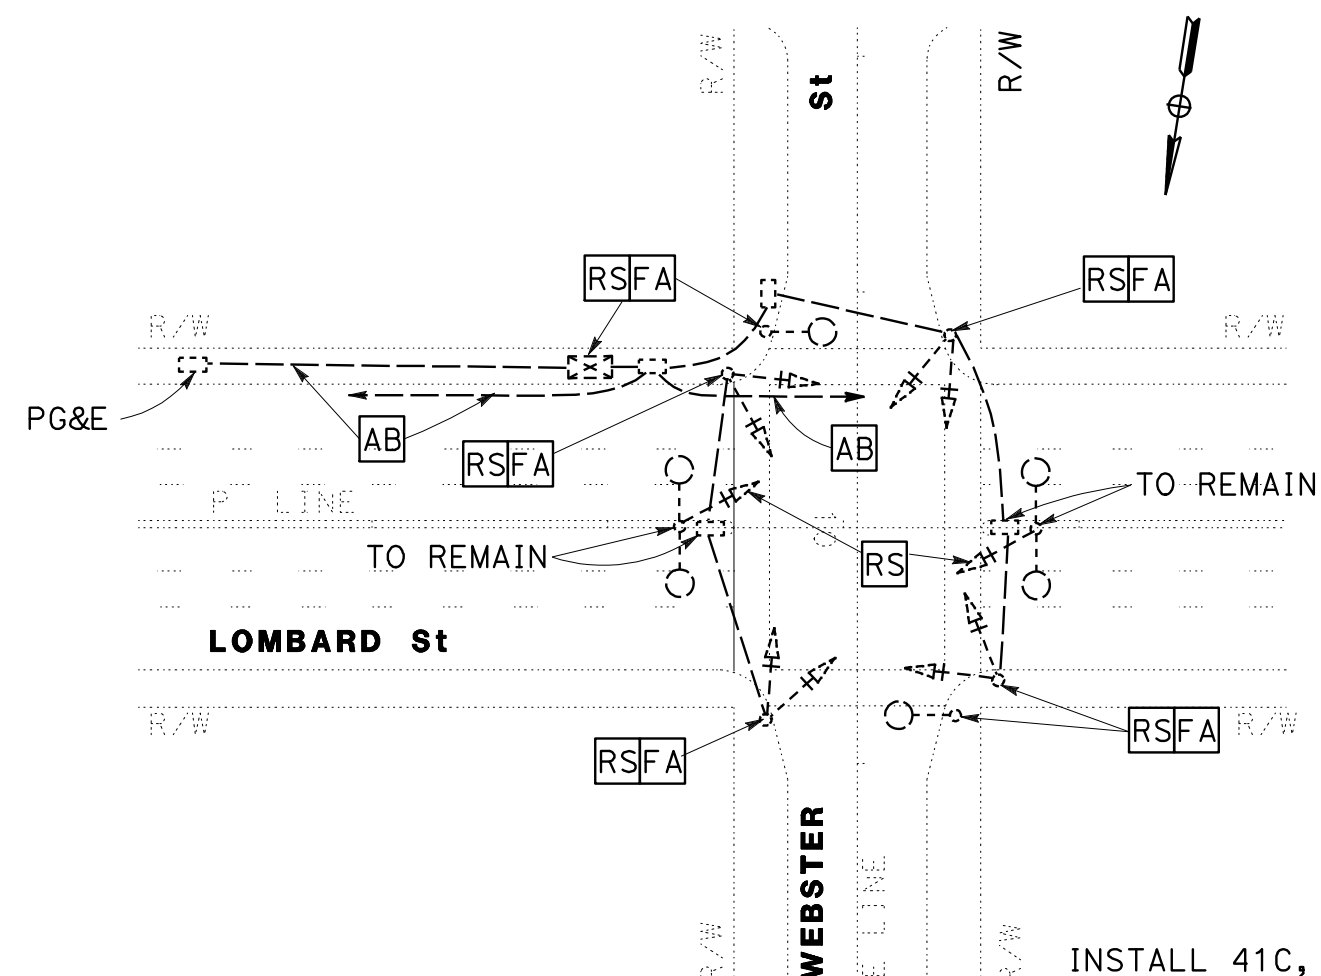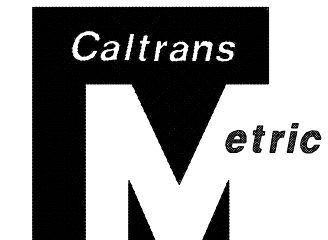

EXISTING EQUIPMENT
SCALE 1:500

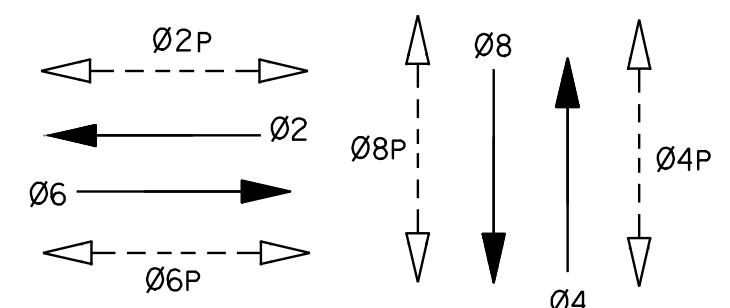


PHASE DIAGRAM

SEE "PG&E SERVICE CONNECTION DETAILS"
ON SHEET E-3

SYSTEM No. 34-101-07231 (PG&E)

UNDERGROUND SERVICE (~~120/240~~ V)

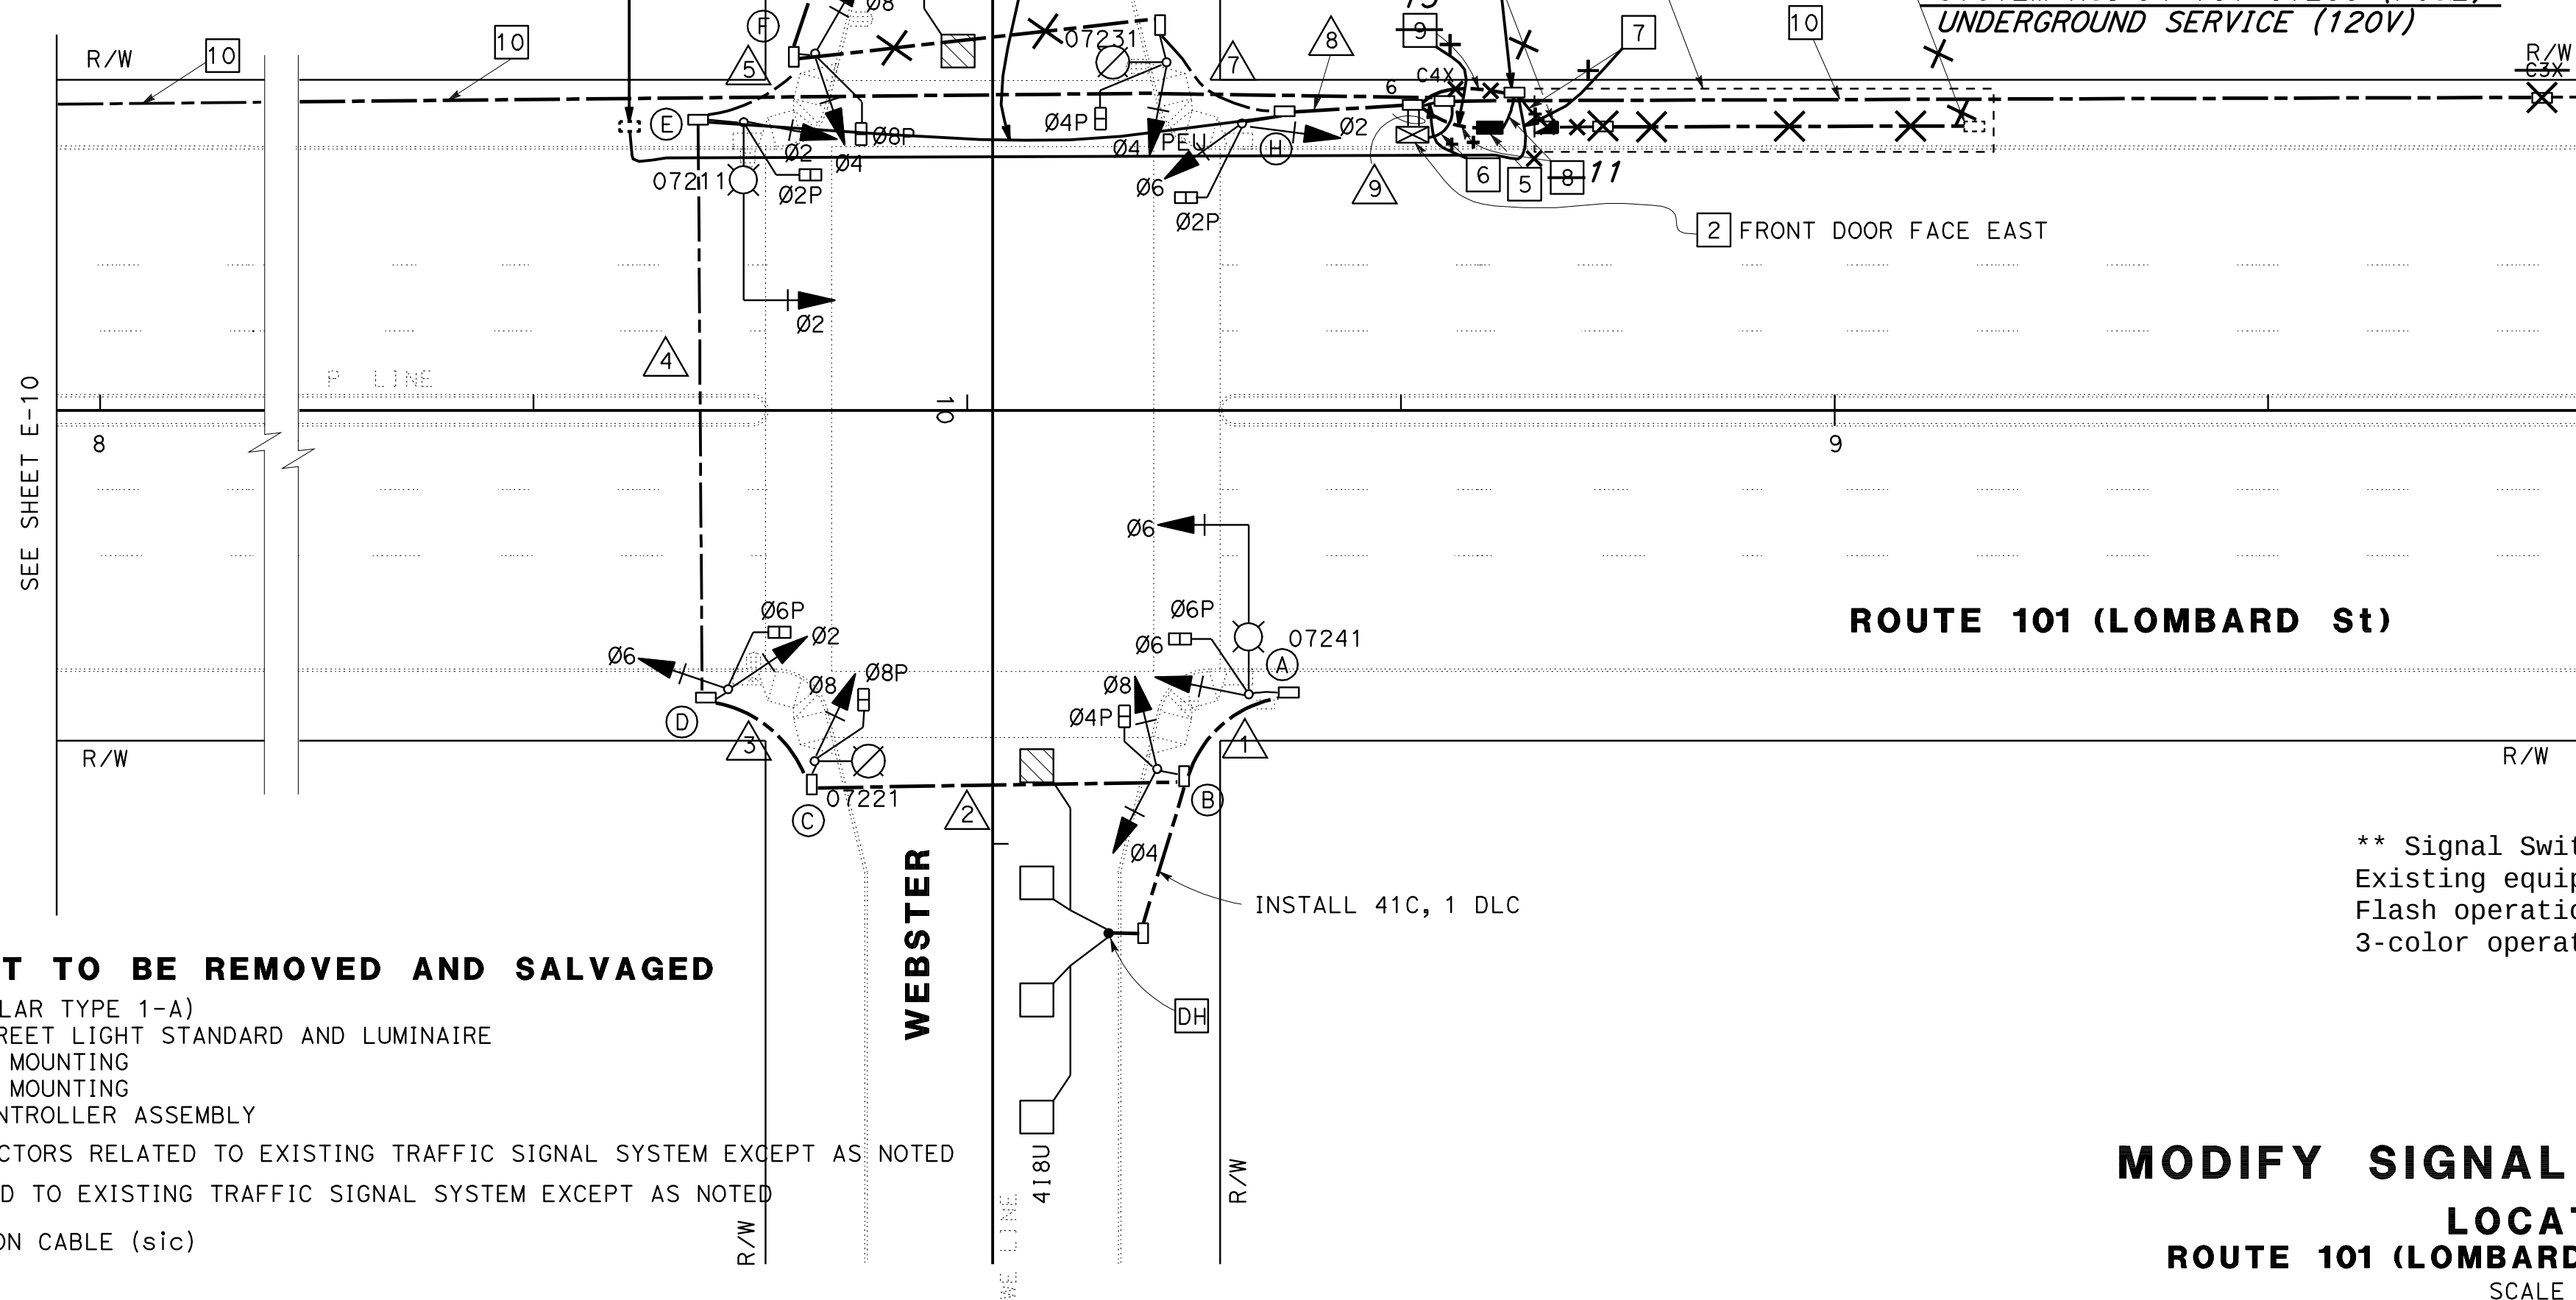

- 4 CITY CONCRETE POLE (SIMILAR TYPE 1-A)
2 CITY TYPE D CONCRETE STREET LIGHT STANDARD AND LUMINAIRE
4 TYPE TV-2-T SIGNAL HEAD MOUNTING
2 TYPE SV-1-T SIGNAL HEAD MOUNTING
1 TYPE "M" INTERSECTION CONTROLLER ASSEMBLY

AB ALL CONDUITS AND CONDUCTORS RELATED TO EXISTING TRAFFIC SIGNAL SYSTEM EXCEPT AS NOTED

RC ALL PULL BOXES RELATED TO EXISTING TRAFFIC SIGNAL SYSTEM EXCEPT AS NOTED

AB EXISTING INTERCONNECTION CABLE (sic)

```

** Signal Switchover: 03-30-2006 **
Existing equipment turned off: 11:07 AM
Flash operation initiated: 11:15 AM
3-color operation initiated: 11:51 AM

```

MODIFY SIGNAL AND LIGHTING

LOCATION 6

ROUTE 101 (LOMBARD St)/WEBSTER St

SCALE 1 : 200

THIS PLAN IS ACCURATE FOR ELECTRICAL WORK ONLY

ALL DIMENSIONS ARE IN
METERS UNLESS OTHERWISE SHOWN

```

USERNAME => s117499
DGN_FILE => 417120U012.dsb

```

CU 04220

EA 171201

E-12

DATE PLOTTED => 03-FEB-2009	LAST REVISION
TIME PLOTTED => 10:48	04-13-04

