


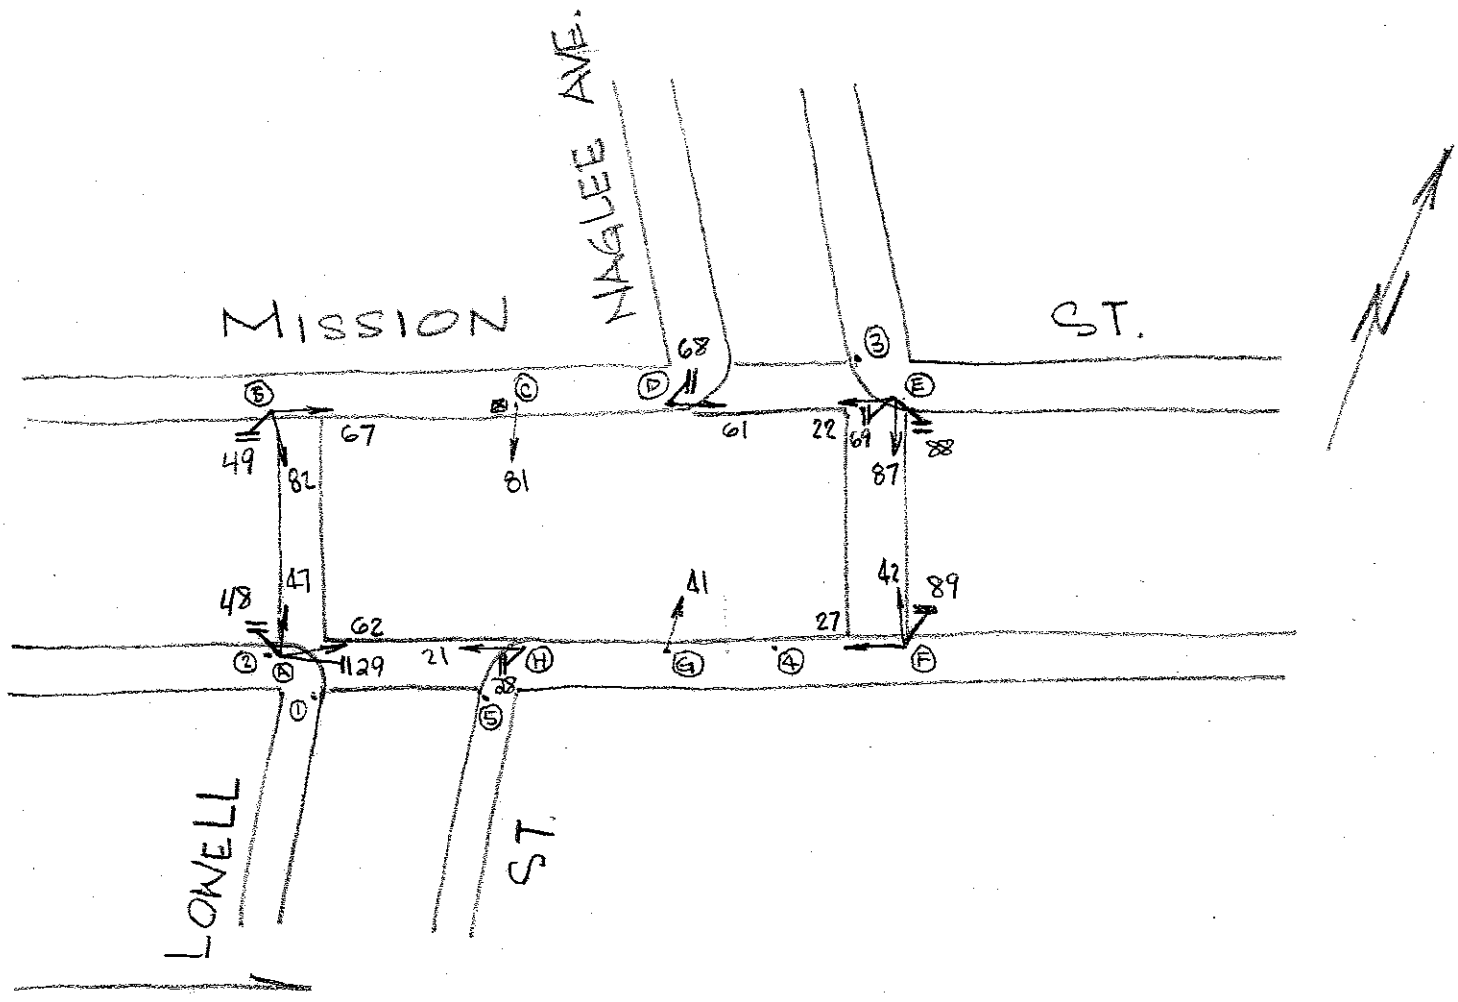

02

2-22-04

POLE	FUNC.	MAT'L	SIGNAL NO.	MAKE	NO. OF SECT.	SIZE	VISOR	B.P. OR LOUVERS	MOUN'T	PED SIGNAL NO.	LEGEND	MESSAGE		MAKE	MOUN'T
												ELEMENT	COLOR		
A	M	S	62	TCT	3	8"	FL 8"	NO	S	28	COUNT	LED	WH/OR	Dialight	S
B	M	S	47	TCT	3	8"	FL 8"	NO	S	29	COUNT	LED	WH/OR	Dialight	S
C	S	S	82	TCT	3	8"	FL 8"	NO	S	48	COUNT	LED	WH/OR	Dialight	S
D	M	S	67	TCT	3	8"	FL 8"	NO	S	49	COUNT	LED	WH/OR	Dialight	S
E	S	S	81	GA	3	8"	FL 8"	NO	T	68	COUNT	LED	WH/OR	Dialight	S
F	S	S	61	TCT	3	8"	FL 8"	NO	S	69	COUNT	LED	WH/OR	Dialight	S
G	M	S	22	GA	2	8"	FL 8"	NO	T	88	COUNT	LED	WH/OR	Dialight	S
H	S	S	87	GA	3	8"	FL 8"	NO	T	89	COUNT	LED	WH/OR	Dialight	S
			42	EC	3	8"	FL 8"	NO	T						
1	U	W	27	EC	3	8"	FL 8"	NO	T						
2	U	W	41	GA	3	8"	FL 8"	NO	S						
3	U	W	21	EA	3	8"	FL 8"	NO	T						
4	U	W													
5	U	W													

CONTROLLER CABINET SIZE : ORDINARY BASE CABINET: NO

COMMENTS: ADDED 8 COUNTDOWN PED SIGNALS. (28, 29, 48, 49, 68, 69, 88, 89)