


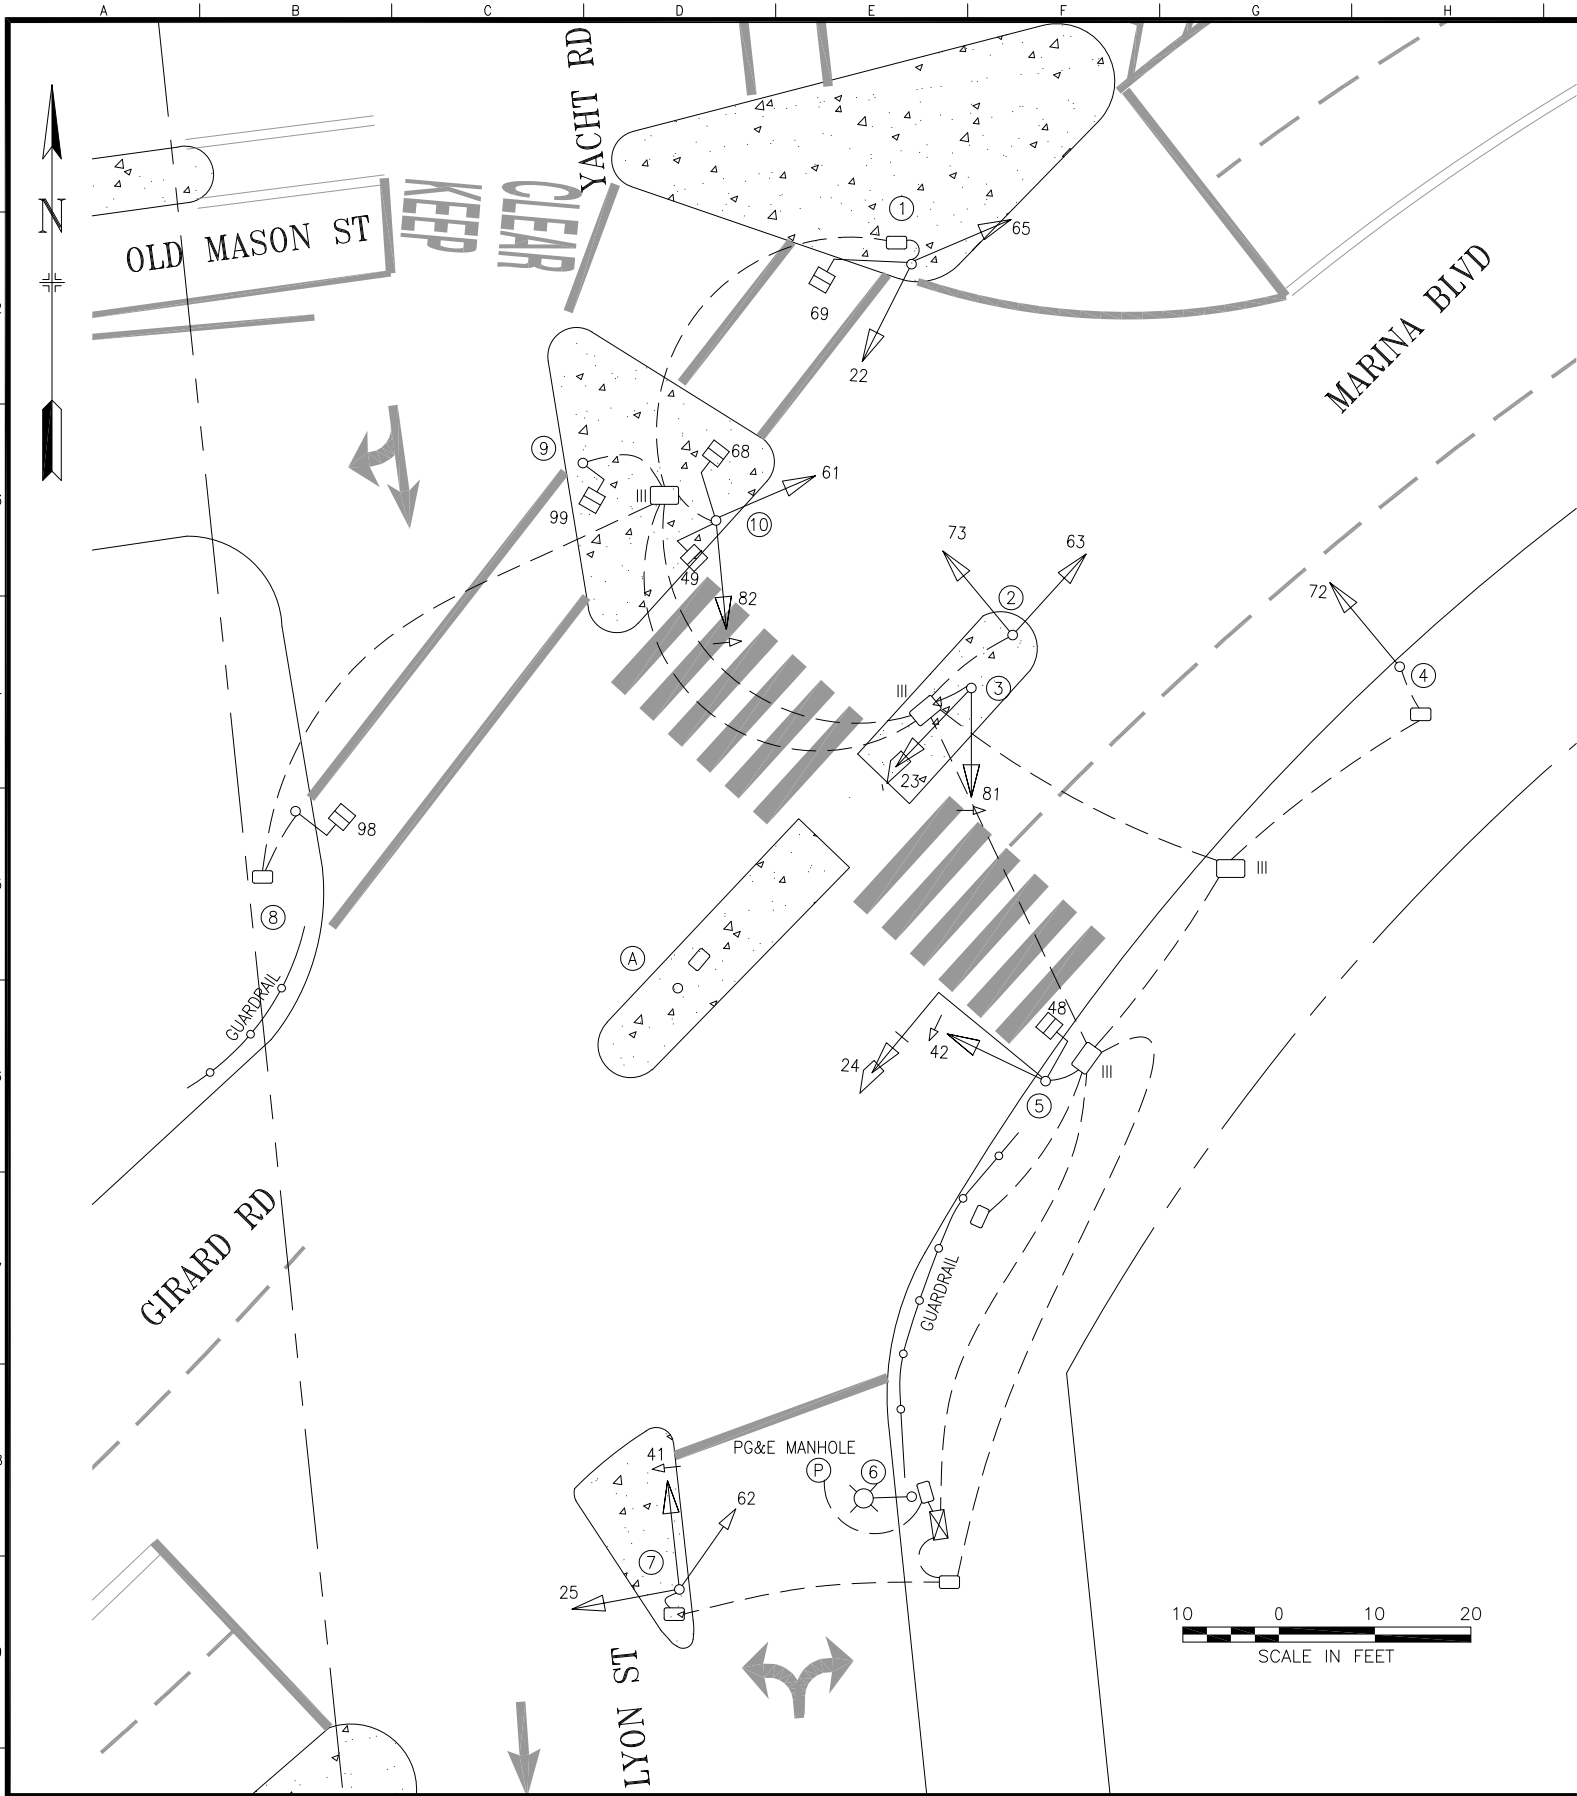

POLE AND EQUIPMENT SCHEDULE											
POLE No.	TYPE OF POLE	LUMINAIRE (HPS)	VEHICLE SIGNAL					PEDESTRIAN SIGNAL			REMARKS
		VOLTAGE/ WATTS	No.	TYPE	MOUNTING (F/I)	VISORS	BP LOUVERS	No.	TYPE	MOUNTING (F/I)	
①	1-A (10')		22 65	3S12" 3S12"	TV-2-T-SF	T T	VERT LOUVERS FOR 22	69	1S-COUNT	SP-1	
②	1-A (10')		73 63	3S12" 3S12"	TV-2-T	T T	VERT LOUVER ON 73 G BALL ONLY				LIMIT 73 G BALL VISIBILITY FROM SB YACHT RD
③	1-A (13')		23 81	3S12" 3S12"RA	TV-2-T	ANGLE T					
④	1-A (10')		72	3S12"	TV-1-T	T					
⑤	16-2-70 W/ 15' MA		24 42	3S12" 3S12"RA	MAS SV-1-T	ANGLE T	BP FOR 24	48	1S-COUNT	SP-1	42 IS ON SIDE OF POLE 180° FROM CURB
⑥	EX MARBLELITE	120/200									
⑦	1-A (10')		25 41 62	3S12" 3S12"RA 3S8"	TV-3-TA	T T T	HORIZ LOUVER ON 41 G BALL ONLY				LIMIT 41 G BALL VISIBILITY FROM SB YACHT RD
⑧	1-A (7')							98	1S-COUNT	TP-1	
⑨	1-A (7')							99	1S-COUNT	TP-1	
⑩	1-B (10')		61 82	3S12" 3S12"RA	TV-2-T	T T		49 68	1S-COUNT 1S-COUNT	SP-1 SP-1	
Ⓐ	1-A (10')										

NO.	DATE	DESCRIPTION	BY	APP.
4	12/2020	SIGNAL 72 REPLACED WITH 3S12" PER FIELD	JH	GD
3	3/25/20	REMOVE RLC PER 2855J AS-BUILTS	JH	GD
2	4/17/19	CHANGE SIGS 41, 42, 81, & 82 TO 3S12"RA (SRC 2018-348)	EC	BW
1	5/11/14	ADD ANGLE VISORS AND LOUVERS (SRC 2012-281)	DY	BW
0	10/25/12	NEW SID - PER FIELD CHECK	DY	BW

TABLE OF REVISIONS
CHECK WITH TRACING TO SEE IF YOU HAVE LATEST REVISION

REFERENCE INFORMATION & FILE NO. OF SURVEYS
--



SAN FRANCISCO MUNICIPAL TRANSPORTATION AGENCY

CITY AND COUNTY OF SAN FRANCISCO

DRAWN:	DATE:
DY	5/14
CHECKED:	DATE:
BW	5/14

SCALE:
AS SHOWN
SHEET OF SHEETS
1 OF 1

TRAFFIC SIGNAL INVENTORY DIAGRAM
LYON STREET/MARINA BOULEVARD/ OLD MASON STREET

CNN NO.
33625000
REV NO.
4