



No Comments.

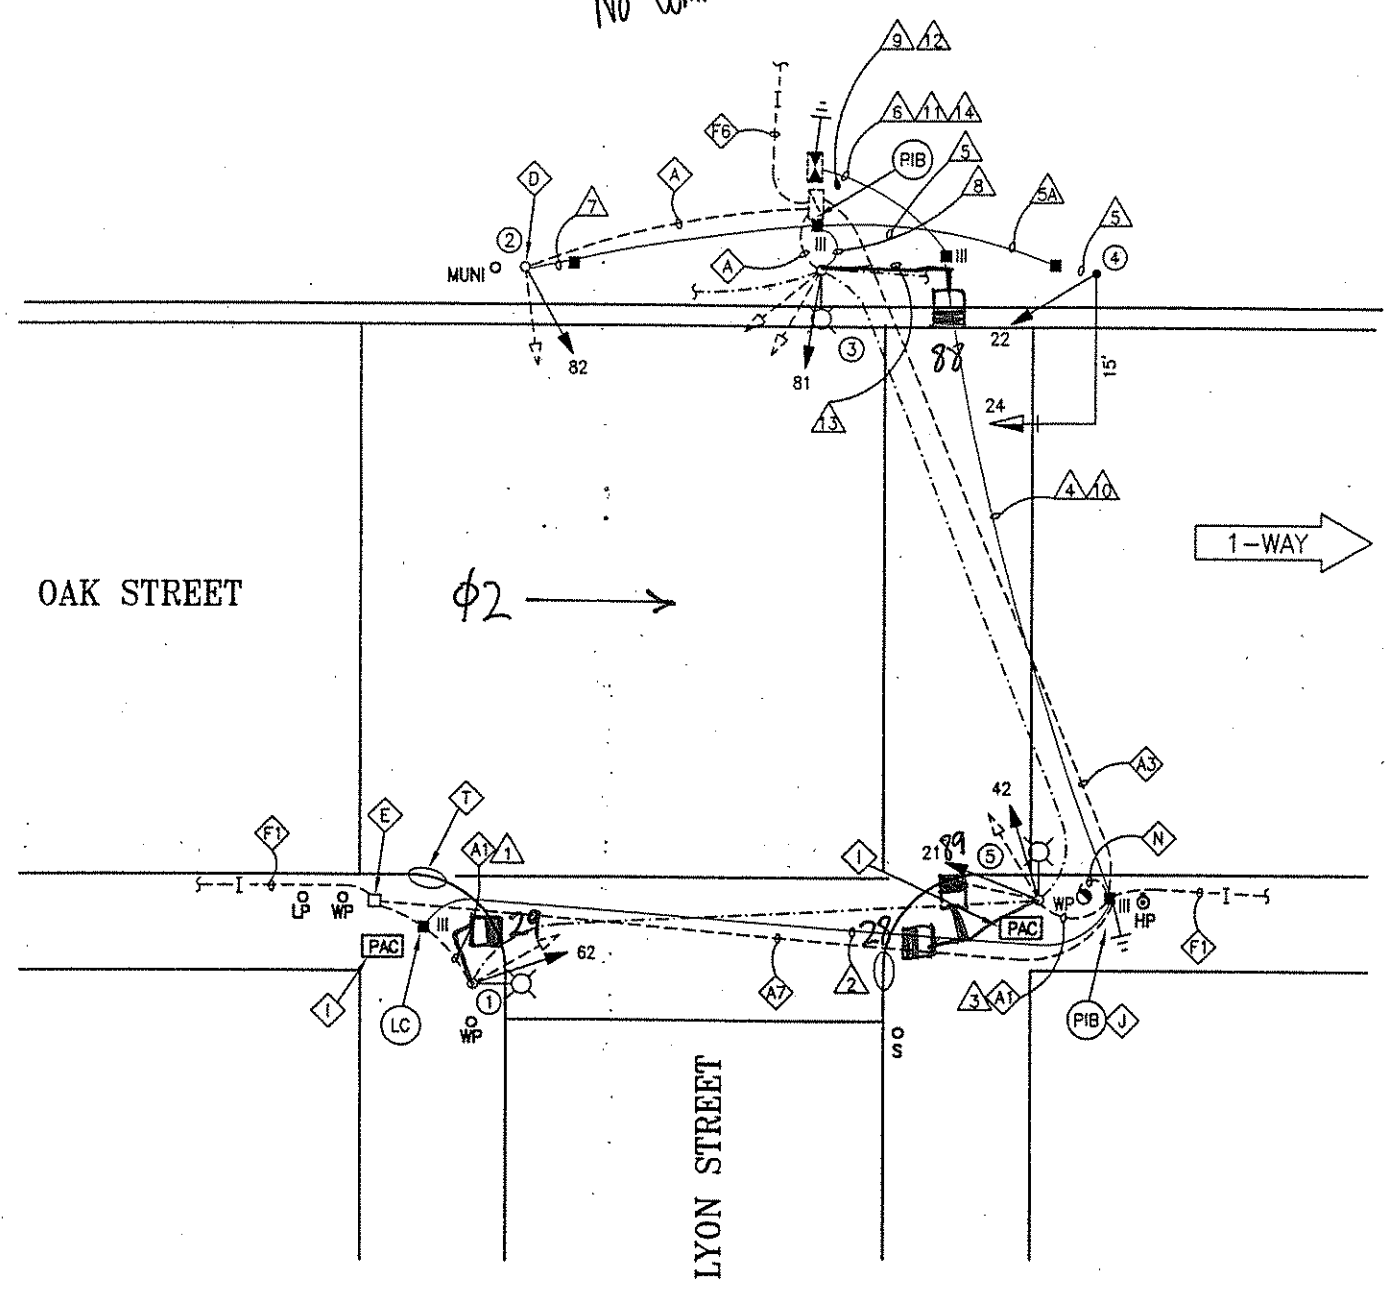

PHASE DIAGRAM

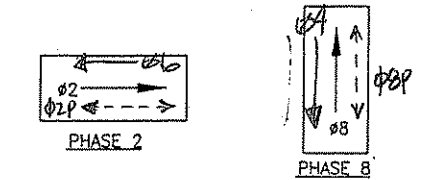

PHASE SEQUENCE

G	Y	R	
R		G	Y
FRH		RH	
RH		FRH	RH

OAK STREET
LYON STREET
XING LYON
XING OAK

SHEET NOTES:

1. ADDITIONAL PULLBOXES, CONDUIT, AND 12/C TO BE FURNISHED AND INSTALLED AT THIS INTERSECTION ARE SHOWN ON DWG. E-43.1.
2. ON NORTH-EAST SIDE, TEMPORARILY BACK FILL TRENCH AND COORDINATE WITH TERRY WEBSTER OF DPW CEMENT SHOP AT 695-2648 TO CONSTRUCT CURB RAMP.

DETAIL NOTES:


- A EX CONDUIT AND WIRING. R/C EX WIRING. CUT CONDUIT FLUSH TO PULL BOX WALL OR 12" DEPTH, CAP CONDUIT END(S).
- A1 EX CONDUIT AND WIRING. R/C EX WIRING. F/I NEW WIRING AS NOTED.
- A3 EX CONDUIT AND WIRING. R/C EX TS WIRING. EX SERVICE WIRES AND 12/C. CUT CONDUIT FLUSH TO PULL BOX WALL OR 12" DEPTH, CAP CONDUIT END(S).
- A7 EX CONDUIT AND WIRING. R/C EX TS WIRING AND EX 12/C. CUT CONDUIT FLUSH TO PULL BOX WALL OR 12" DEPTH, CAP CONDUIT END(S).
- D CHIP EX FOUNDATION CAREFULLY TO BRING CONDUIT INTO BASE OF STANDARD OR CONTROLLER CABINET AND REPAIR AFTER INSTALLATION (INCLUDE REPAIR OF CONCRETE PAD AROUND THE FOUNDATION IF APPLICABLE).
- E R/C EX PULL BOX. REPAIR SIDEWALK TO MATCH EX.
- F1 EX CONDUIT AND 12/C, R/C EX 12/C, CUT CONDUIT FLUSH TO PULL BOX WALL OR 12" DEPTH, CAP CONDUIT END(S). FOR CONTINUOUS DISTANCE BETWEEN PULL BOXES, SEE DWG. E-43.1.
- F6 EX CONDUIT AND 12/C, R/C EX 12/C, CUT CONDUIT FLUSH TO PULL BOX WALL OR 12" DEPTH, CAP CONDUIT END(S). FOR CONTINUOUS DISTANCE BETWEEN THE CONTROLLERS FROM OAK STREET TO FELL STREET, SEE DWG. E-43.1.
- I PAC BELL TO RELOCATE THE PULL BOX. CONTRACTOR SHALL COORDINATE WITH PAC BELL AND CONTACT BOB PICKARD AT 330-1771.
- J F/I IN-LINE FUSE HOLDER W/ 40A FUSE FOR IC SERVICE. SPLICE NEW WIRES TO EX PG&E SERVICE TO SUPPORT NEW IC.
- N EX SERVICE WIRES TO REMAIN.
- T LOWER EX CURB TO MEET NEW CURB RAMP.

AS BUILT DRAWING
APPROVAL SIGNATURES ON ORIGINAL CONTRACT DRAWINGS.


NO.	DATE	DESCRIPTION	BY	APP.
5/01		CHANGE ORDER #3 MSF- HOMERUN	JP	SL
3/01		CHANGE ORDER #2	SL	SL
2/00		ISSUED FOR BID	JM	NKS

TABLE OF REVISIONS
CHECK WITH TRACING TO SEE IF YOU HAVE LATEST REVISION

REFERENCE INFORMATION
& FILE NO. OF SURVEYS

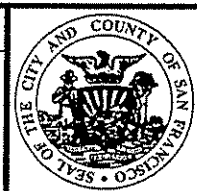

BUREAU OF ENGINEERING
DEPARTMENT OF PUBLIC WORKS
CITY AND COUNTY OF SAN FRANCISCO

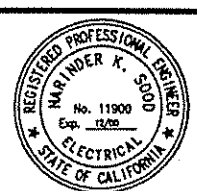

DESIGNED: DATE: 2/00
JM/DVS
DRAWN: DATE: 2/00
JS
CHECKED: DATE: 2/00
NKS

APPROVED
SECTION MANAGER DATE:
DIVISION MANAGER DATE:
CITY ENGINEER DATE:

SCALE:
1" = 10 feet
SHEET OF SHEETS
16 OF 89

OAK AND FELL STREETS
TRAFFIC SIGNAL UPGRADE
LYON AND OAK STREETS

SPECIFICATION NO. 1660N
DRAWING NO. E-8.0
FILE NO. 74157
REV. NO. 0

EXTERNAL REFERENCES: 634422.dwg
PLANT: 120
SCALE FACTOR: 120
PLANT: 120
ORIGIN: ELECTRICAL
FILE NAME: E-08-0.DWG
DATE:

