

CITY AND COUNTY OF SAN FRANCISCO

TABLE OF REVISIONS
CHECK WITH TRACING TO SEE IF YOU HAVE LATEST REVISION

CHECKED:

SL/BW

DATE:


CITY ENGINEER

1/0

5 OF 39

REV. NO.

MAIN ST. AND MISSION ST.

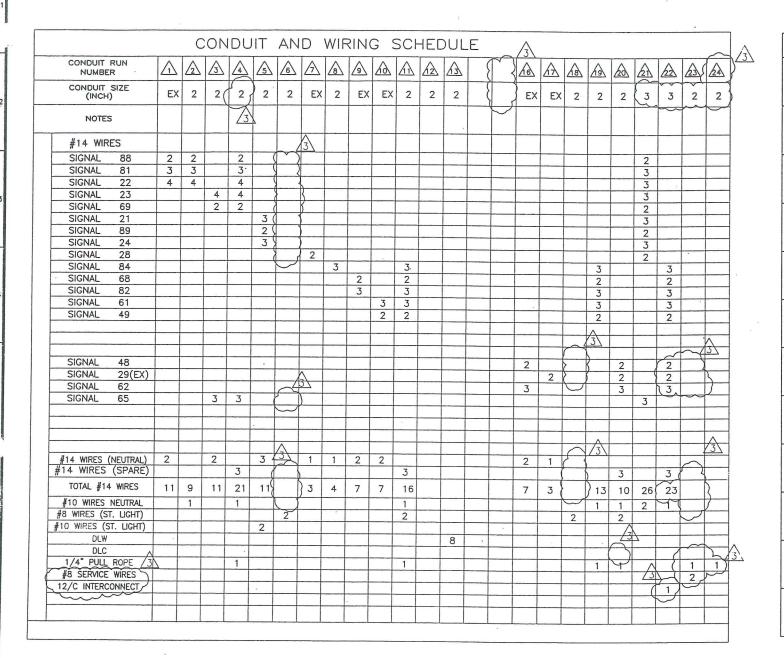

POLE AND EQUIPMENT SCHEDULE									
POLE No.	TYPE OF POLE	LUMINAIRE (HPS)	E VEHICLE SIGNAL			PEDESTRIAN SIGNAL			REMARKS
		VOLTAGE/ WATTS	No.	TYPE ·	MOUNTING (F/I)	No.	TYPE	MOUNTING (F/I)	KEMAKKS
1	EX 1-A (10')		22 81	4S12"LA 3S12"	TV-2-T	88	1S-IN	SP-1	W/LOUVER .
2	1-A (10')		23 65	4S12*LA 3S8*	TV-2-T	69	1S-IN	SP-1	
3	17-1-70 W/8' MAST ARM AND 6' LUMINAIRE ARM	200/240	21	3S12" 3S12"	SV-1-T MAS (END)	89	1S-IN	SP-1-SF	BACKPLATE
4	EX MUNI					28	1S-IN	SP-1-SF	
(5)	EX SL					29 (EX)	1S-IN		
6	1-A (10')		62	3S12*	TV-1-T	48	1S-IN	SP-1	
7	NOT USED		~~			3			-
8	NOT USED								d.
9	EX MUNI		61	3S12"	SV-1-T	49	1S-IN	SP-1-T	EXTERNAL CONDUIT
10	EX 1-A		82	358"	TV-1	68	1S-IN	SP-1	
11)	16-1-70 W/20' MAST ARM	(S)	. 84	3S12"	MAS				BACKPLATE BASEMENT

NOTE:

THIS AUTOCAD DRAWING HAS BEEN REVISED AND REPLOTTED SUBSEQUENT TO INTERNAL ENGINEERING APPROVAL AND SIGN-OFF. FOR THOSE SIGNATURES, SEE THE DRAWING PLOTTED AND ISSUED PREVIOUSLY DURING BIDDING. THE SIGNED DRAWING REMAINS VALID EXCEPT FOR THE CHANGES ONLY AS CLEARLY MARKED ON THIS DRAWING AND ISSUED UNDER THIS LATEST REVISION NUMBER AS SHOWN IN THE TABLE OF REVISIONS LOCATED AT THE LOWER LEFT CORNER OF THE DRAWING. ALL ISSUED REVISIONS SUBSEQUENT TO PREVIOUSLY PLOTTED DRAWING DURING BIDDING REMAIN VALID UNLESS SUPERSEDED BY LATER ISSUED REVISIONS. CHECK ALL ISSUED REVISIONS OF THIS DRAWING.

DETAIL NOTES:

F/I WITH INTEGRAL BALLAST AND PHOTOELECTRIC CONTROL F/I FUSE AND FUSE HOLDERS PER SPDPWSF FILE #49,092.

_			_		REFERENCE INFORMATION & FILE NO. OF SURVEYS
3	8/03	Pco#13, new IC foundation and related work	ET	BC	
/2	2/03	Pco#7, delete median island and related work		BC	
1	3/02	Pco#3, revised during construction layout 2/1/02	DSB	BC	
NO.	DATE	DESCRIPTION	BY	APP.	
	CHE	TABLE OF REVISIONS CK WITH TRACING TO SEE IF YOU HAVE LATEST REVISIO	IH		

BUREAU OF ENGINEERING

DEPARTMENT OF PUBLIC WORKS
CITY AND COUNTY OF SAN FRANCISCO

esigned: SB/DVS	/WL 1 / 0 1	APPROVED	SCALE: NONE	SOMA MISSION STREET		
RAWN:	DATE:	SECTION MANAGER DATE:	NONE	TRAFFIC SIGNAL UPGRADE		
SB	1/01	DIVISION MANAGER DATE:	SHEET OF SHEETS	MAIN ST AND MISSION ST		
HECKED:	DATE:		6 OF 39	TRAFFIC SIGNAL WORKS (SCHEDULES)		
L/BW	1/01	CITY ENGINEER DATE:				

SPECIFICATION NO. 1663N

E - 1.1

75,563 REV. NO. NAME: 1663nE-

DRAWING NO.

FILE NO.