


EDDY

MALL

POWELL

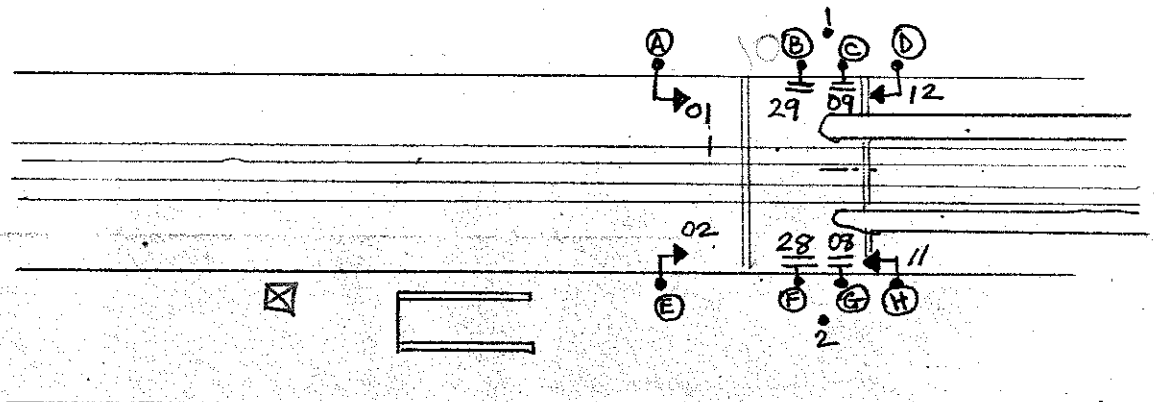

MARKET ST

DATE: 11-23-88

POLE	FUNC.	MAT'L	SIGNAL NO.	MAKE	NO. OF SECT.	SIZE	VISOR	B.P. OR LOUVERS	MOUNT	PED SIGNAL NO.	LEGEND	MESSAGE		MAKE	MOUNT
												ELEMENT	COLOR		
A	S	S	01	—	3	Red - 12" G+Y - 8"	FC8" x 12"	BP	*	29	I	IS-I	W/OR	ICC	T
B	S	S	02	—	3	Red - 12" G+Y - 8"	FC8" x 12"	BP	*	28	I	IS-I	W/OR	ICC	T
C	S	S	11	—	3	Red - 12" G+Y - 8"	FC8" x 12"	BP	*	08	I	IS-I	W/OR	ICC	T
D	S	S	12	—	3	Red - 12" G+Y - 8"	FC8" x 12"	BP	*	09	I	IS-I	W/OR	ICC	T
E	S	S													
F	S	S													
G	S	S													
H	S	S													
1	W/L	O													
2	W/L	O													

CONTROLLER CABINET SIZE : ^{EAGLE}ORDINARY BASE CABINET: NONE
COMMENTS : * MARKET STREET MASTARM SIGNALS