


# MARKET AT UNITED NATIONS PLAZA (MID-BLOCK 7th + 8th Sts.)

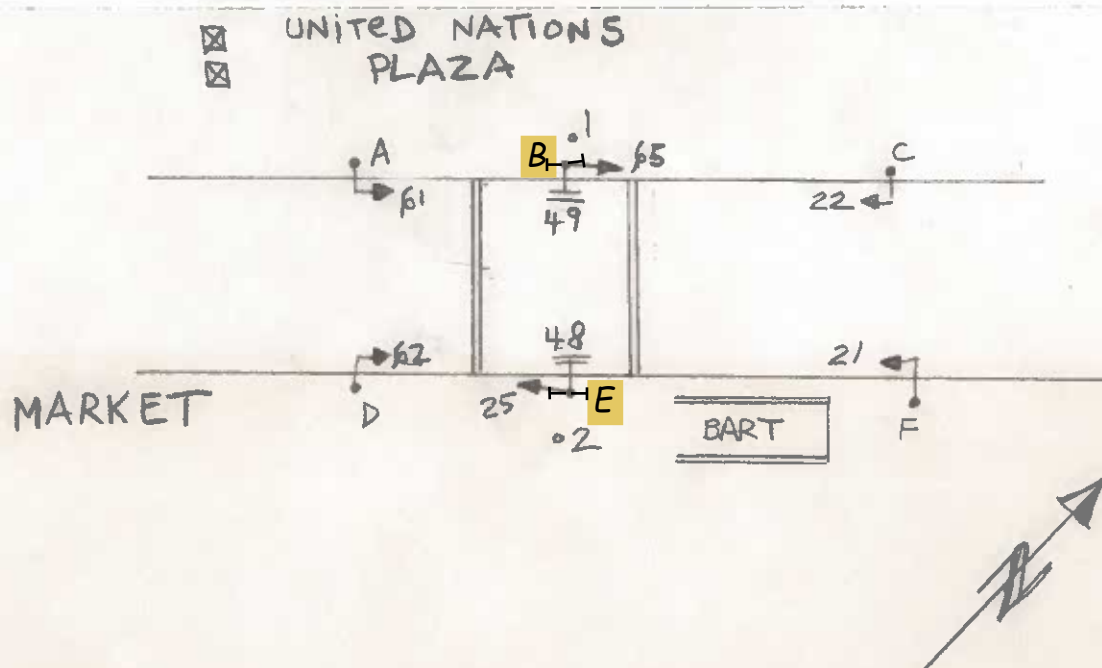

| POLE | FUNC. | MATL | SIGNAL NO. | MAKE | NO. OF SECT. | SIZE                  | VISOR | B.P. OR LOUVERS | MOUNT | PED SIGNAL NO. | LEGEND | MESSAGE ELEMENT | COLOR | MAKE | MO |
|------|-------|------|------------|------|--------------|-----------------------|-------|-----------------|-------|----------------|--------|-----------------|-------|------|----|
| A    | S     | S    | 61         | —    | 3            | R-12" G+Y-8" FC 12x8" | BP    | *               | *     | 38             | I      | IS-C            | W/OR  | ICC  | S  |
| B    | S     | S    | 62         | —    | 3            | R-12" G+Y-8" FC 12x8" | BP    | *               | *     | 39             | I      | IS-C            | W/OR  | ICC  | S  |
| C    | S     | S    | 22         | —    | 3            | R-12" G+Y-8" FC 12x8" | BP    | *               | *     |                |        |                 |       |      |    |
| D    | S     | S    | 21         | —    | 3            | R-12" G+Y-8" FC 12x8" | BP    | *               | *     |                |        |                 |       |      |    |
| E    | S     | S    | 65         | —    | 3            | 12" T                 | —     | —               | T     |                |        |                 |       |      |    |
| F    | S     | S    | 25         | —    | 3            | 12" T                 | —     | —               | T     |                |        |                 |       |      |    |
|      |       |      |            |      |              |                       |       |                 |       |                |        |                 |       |      |    |
|      |       |      |            |      |              |                       |       |                 |       |                |        |                 |       |      |    |
| 1    | L/M   | O    |            |      |              |                       |       |                 |       |                |        |                 |       |      |    |
| 2    | L/M   | O    |            |      |              |                       |       |                 |       |                |        |                 |       |      |    |
|      |       |      |            |      |              |                       |       |                 |       |                |        |                 |       |      |    |
|      |       |      |            |      |              |                       |       |                 |       |                |        |                 |       |      |    |
CONTROLLER CABINET SIZE : ORDINARY BASE CABINET : 1-YES

COMMENTS : \* MARKET STREET MASTARM SIGNALS

SRC 2021-293 - ADD WEST FACING APS ON POLES B AND E. UPDATE EAST FACING APS PER FIELD. -M.TAMIN, 09/15/2022