


FILE NAME: E-24  
ORIGIN: ELECTRICAL  
DATE: --/--/--

LIMITS: (0,0), (680',440')  
PLOT SCALE: 1=240

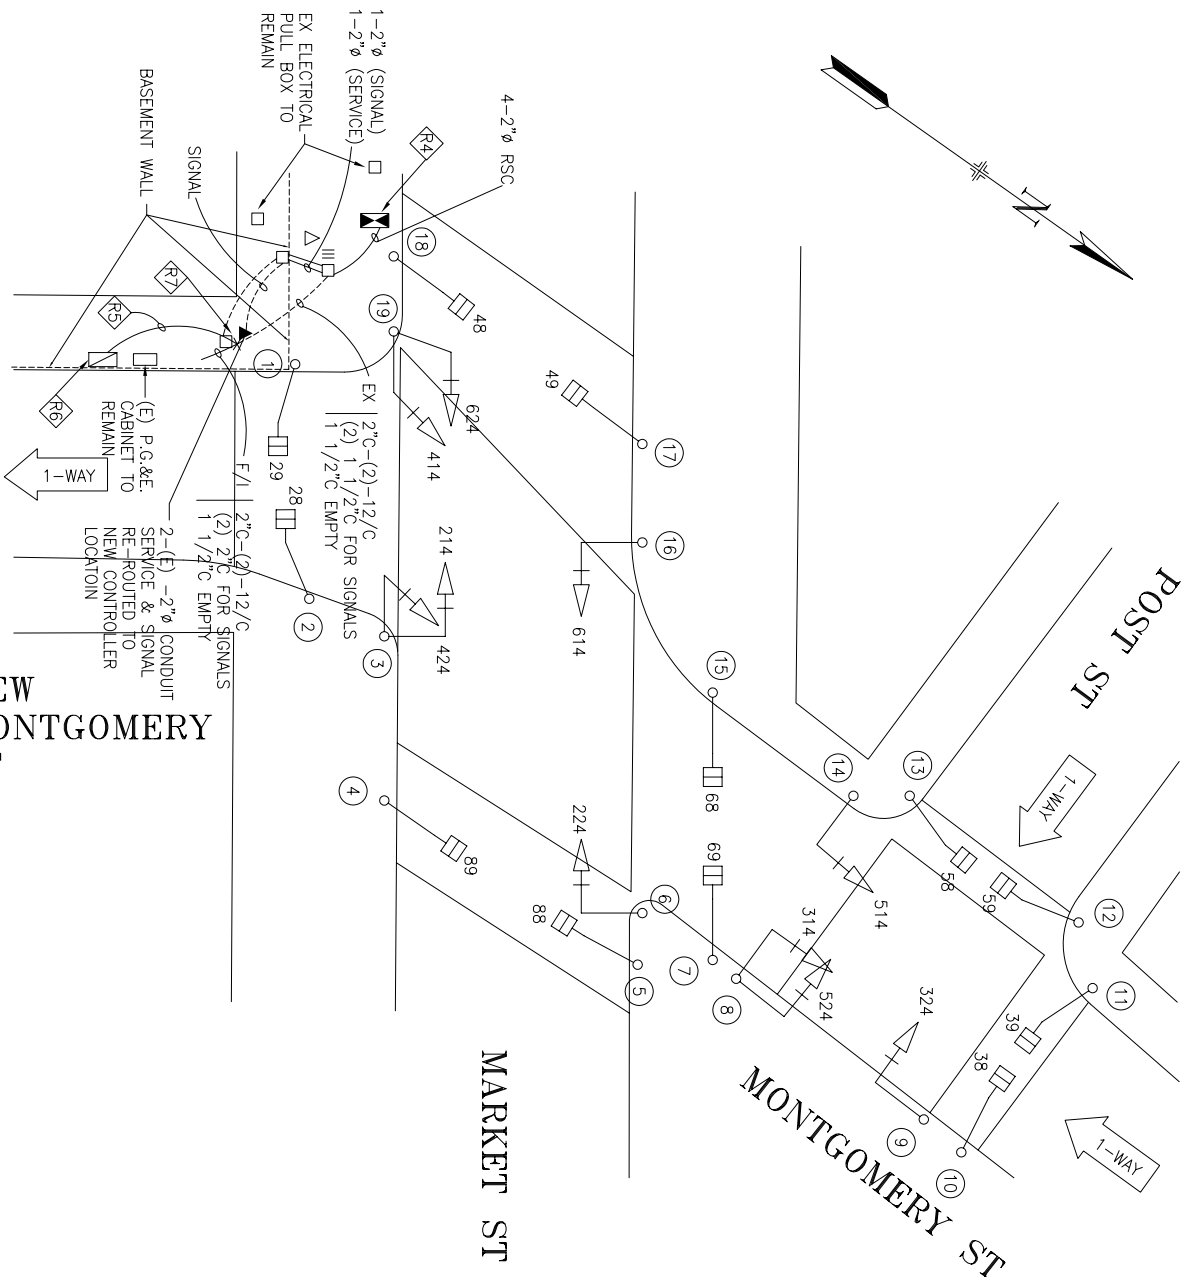


## PHASE SEQUENCE


G	Y	R			
R	G	Y	R		
R					
R		G		Y	R
WM	FRH	RH	WM		
RH		WM	FRH		
RH		WM	FRH		
WM		FRH	RH	WM	
WM	FRH	RH			
RH	WM	FRH	RH		

MARKET  
POST  
MONTGOMERY @ POST  
MONTGOMERY @ MARKET  
PED CROSSING – POST  
PED CROSSING – MARKET WEST  
PED CROSSING – MARKET EAST  
PED CROSSING – MONTGOMERY @ POST  
PED CROSSING – MONTGOMERY @ MARKET  
PED CROSSING – NEW MONTGOMERY

## DETAIL NOTES

- R/S EX CONTROLLER, R/C FOUNDATION, F/I NEW CONTROLLER FOUNDATION FOR TYPE 'M' CABINET AT THE SAME LOCATION.
- SEE DETAIL 
- R5 INTERCEPT EX CONDUITS AT APPROXIMATELY 4 FT. FROM EX CONTROLLER. RUN TEMPORARY CONDUITS AND CONDUCTORS TO TEMPORARY CONTROLLER TO MAINTAIN THE EX TRAFFIC SIGNAL SYSTEM. R/C TEMPORARY CONDUITS AND WIRES AT COMPLETION OF WORK IN THIS INTERSECTION. RESTORE SIDEWALK TO MATCH EX.
- R6 F/I TEMPORARY TRAFFIC SIGNAL CONTROLLER. CONNECT TEMPORARY WIRES TO MAINTAIN THE EX TRAFFIC SIGNAL SYSTEM. R/S TEMPORARY CONTROLLER AND R/C FOUNDATION AT COMPLETION OF WORK IN THIS INTERSECTION. RESTORE SIDEWALK TO MATCH EX.
- R7 COUPLE NEW CONDUITS WITH EX CONDUITS. RE-PULL EX CONDUCTORS TO NEW CONTROLLER. DO NOT SPICE CONDUCTORS.

## PHASE DIAGRAM

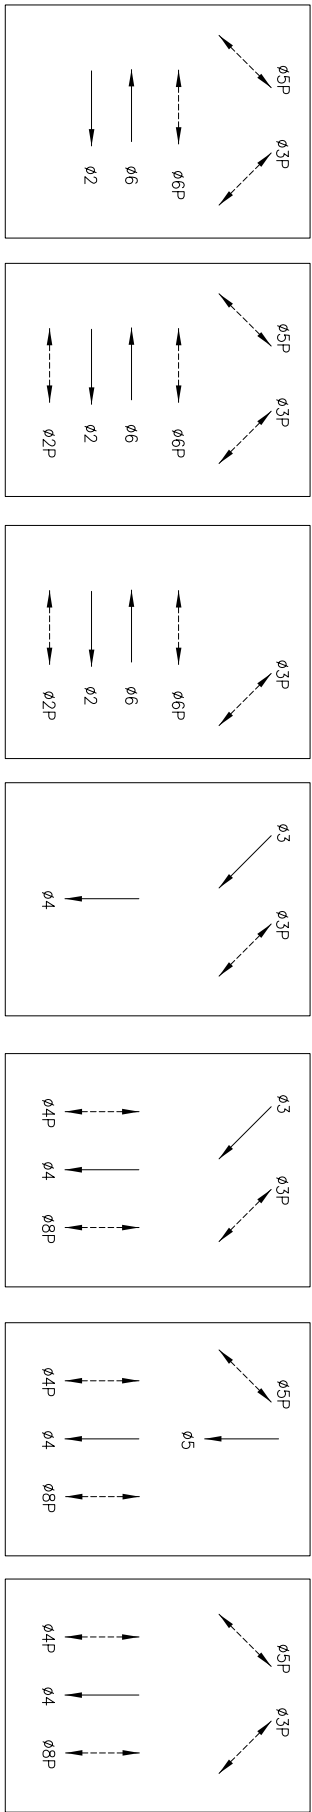

# AS BUILT DRAWING

APPROVAL SIGNATURES ON ORIGINAL CONTRACT DRAWINGS.

NO.	DATE	DESCRIPTION	LS	SL	BY	APP.
Δ	7/19/00	AS-BUILT				
CHECK WITH TRACING TO SEE IF YOU HAVE LATEST REVISION						
TABLE OF REVISIONS						
REFERENCE INFORMATION & FILE NO. OF SURVEYS						
						
<p align="center">BUREAU OF ENGINEERING</p> <p align="center">DEPARTMENT OF PUBLIC WORKS</p> <p align="center">CITY AND COUNTY OF SAN FRANCISCO</p>						
DESIGNED:	DATE:	APPROVED:	SCALE:			
NO/DS	5/97		1"=20'-0"			
DRAWN:	DATE:	SECTION MANAGER	SHEET OF SHEETS			
CS	5/97	DIVISION MANAGER	24 OF 40			
CHECKED:	DATE:	CITY ENGINEER				
CF	5/97					
VARIOUS LOCATIONS			TRAFFIC SIGNAL UPGRADE - CONTRACT 23			
SAN FRANCISCO, CA			MARKET ST & MONTGOMERY ST			
FILE NO.			DRAWING NO.			
66.671			E-24			
REV. NO.						