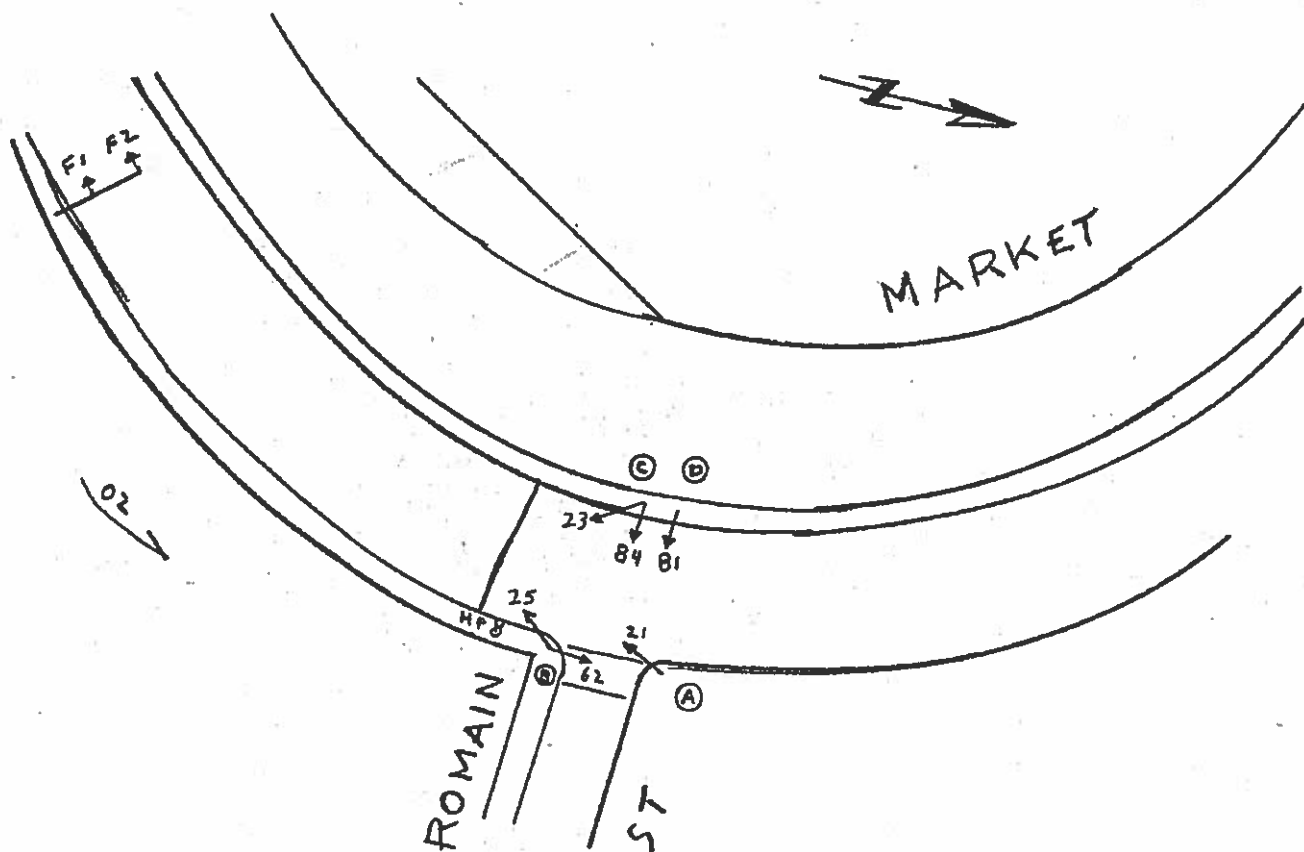


[illegible]

COMMENTS: SRC. 2015 - 164 CHANGE MEDIAN SIGNALS TO 12"
SIGNALS 21, 25, 62 ARE 12" PER FIELD CHECK.