


MARKET, SANSOME, SUTTER

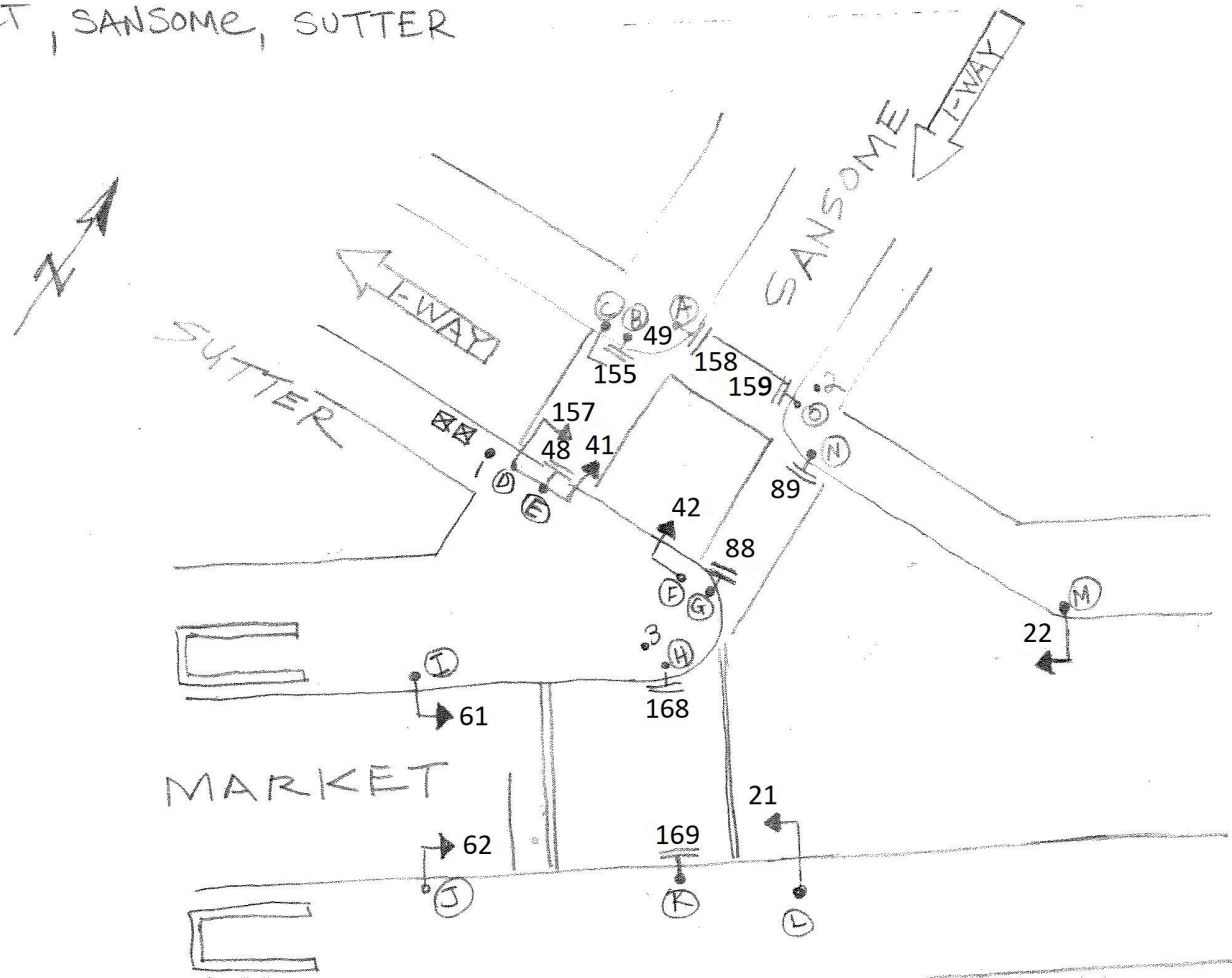

DATE: 11-6-13

POLE	FUNC.	MAT'L	SIGNAL NO.	MAKE	NO. OF SECT.	SIZE	VISOR	B.P. OR LOUVERS	MOUN'T	PED SIGNAL NO.	LEGEND	MESSAGE		MAKE	MOU
												ELEMENT	COLOR		
A	S	S	155	—	3	8"	FC 8"	BP	*	49	I	IS-I	W/OR	ICC	T
B	S	S	157	—	3	8"	FC 8"	BP	*	48	I	IS-I	W/OR	ICC	T
C	S	S	41	—	3	8"	FC 8"	BP	*	168	I	IS-I	W/OR	ICC	T
D	S	S	42	—	3	8"	FC 8"	BP	*	169	I	IS-I	W/OR	ICC	T
E	S	S	61	—	3	8"	FC 8"	BP	*	88	I	IS-I	W/OR	ICC	T
F	S	S	62	—	3	8"	FC 8"	BP	*	89	I	IS-I	W/OR	ICC	T
G	S	S	21	—	3	12" R 8" G+Y	FC 12+8"	BP	*	159	I	IS-I	W/OR	ICC	T
H	S	S	22	—	3	12" R 8" G+Y	FC 12+8"	BP	*	158	I	IS-I	W/OR	ICC	T
I	S	S													
J	S	S													
K	S	S													
L	S	S													
M	S	S													
N	S	S													
O	S	S													

1	M	S
2	M/L	S
3	L	O

CONTROLLER CABINET SIZE : 1- ORDINARY 1- LARGE BASE CABINET: 1- NO 1- YES

COMMENTS : * MARKET STREET MASTARM SIGNALS

06/29/22

Updated all signal numbers to conform to latest timing card phasing system

M. Tamin