

POLE AND EQUIPMENT SCHEDULE										
POLE No.	TYPE OF POLE	VEHICLE SIGNAL					PEDESTRIAN SIGNAL			REMARKS
		No.	TYPE	MOUNTING	VISORS	LOUVERS/BP	No.	TYPE	MOUNTING	
①	1-A (7')						88	1S-COUNT	TP-1	APS (4W)
②	MARKET STREET POLE WITH 7' MAST ARM	62 25	3S12" 4S12" GRA	CUSTOM SV-1-T		LOUVER ON GREEN 62				①- CIRCULAR BP NETWORK RADIO
③	MARKET STREET POLE WITH 7' MAST ARM	64	3S12"	CUSTOM						②- CIRCULAR BP
④	1-A (10')	32	3S12"	TV-1-T			89	1S-COUNT	SP-1	APS (4W)
⑤	1-A (10')	31	3S12"	TV-1-T			49	1S-COUNT	SP-1	APS (4W)
⑥	MARKET STREET POLE WITH 7' MAST ARM	22	3S12"	CUSTOM						④- CIRCULAR BP NETWORK RADIOS
⑦	MARKET STREET POLE WITH 7' MAST ARM	24 21	3S12" 4S12" GRA	CUSTOM SV-1-T		LOUVER LOUVER RYG				③- CIRCULAR BP NETWORK RADIO
⑧	1-A (7')						48	1S-COUNT	TP-1	APS (4W)
⑨	1-A (10')						28	1S-COUNT	SP-1	APS (4W)
⑩	1-A (7')						29	1S-COUNT	TP-1	APS (4W)

09/02/22	CONVERTED FROM CONTRACT PLAN NO. 1195N; ADDED SIGNAL 25 AND CONVERTED SIGNAL 21 TO 4-SECTION PER SRC 2022-167	E. OROZCO	K.KWONG		
NO.	DATE	DESCRIPTION	BY	APPROVED	
TABLE OF REVISIONS CHECKOUT DRAWING THROUGH THE SID CUSTODIAN FOR THE LATEST REVISION					



SFMTA

DRAWN BY:	DATE:
E. OROZCO	2/2023
CHECKED BY:	DATE:
K. KWONG	2/2023

SCALE
AS SHOWN
SHEET OF SHEETS
1 OF 2

TRAFFIC SIGNAL INVENTORY DIAGRAM
MARKET STREET AND SPEAR STREET

CNN NO:
30726000
REV NO:
0

CONDUIT AND WIRING SCHEDULE																				
CONDUIT RUN NUMBER	1	2	3	4	5	6	7	8	9	10	11	12	13	14	15	16	17	18	19	20
CONDUIT SIZE (INCH)	2	2	2	2	2	2	2	2	2	2	2	2	2	2	2	2	2	2	2	1.5
NOTES																B				
	EX	EX	EX	EX	EX			EX	EX											
VEHICLE SIGNAL 22	3		3				3							3						
VEHICLE SIGNAL 31		3	3				3							3						
PEDESTRIAN SIGNAL 49		2	2				2							2						
VEHICLE SIGNAL 21				3			3							3						
VEHICLE SIGNAL 24				3			3							3						
PEDESTRIAN SIGNAL 48					2		2							2						
PEDESTRIAN SIGNAL 28						2	2							2						
VEHICLE SIGNAL 64								3		3					3					
VEHICLE SIGNAL 32									3	3					3					
PEDESTRIAN SIGNAL 89									2	2					2					
VEHICLE SIGNAL 25											3				3					
VEHICLE SIGNAL 62											3				3					
PEDESTRIAN SIGNAL 88												2			2					
PEDESTRIAN SIGNAL 29													2		2					
#14 NEUTRAL																				
#14 SPARE			3				3			3				3	3					
TOTAL #14 WIRES	3	5	11	6	2	2	21	3	5	11	6	2	2	21	21					
#10 WIRES NEUTRAL	1	1	1	2	1	1	2	2	1	1	1	1	1	2	2					
#10 WIRES STREET LIGHT																				
#8 WIRES STREET LIGHT																				
#8 WIRES (120 V SERVICE)																	1	1	1	2
INTERCONNECT 12C CABLE																				

DETAIL NOTES:

B SPARE 2" CONDUIT WITH 1/4" NYLON PULL ROPE.

09/02/22	CONVERTED FROM CONTRACT PLAN NO. 1195N; ADDED SIGNAL 25 AND CONVERTED SIGNAL 21 TO 4-SECTION PER SRC 2022-167	E. OROZCO	K. KWONG	
NO.	DATE	DESCRIPTION	BY	APPROVED
TABLE OF REVISIONS CHECKOUT DRAWING THROUGH THE SID CUSTODIAN FOR THE LATEST REVISION				




SFMTA

DRAWN BY:	DATE:
E. OROZCO	12/2022
CHECKED BY:	DATE:
K. KWONG	12/2022


SCALE
AS SHOWN
SHEET OF SHEETS
2 OF 2

TRAFFIC SIGNAL INVENTORY DIAGRAM
MARKET STREET AND SPEAR STREET CONDUIT AND WIRING SCHEDULE


CNN NO:
30726000
REV NO:
0

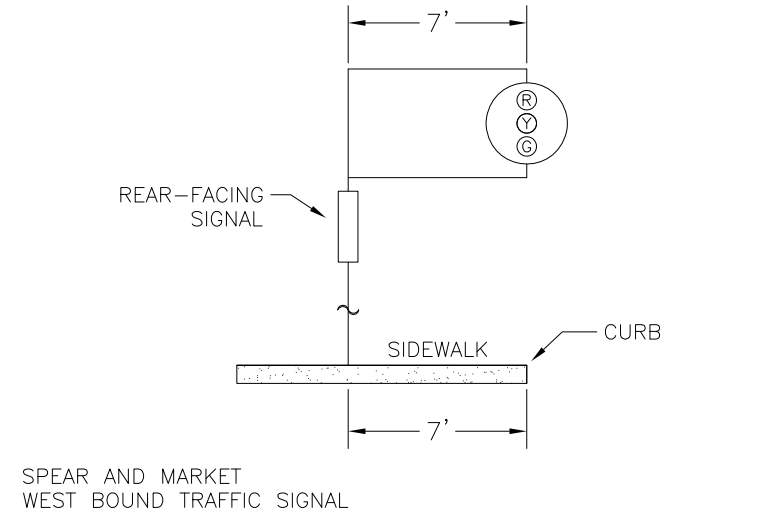


DETAIL 1
NOT TO SCALE

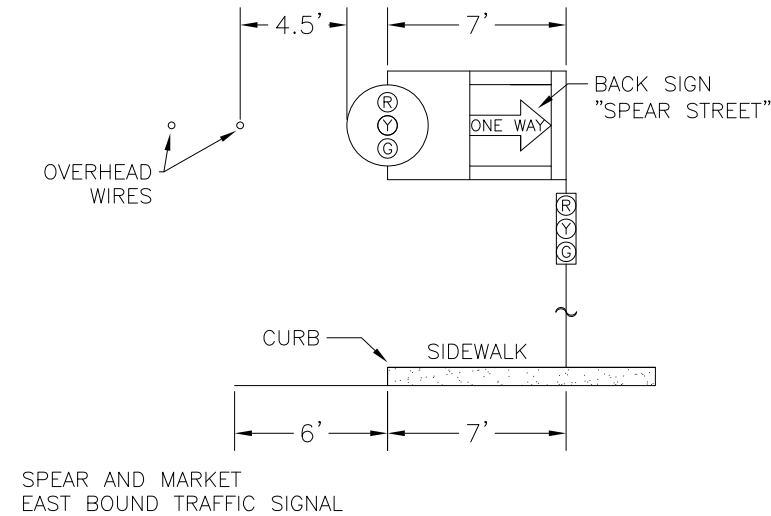

DETAIL 3
NOT TO SCALE

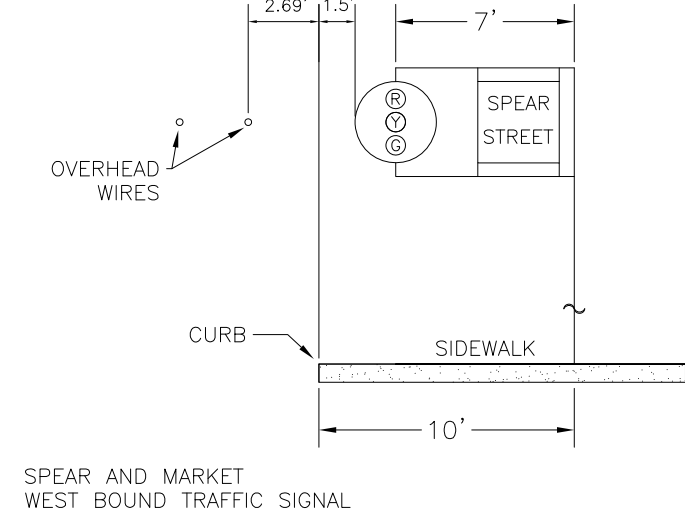

DETAIL 2
NOT TO SCALE

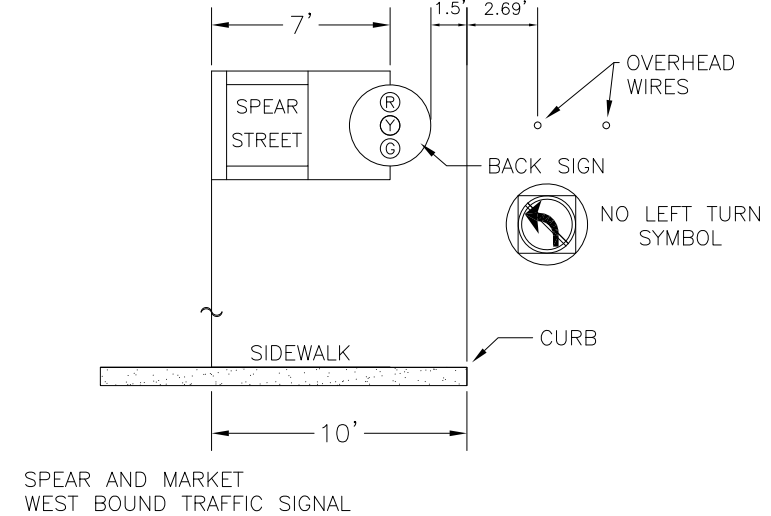

DETAIL 4
NOT TO SCALE