



MARKET & VALENCIA

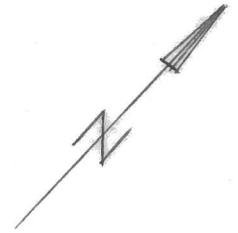

MARKET

ST.

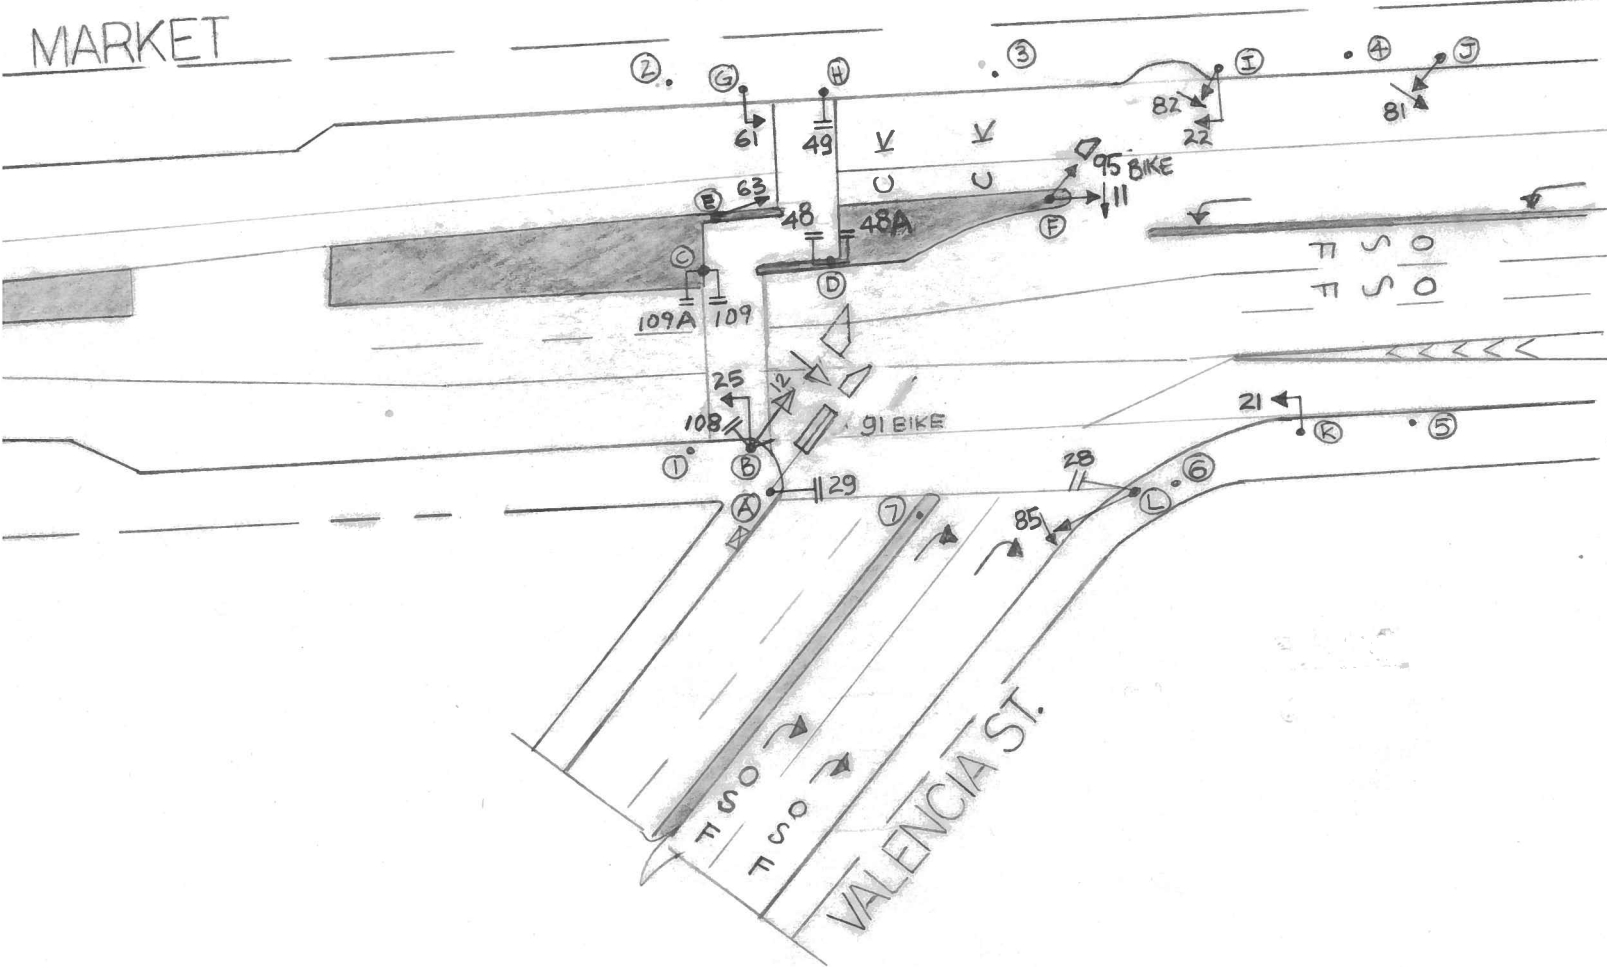

01-29-2019

Market / Valencia

POLE	FUNC.	MAT'L	SIGNAL NO.	MAKE	NO. OF SECT.	SIZE	VISOR	B.P. OR LOUVERS	MOUN'T	PED SIGNAL NO.	LEGEND	MESSAGE		MAKE	MOUN'T
												ELEMENT	COLOR		
A	S	S	11	TCT	3	R, Y, G, 12"	Tunnel	-	T	28	I	1S-I	W/OR	ICC	S
B	S	S	12	TCT	3	R, Y, G, 12"	Tunnel	ANGLED VISOR	S	29	I	1S-I	W/OR	ICC	T
C	S	S	21	TCT	3	12"	FC	BP	A	108	I	1S-I	W/OR	ICC	S
D	S	S	22	TCT	3	12"	FC	BP	A	49	I	1S-I	W/OR	ICC	T
E	S	S	25	TCT	3	8"	FC	BP	A	109	I	1S-I	W/OR	ICC	T
F	S	S	61	TCT	3	12"	FC	BP	A	109A	I	1S-I	W/OR	ICC	T
G	S	S	63	TCT	3	12"	FC	LOUVERS	T	48	I	1S-I	W/OR	ICC	T
H	S	S	81	TCT	3	R, Y, G, 12"	Tunnel	BP	T	48A	I	1S-I	W/OR	ICC	T
I	S	S	82	TCT	3	R, Y, G, 12"	Tunnel	BP	S						
J	S	S	85	TCT	3	R, Y, G, 12"	Tunnel	-	S						
K	S	S	91	-	3	BIKE R.Y.G. 12"	Tunnel	Angled Visor	S						
L	L	S	95	-	3	BIKE R.Y.G. 12"	Tunnel	Angled Visor	S						

POLE	FUNC.	MAT'L	SIGNAL NO.	MAKE	NO. OF SECT.	SIZE	VISOR	B.P. OR LOUVERS	MOUN'T	PED SIGNAL NO.	LEGEND	MESSAGE		MAKE	MOUN'T
												ELEMENT	COLOR		
1	L	S													
2	L	S													
3	L	S													
4	L	S													
5	M	S													
6	M	S													
7	L	S													

CONTROLLER CABINET SIZE : Ordinary BASE CABINET: Yes

COMMENTS : PER SRC 2019-009, MOVE EXISTING SIDE-MOUNTED BIKE SIGNAL 91 FROM POLE B TO POLE A. ADD ANGLED VISOR FOR SIGNAL 12.

A.UY 1/29/2019