


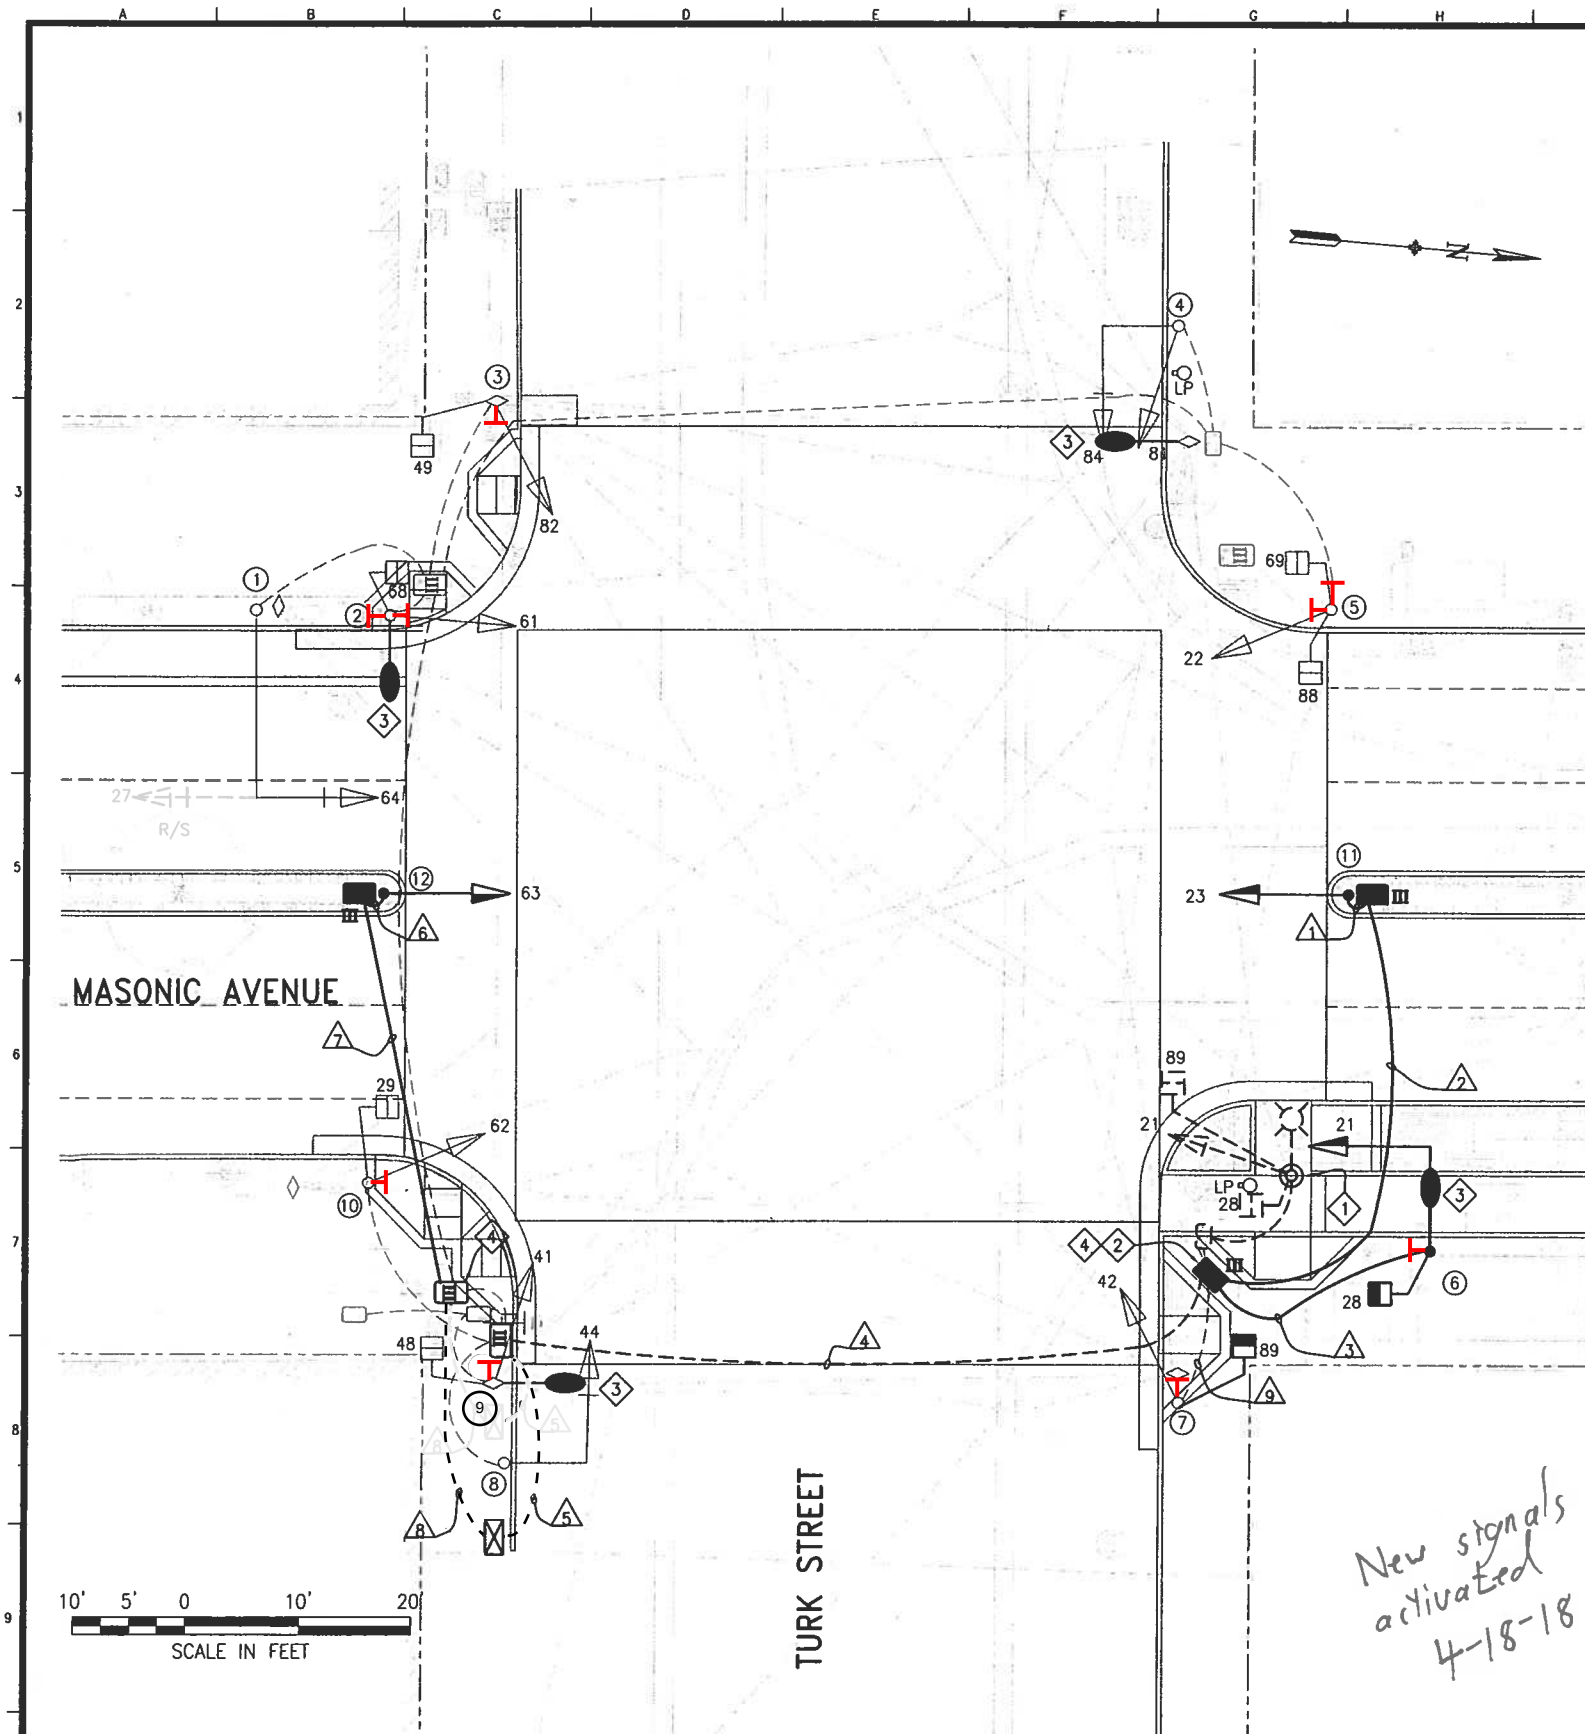

POLE AND EQUIPMENT SCHEDULE										
POLE No.	TYPE OF POLE	LUMINAIRE VOLTAGE/WATTAGE	VEHICLE SIGNAL				PEDESTRIAN SIGNAL			REMARKS
			No.	TYPE	MOUNTING	VISORS	LOUVERS/BP	No.	TYPE	MOUNTING
①	16-3-100 WITH 20' MAST ARM		64	3S12"	MAS	T	BP			
②	SL		61	3S12"	SV-1-T	T		68	1S-COUNT	SP-1
③	MUNI		82	3S12"	SV-1-T	T		49	1S-COUNT	SP-1
④	16-1-100 WITH 8' MAST ARM		81 84	3S12" 3S12"	SV-1-T MAS	T T	BP			
⑤	1-A (13')		22	3S12"	TV-1-T	T		69 88	1S-COUNT 1S-COUNT	SP-1 (22") SP-1-SF (12")
⑥	16-1-100 8' MAST		21	3S12"	MAS	T	BP	28	1S-COUNT	SP-1
⑦	1-A (10')		42	3S12"	TV-1-T	T		89	1S-COUNT	SP-1
⑧	16-1-100 WITH 8' MAST ARM		44	3S12"	MAS	T	BP			PLACE 12 FEET EAST OF POLE 9
⑨	MUNI SL		41	3S12"	SV-1	T		48	1S-COUNT	SP-1
⑩	1-A (13')		62	3S12"	TV-1-T	T		29	1S-COUNT	SP-1
⑪	1-A (15')		23	3S12"	SV-1-T	T				VEHICLE HEAD MOUNTED @ 13'
⑫	1-A (15')		63	3S12"	SV-1-T	T				VEHICLE HEAD MOUNTED @ 10'

SHEET NOTES

- R/S STREET LIGHT FIXTURE & POLE, VEHICLE SIGNAL, AND PED SIGNAL. R/C FOUNDATION CUT 36" BELOW FINISHED GRADE.
- INTERCEPT EXISTING CONDUITS AT NEW PULL BOX LOCATION. REWIRE AND REUSE EXISTING WIRES IF FEASIBLE, ELSE PROVIDE NEW WIRES FOR ALL AFFECTED DEVICES.
- STREETLIGHT FIXTURE TO BE PROVIDED BY STREETLIGHT CONTRACTOR SEE E-1.3 DRAWINGS FOR STREETLIGHT FIXTURE DETAILS.
- SPLICE NEW #14 NEUTRAL WIRES TO EXISTING #10 NEUTRAL.

CONDUIT AND WIRING SCHEDULE (FURNISH AND INSTALL CONDUIT)


CONDUIT RUN NUMBER		1	2	3	4	5	6	7	8	9
CONDUIT SIZE (INCH)		2	2	2	2	2	2	2	2	UNK
NOTES	VEHICLE SIGNAL 23	3	3		3	3				
	VEHICLE SIGNAL 21			3	3	3				
	PED SIGNAL 28			2	2	2				
	PED SIGNAL 89				2	2				2
	VEHICLE SIGNAL 63						3	3	3	
	#14 NEUTRAL	1		2			1			1
	#14 SPARE		3					3		
	TOTAL #14 WIRES	4	6	7	10	10	4	6	3	3
	#10 NEUTRAL		1					1		
	#10 WIRES STREET LIGHT			2						
	#6 BSCW (SEE DRAWING E-0.3)									

NO.	DATE	DESCRIPTION	BY	APP.
1	3/27/22	Install APS (SRC 2021-058) Per Field: update cabinet & pole 8 location, 82 mounting, remove 27 from eqp sched. E.Luu, G. deLeon		

REFERENCE INFORMATION
& FILE NO. OF SURVEYS



INFRASTRUCTURE DIVISION
DEPARTMENT OF PUBLIC WORKS
CITY AND COUNTY OF SAN FRANCISCO

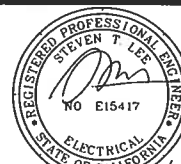

DESIGNED: DATE: 8/21/2015
W.CHAN
DRAWN: DATE: 8/21/2015
W.CHAN
CHECKED: DATE: 8/21/2015
S.LEE

APPROVED: DATE: 8/27/15
SECTION MANAGER
DATE: 8/27/15
DEPUTY DIVISION MANAGER
DATE: 11/4/15
DIVISION MANAGER

SCALE: AS SHOWN
SHEET OF SHEETS OF

**MASONIC AVENUE
STREETSCAPE IMPROVEMENTS**
**MASONIC AVENUE AND TURK STREET
TRAFFIC SIGNAL WORK**

CONTRACT NO. 2370J
DRAWING NO. ET-5.0
FILE NO. 101,273
REV. NO. 1