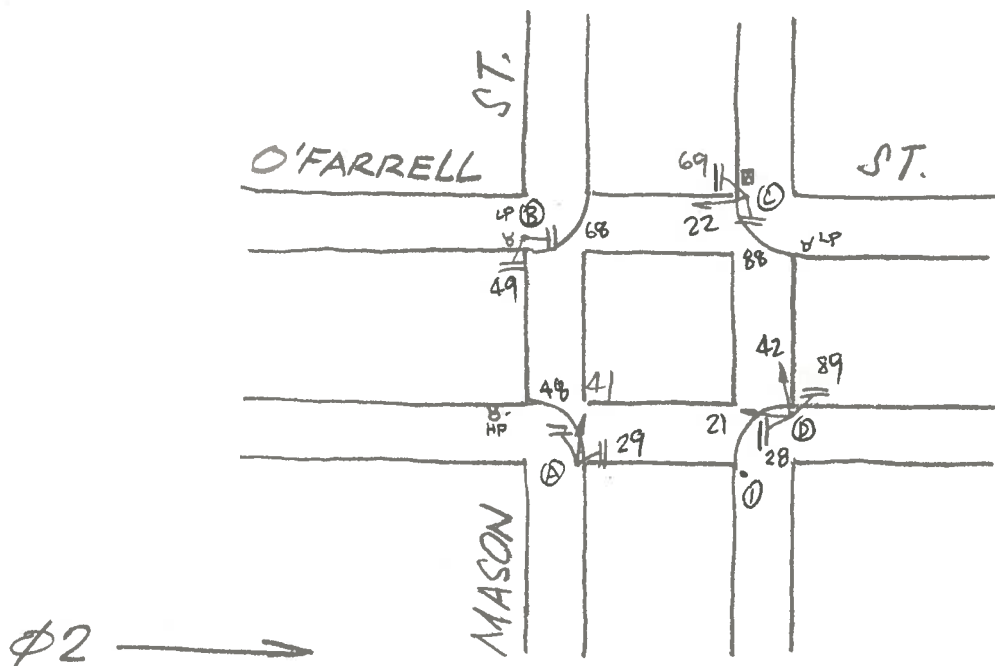


[illegible]

COMMENTS: SIGNAL 41 REPLACED W/ 3512" PER FIELD
-J. HORNOSTEL