


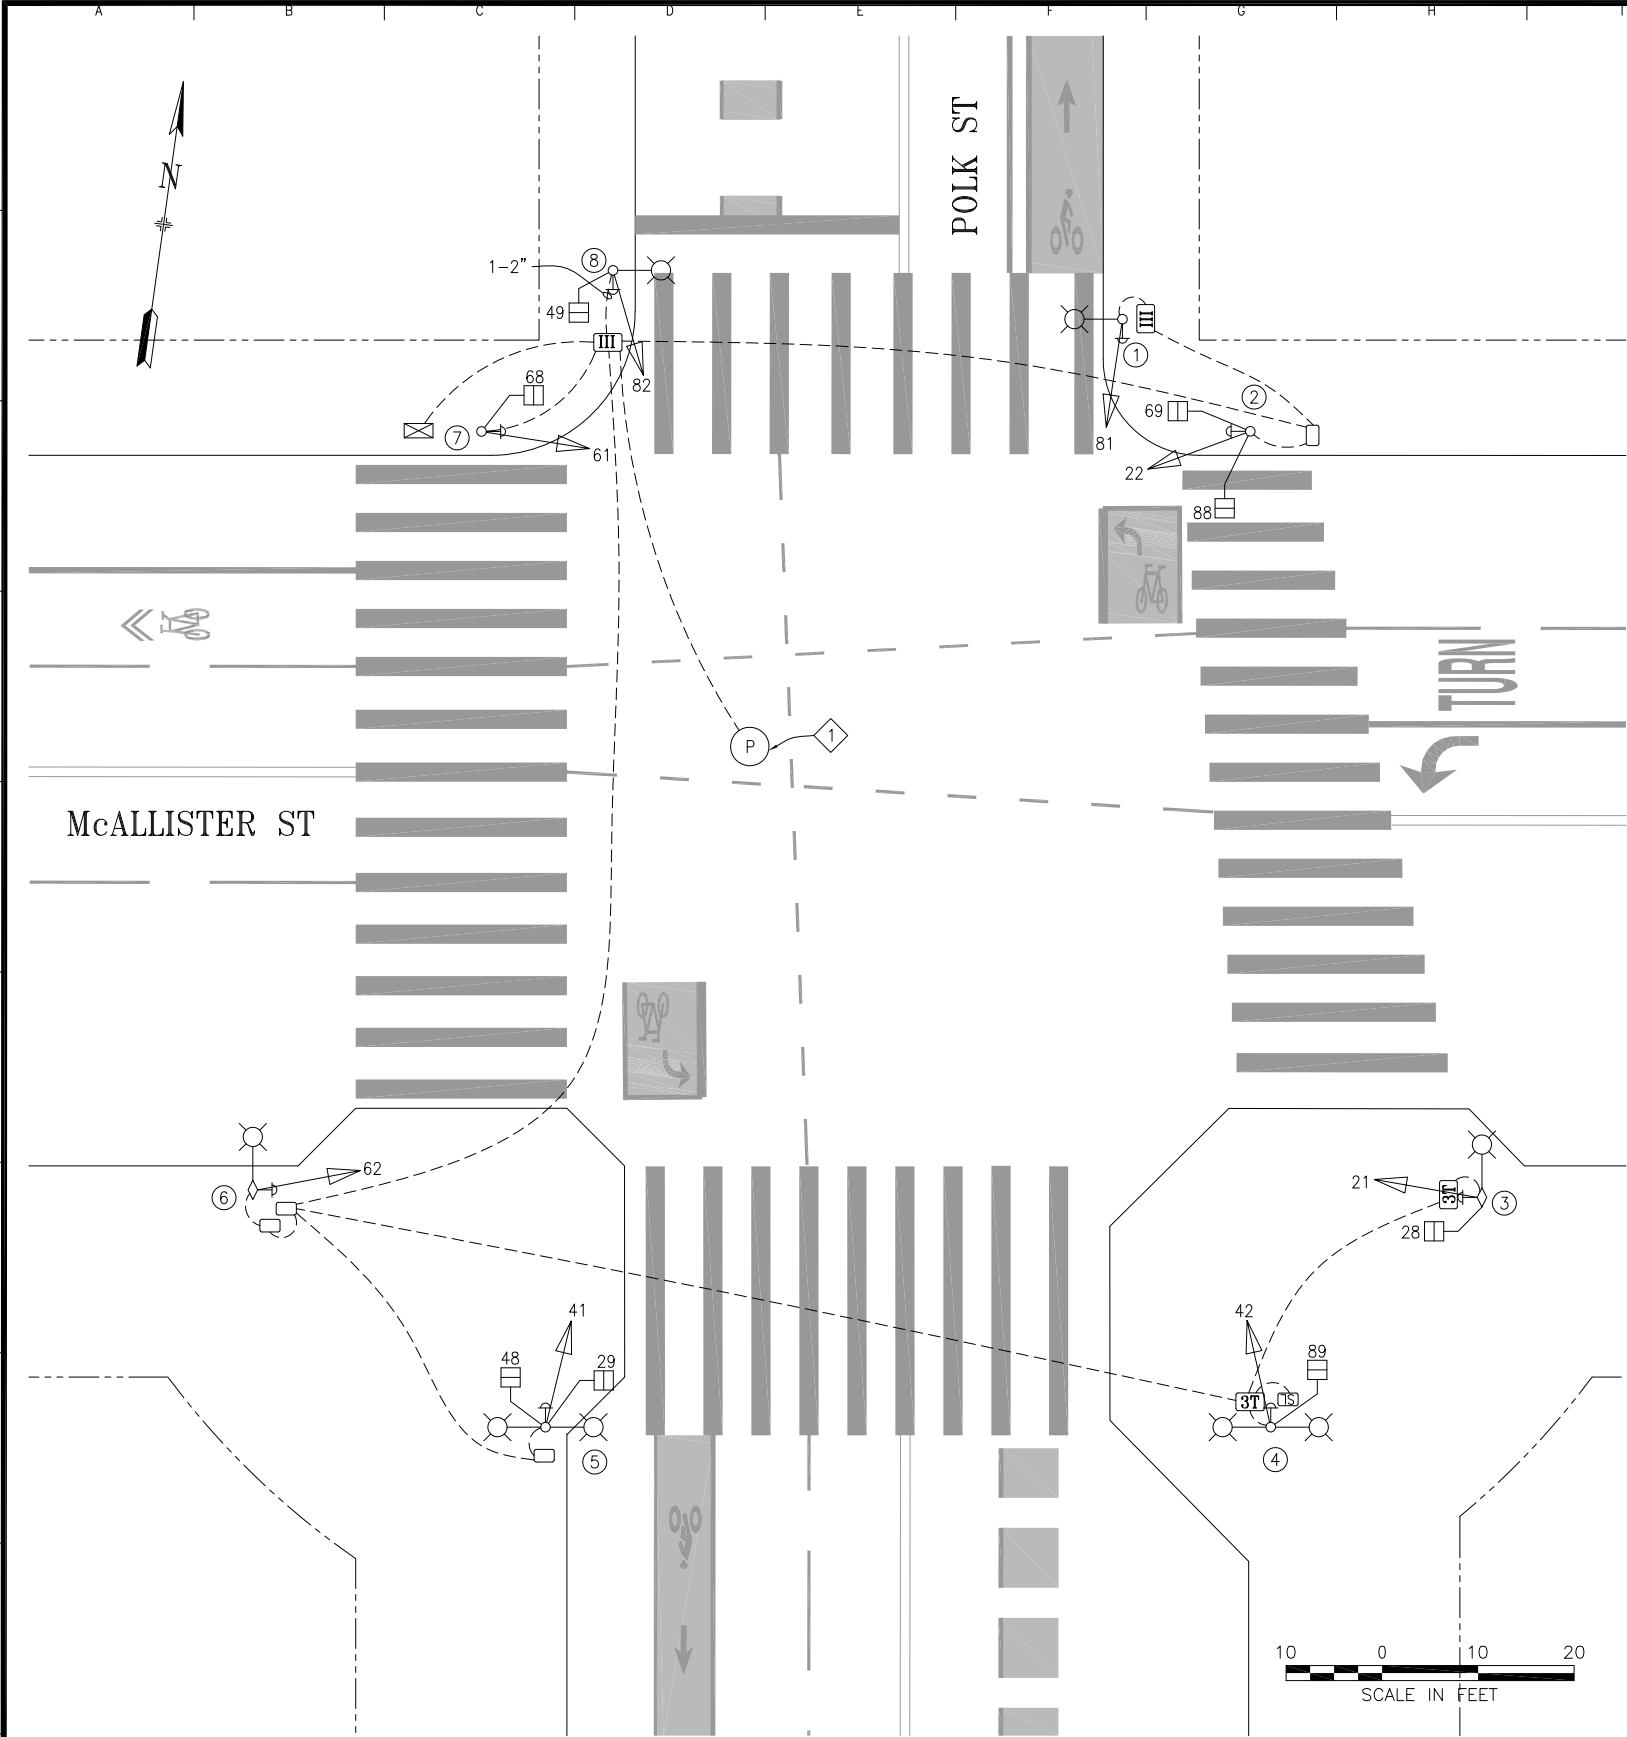

POLE AND EQUIPMENT SCHEDULE											
POLE No.	TYPE OF POLE	LUMINAIRE VOLTAGE/ WATTAGE	VEHICLE SIGNAL					PEDESTRIAN SIGNAL			REMARKS
			No.	TYPE	MOUNTING	VISORS	LOUVERS	No.	TYPE	MOUNTING	
①	ORNAMETNAL STREET LIGHT		81	3S12"	SV-1-T	T					APS-4W
②	1-A(10')		22	3S12"	TV-1-T	T		69 88	1S-COUNT 1S-COUNT	SP-1 SP-1	APS-4W
③	MUNI POLE WITH 6' LA		21	3S12"	SV-1-T	T		28	1S-COUNT	SP-1	APS-4W
④	ORNAMENTAL STREET LIGHT		42	3S12"	SV-1-T	T		89	1S-COUNT	SP-1	APS-4W
⑤	ORNAMENTAL STREET LIGHT		41	3S12"	SV-1-T	T		29 48	1S-COUNT 1S-COUNT	SP-2-T-SF	APS-4W
⑥	MUNI POLE WITH 6' LA		62	3S12"	SV-1-T	T					APS-4W
⑦	MARBELITE(10')		61	3S12"	TV-1-T	T		68	1S-COUNT	SP-1	MOUNT 61 @ 45' FROM CURB APS-4W
⑧	ORNAMENTAL STREET LIGHT		82	3S12"	SV-1-T	T		49	1S-COUNT	SP-1	APS-4W

SHEET NOTES:

① PG&E SERVICE FUSED TO LEAD CABLE & FED FROM PG&E MANHOLE IN MIDDLE OF INTERSECTION

0	8/9/18	PER 21256J: NEW POLE 8; REPLACE POLE 1; RELOCATE POLE 5; CONVERTED FROM 2126J AS-BUILTS	J.HORNPOSTEL	G.DeLEON	
NO.	DATE	DESCRIPTION	BY	APPROVED	
TABLE OF REVISIONS CHECKOUT DRAWING THROUGH THE SID CUSTODIAN FOR THE LATEST REVISION					



SFMTA

DRAWN BY: J. HORNPOSTEL CHECKED BY: G. DeLEON	DATE: 9/2021 DATE: 9/2021	SCALE AS SHOWN	TRAFFIC SIGNAL INVENTORY DIAGRAM	CNN NO: 24462000
		SHEET OF SHEETS 01 OF 01	McALLISTER STREET AND POLK STREET	REV NO:
				0