


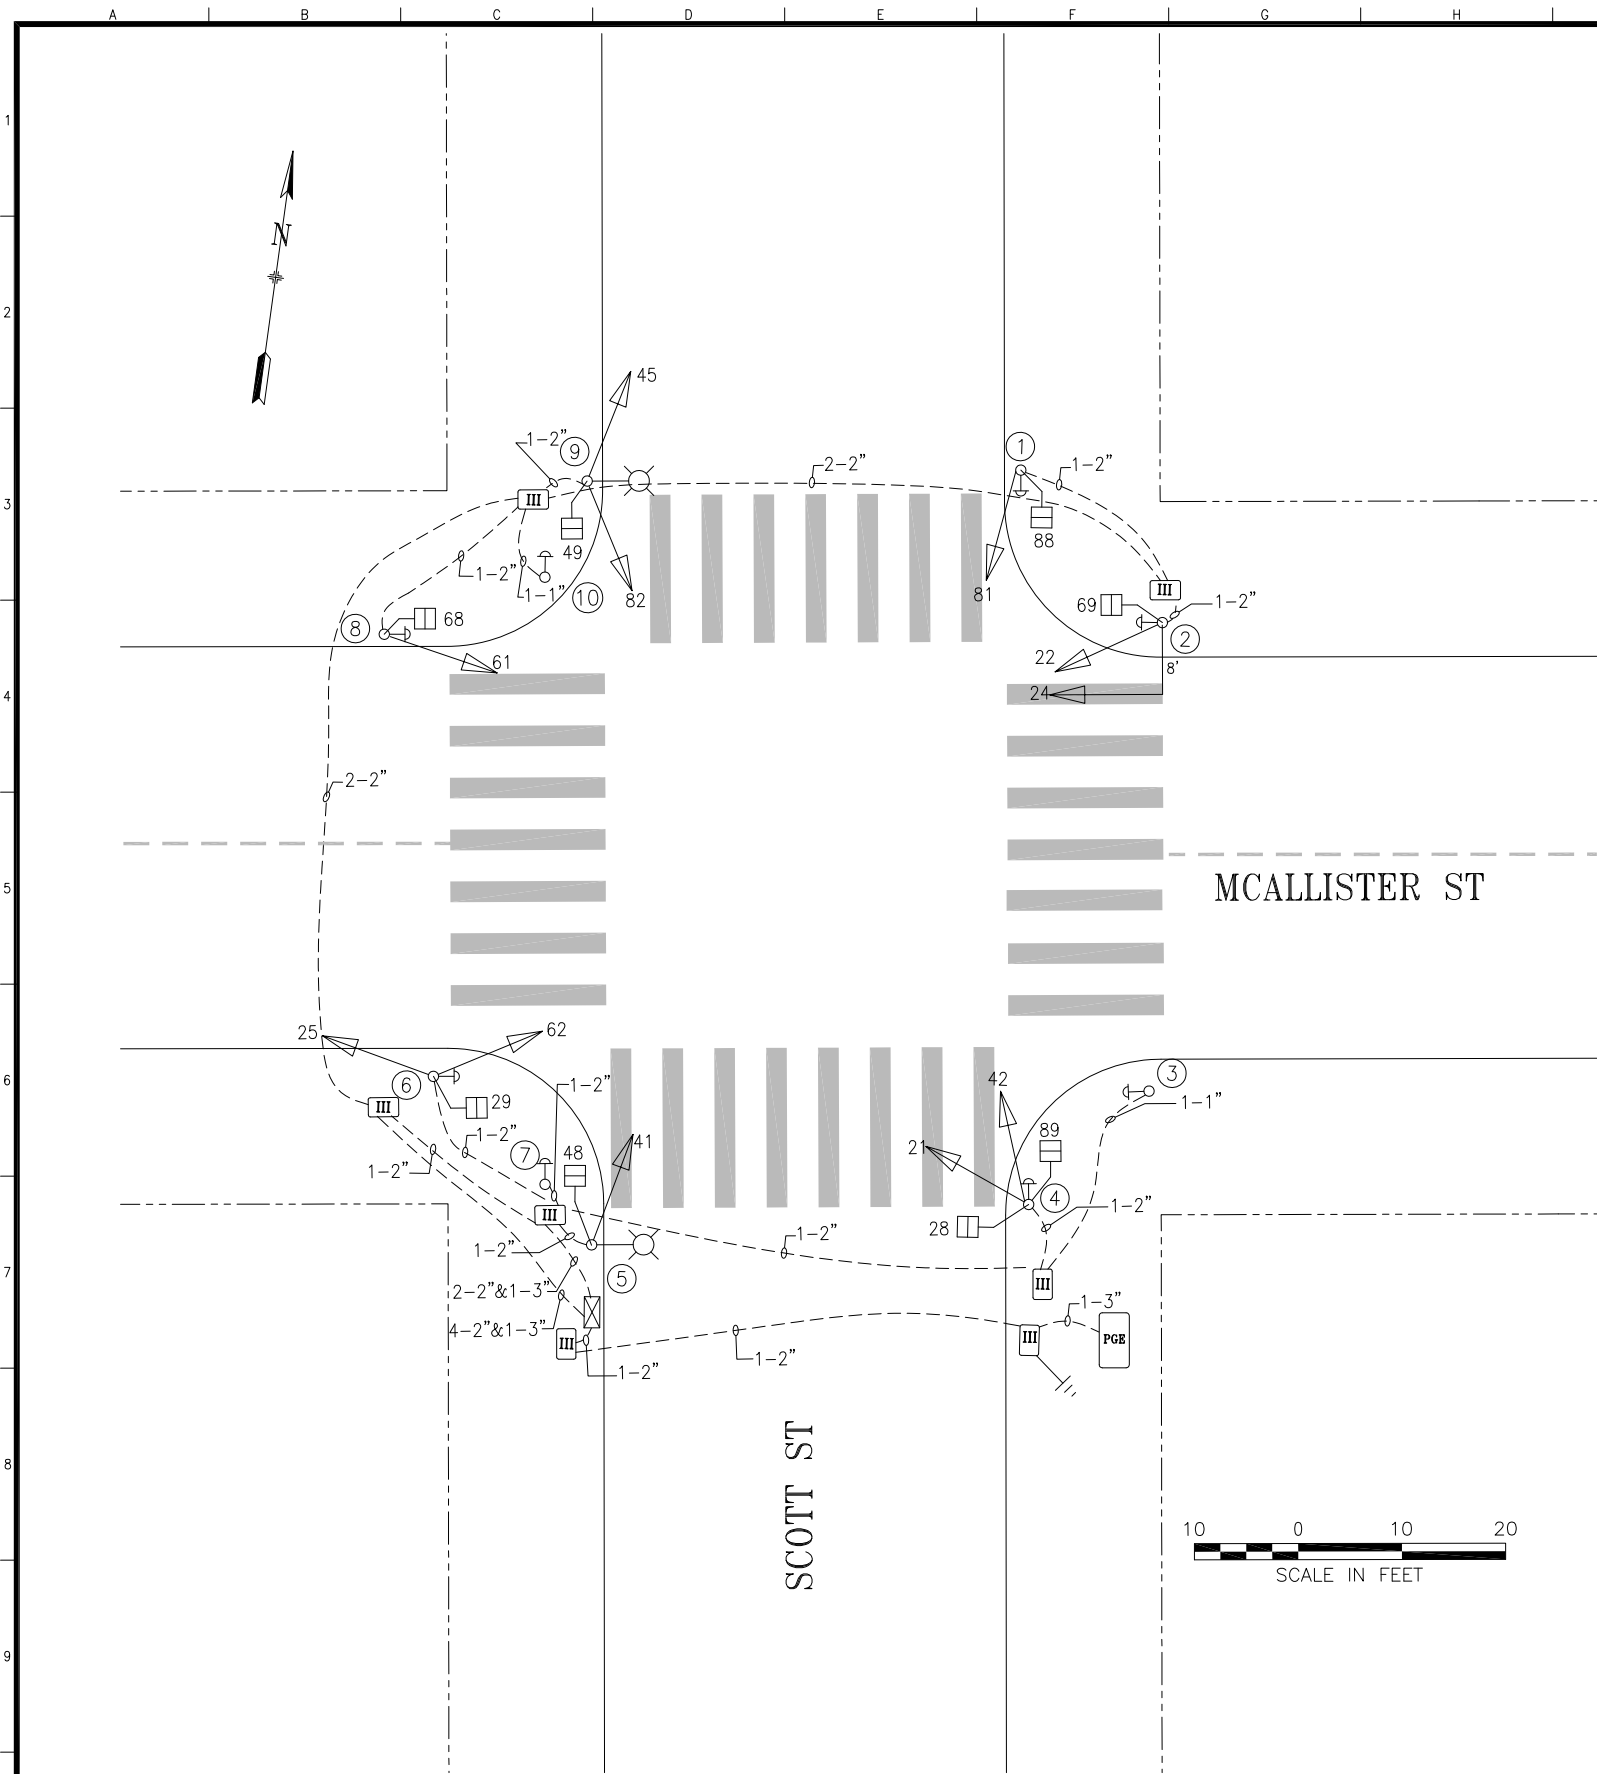

POLE AND EQUIPMENT SCHEDULE									
POLE No.	TYPE OF POLE	VEHICLE SIGNAL				PEDESTRIAN SIGNAL			REMARKS/NOTES
		No.	TYPE	MOUNTING	VISORS	No.	TYPE	MOUNTING	
①	1-A (10')	81	3S12"	TV-1-T	T	88	1S-COUNT	SP-1	APS
②	16-2-100 (WITH 8' MAST ARM)	22	3S12"	SV-1-T	T	69	1S-COUNT	SP-1	BACKPLATE APS
		24	3S12"	MAS	T				
③	PPB POLE (4')								APS
④	1-A (13')	21	3S12"	TV-2-T-SFA	T	89	1S-COUNT	SP-1 (22") WITH SP-1-SF(12")	APS
		42	3S12"		T				
⑤	STREETLIGHT	41	3S12"	SV-1-T	T	48	1S-COUNT	SP-1	
⑥	1-A (10')	25	3S12"	TV-2-T	T	29	1S-COUNT	SP-1 (22')	APS
		62	3S12"		T				
⑦	1-A (5')								APS
⑧	MUNI OCS	61	3S12"	SV-1-T	T	68	1S-COUNT	SP-1	APS
⑨	STREETLIGHT	45	3S12"	SV-2-TA	T	49	1S-COUNT	SP-1	
		82	3S12"		T				
⑩	PPB POLE (4')								APS

0	03/08/18	NEW SIGNAL ACTIVATED BY MR 1290R	K.Shue	K.Kwong	
NO.	DATE	DESCRIPTION	BY	APP.	
TABLE OF REVISIONS					
CHECK WITH TRACING TO SEE IF YOU HAVE LATEST REVISION					

REFERENCE INFORMATION & FILE NO. OF SURVEYS



SAN FRANCISCO MUNICIPAL TRANSPORTATION AGENCY

CITY AND COUNTY OF SAN FRANCISCO

DRAWN: DATE:	
K.SHUE 7/2018	
CHECKED: DATE:	
K.KWONG 7/2018	

SCALE:
AS SHOWN
SHEET OF SHEETS
1 OF 1

TRAFFIC SIGNAL INVENTORY DIAGRAM
MCALLISTER STREET AT SCOTT STREET

CNN NO.	26066000
FILE NO.	0