


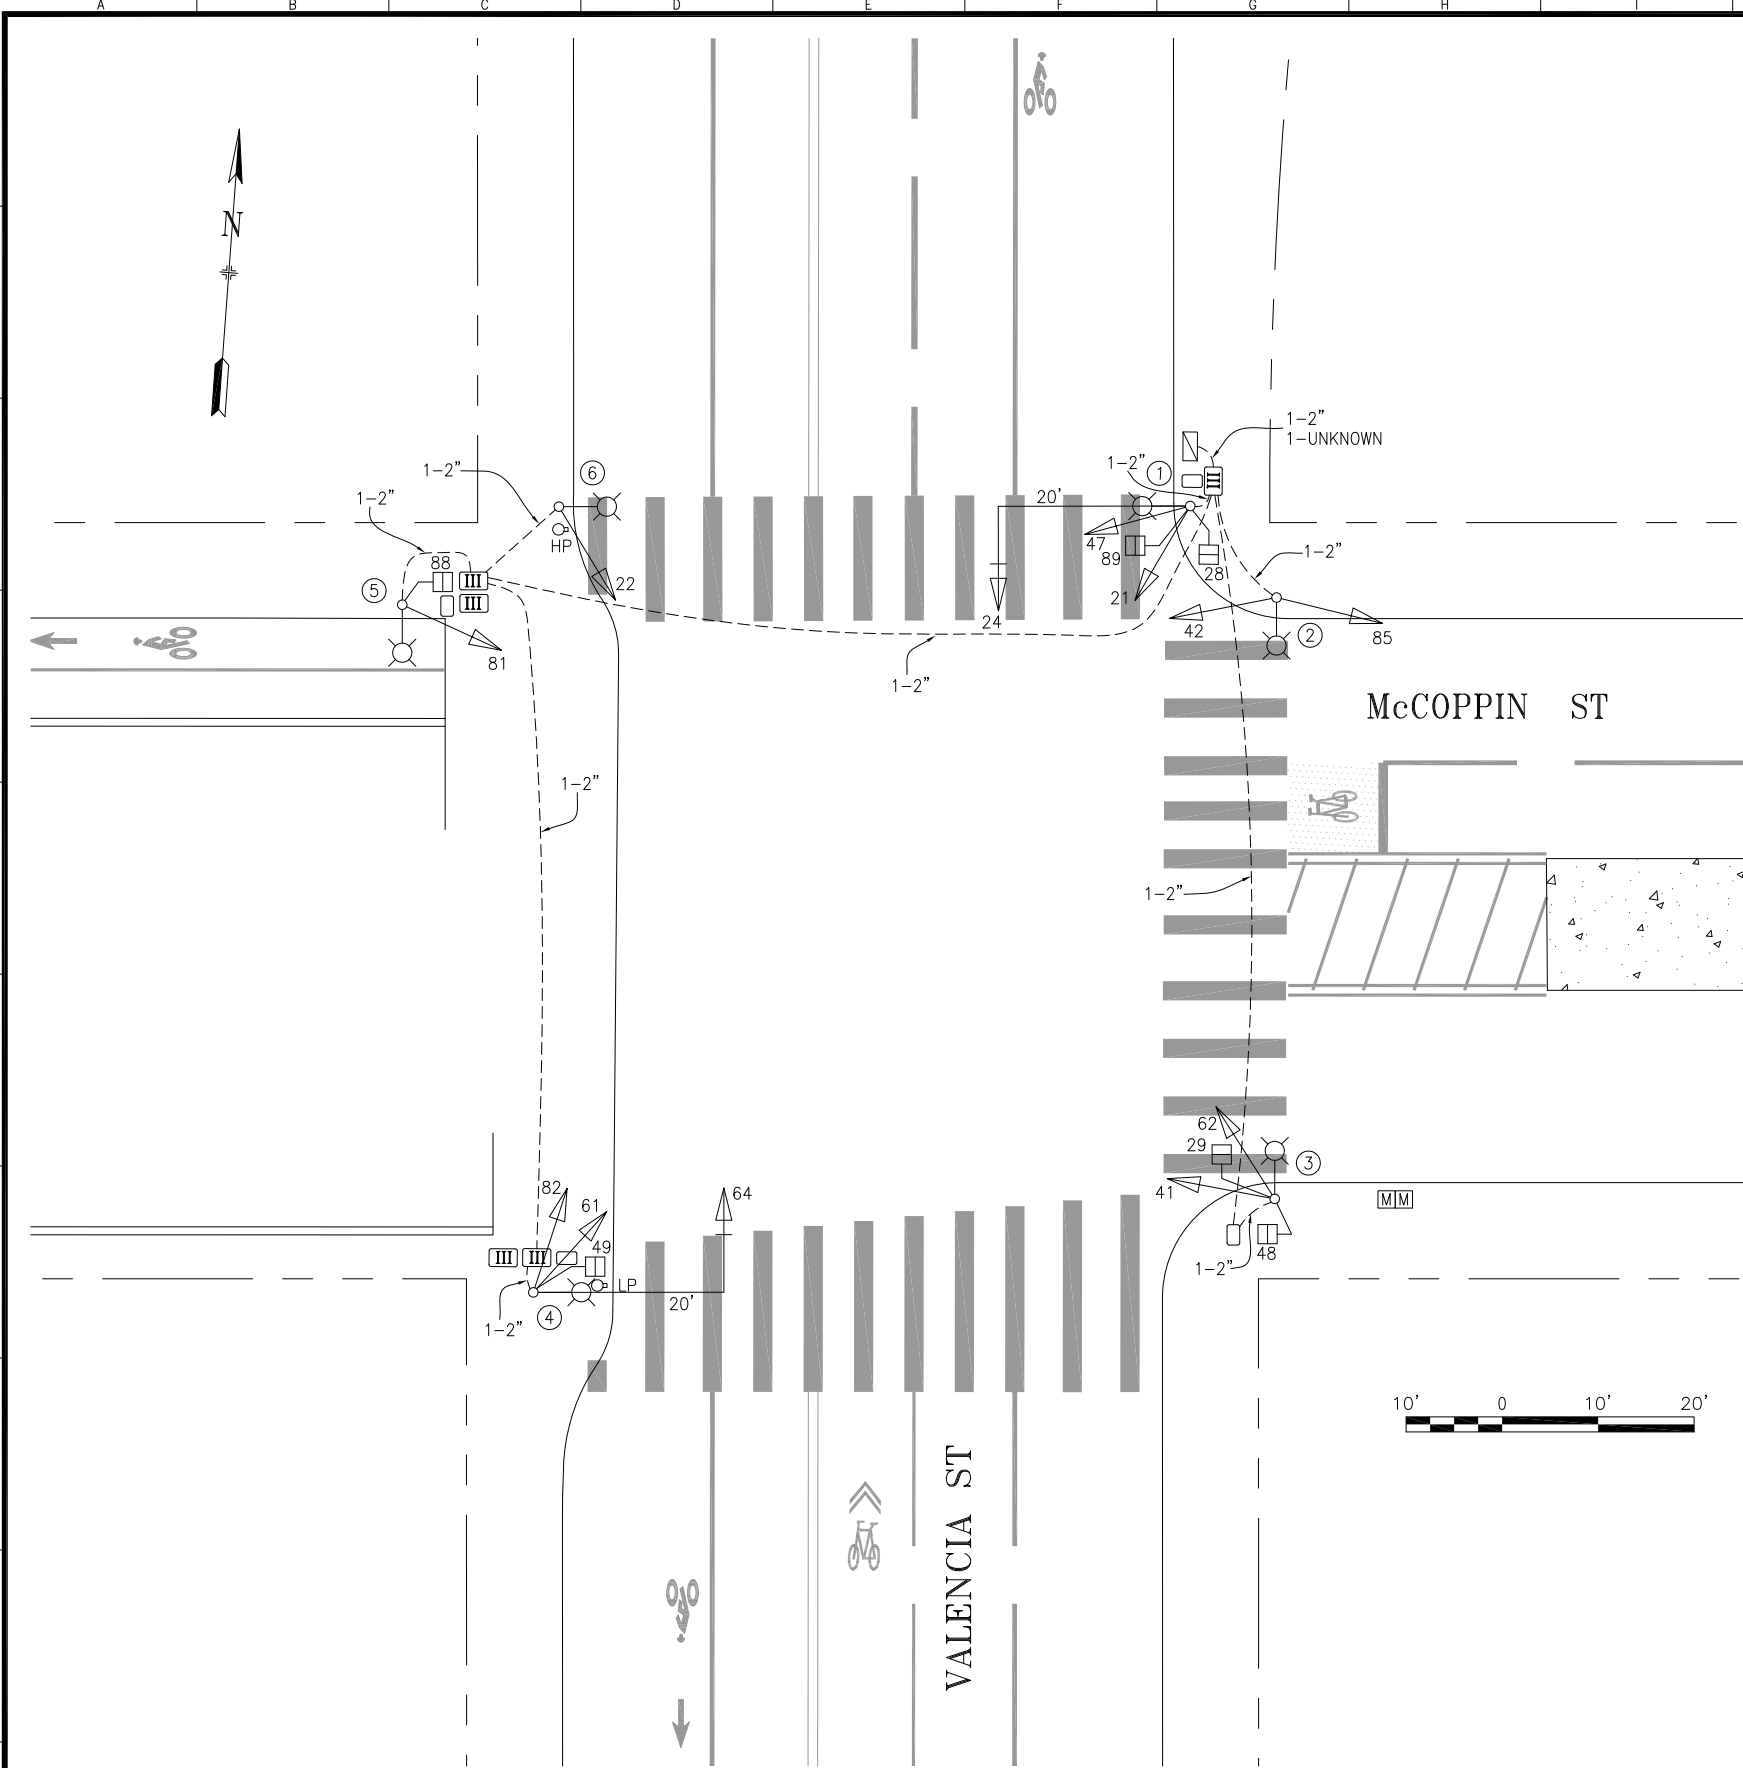

POLE AND EQUIPMENT SCHEDULE										
POLE No.	TYPE OF POLE	LUMINAIRE VOLTAGE/WATTAGE	VEHICLE SIGNAL					PEDESTRIAN SIGNAL		
			No.	TYPE	MOUNTING	VISORS	LOUVERS	No.	TYPE	MOUNTING
①	17B-1-70 W/ 20' MAST ARM, 6' LUMINAIRE	250W 240V HPS	21 47 24	3S12" 3S12"FR 3S12"	SV-2-TA MAS	T T T		89 28	1S-COUNT 1S-COUNT	SP-1 SP-1
②	SL W/ 6' LUMINAIRE	250W 240V HPS	42 85	3S12"FR 3S12"	SV-2-TA	T T				
③	SL W/ 6' LUMINAIRE	250W 240V HPS	41 62	3S12"FR 3S12"	SV-2-TA	T T		48 29	1S-COUNT 1S-COUNT	SP-1 SP-1
④	17B-1-70 W/ 20' MAST ARM, 6' LUMINAIRE	250W 240V HPS	64 61 82	3S12" 3S12" 3S12"	MAS SV-2-T-SF	T T T		49	1S-COUNT	SP-1
⑤	SL W/ 6' LUMINAIRE	250W 240V HPS	81	3S12"	SV-1-T	T		88	1S-COUNT	SP-1
⑥	SL W/ 6' LUMINAIRE	250W 240V HPS	22	3S12"	SV-1-T	T				

NOTE: 3S12"FR = TOP SECTION FLASHING RED, MIDDLE AND BOTTOM SECTIONS BLANK

NO.		DATE	DESCRIPTION	BY	APP.
△	12/1/15		NEW PCS (28, 29); 12 IN HEADS (21, 22, 65); NEW HEADS (47, 85); PHASE 4 TO FR-R, Y AND G BLANK	SVohra	Wetasco
△	10/15		CAD DRAWING UPDATED PER FIELD CHECK	SVohra	Wetasco
△	3/03		CAD DRAWING UPDATED	CXL	RMZ
TABLE OF REVISIONS		CHECK WITH TRACING TO SEE IF YOU HAVE LATEST REVISION			

COMPLETION DATE /
ELECTRICIAN INITIAL



SAN FRANCISCO MUNICIPAL TRANSPORTATION AGENCY

TRANSPORTATION ENGINEERING

CITY AND COUNTY OF SAN FRANCISCO

DRAWN: CXL

DATE: 03/03

CHECKED:

DATE:

SCALE: 1" = 10'

SHEET OF SHEETS 1 OF 1

TRAFFIC SIGNAL INVENTORY DIAGRAM

MCCOPPIN ST AND VALENCIA ST

CNN NO. 25853000

REV. NO. 3