


DRAWING INFORMATION:

FILE NAME: E-32
ORIGIN: ELECTRICAL
DATE: --/--/----

LIMITS:
PLOT SCALE: 1"=240'

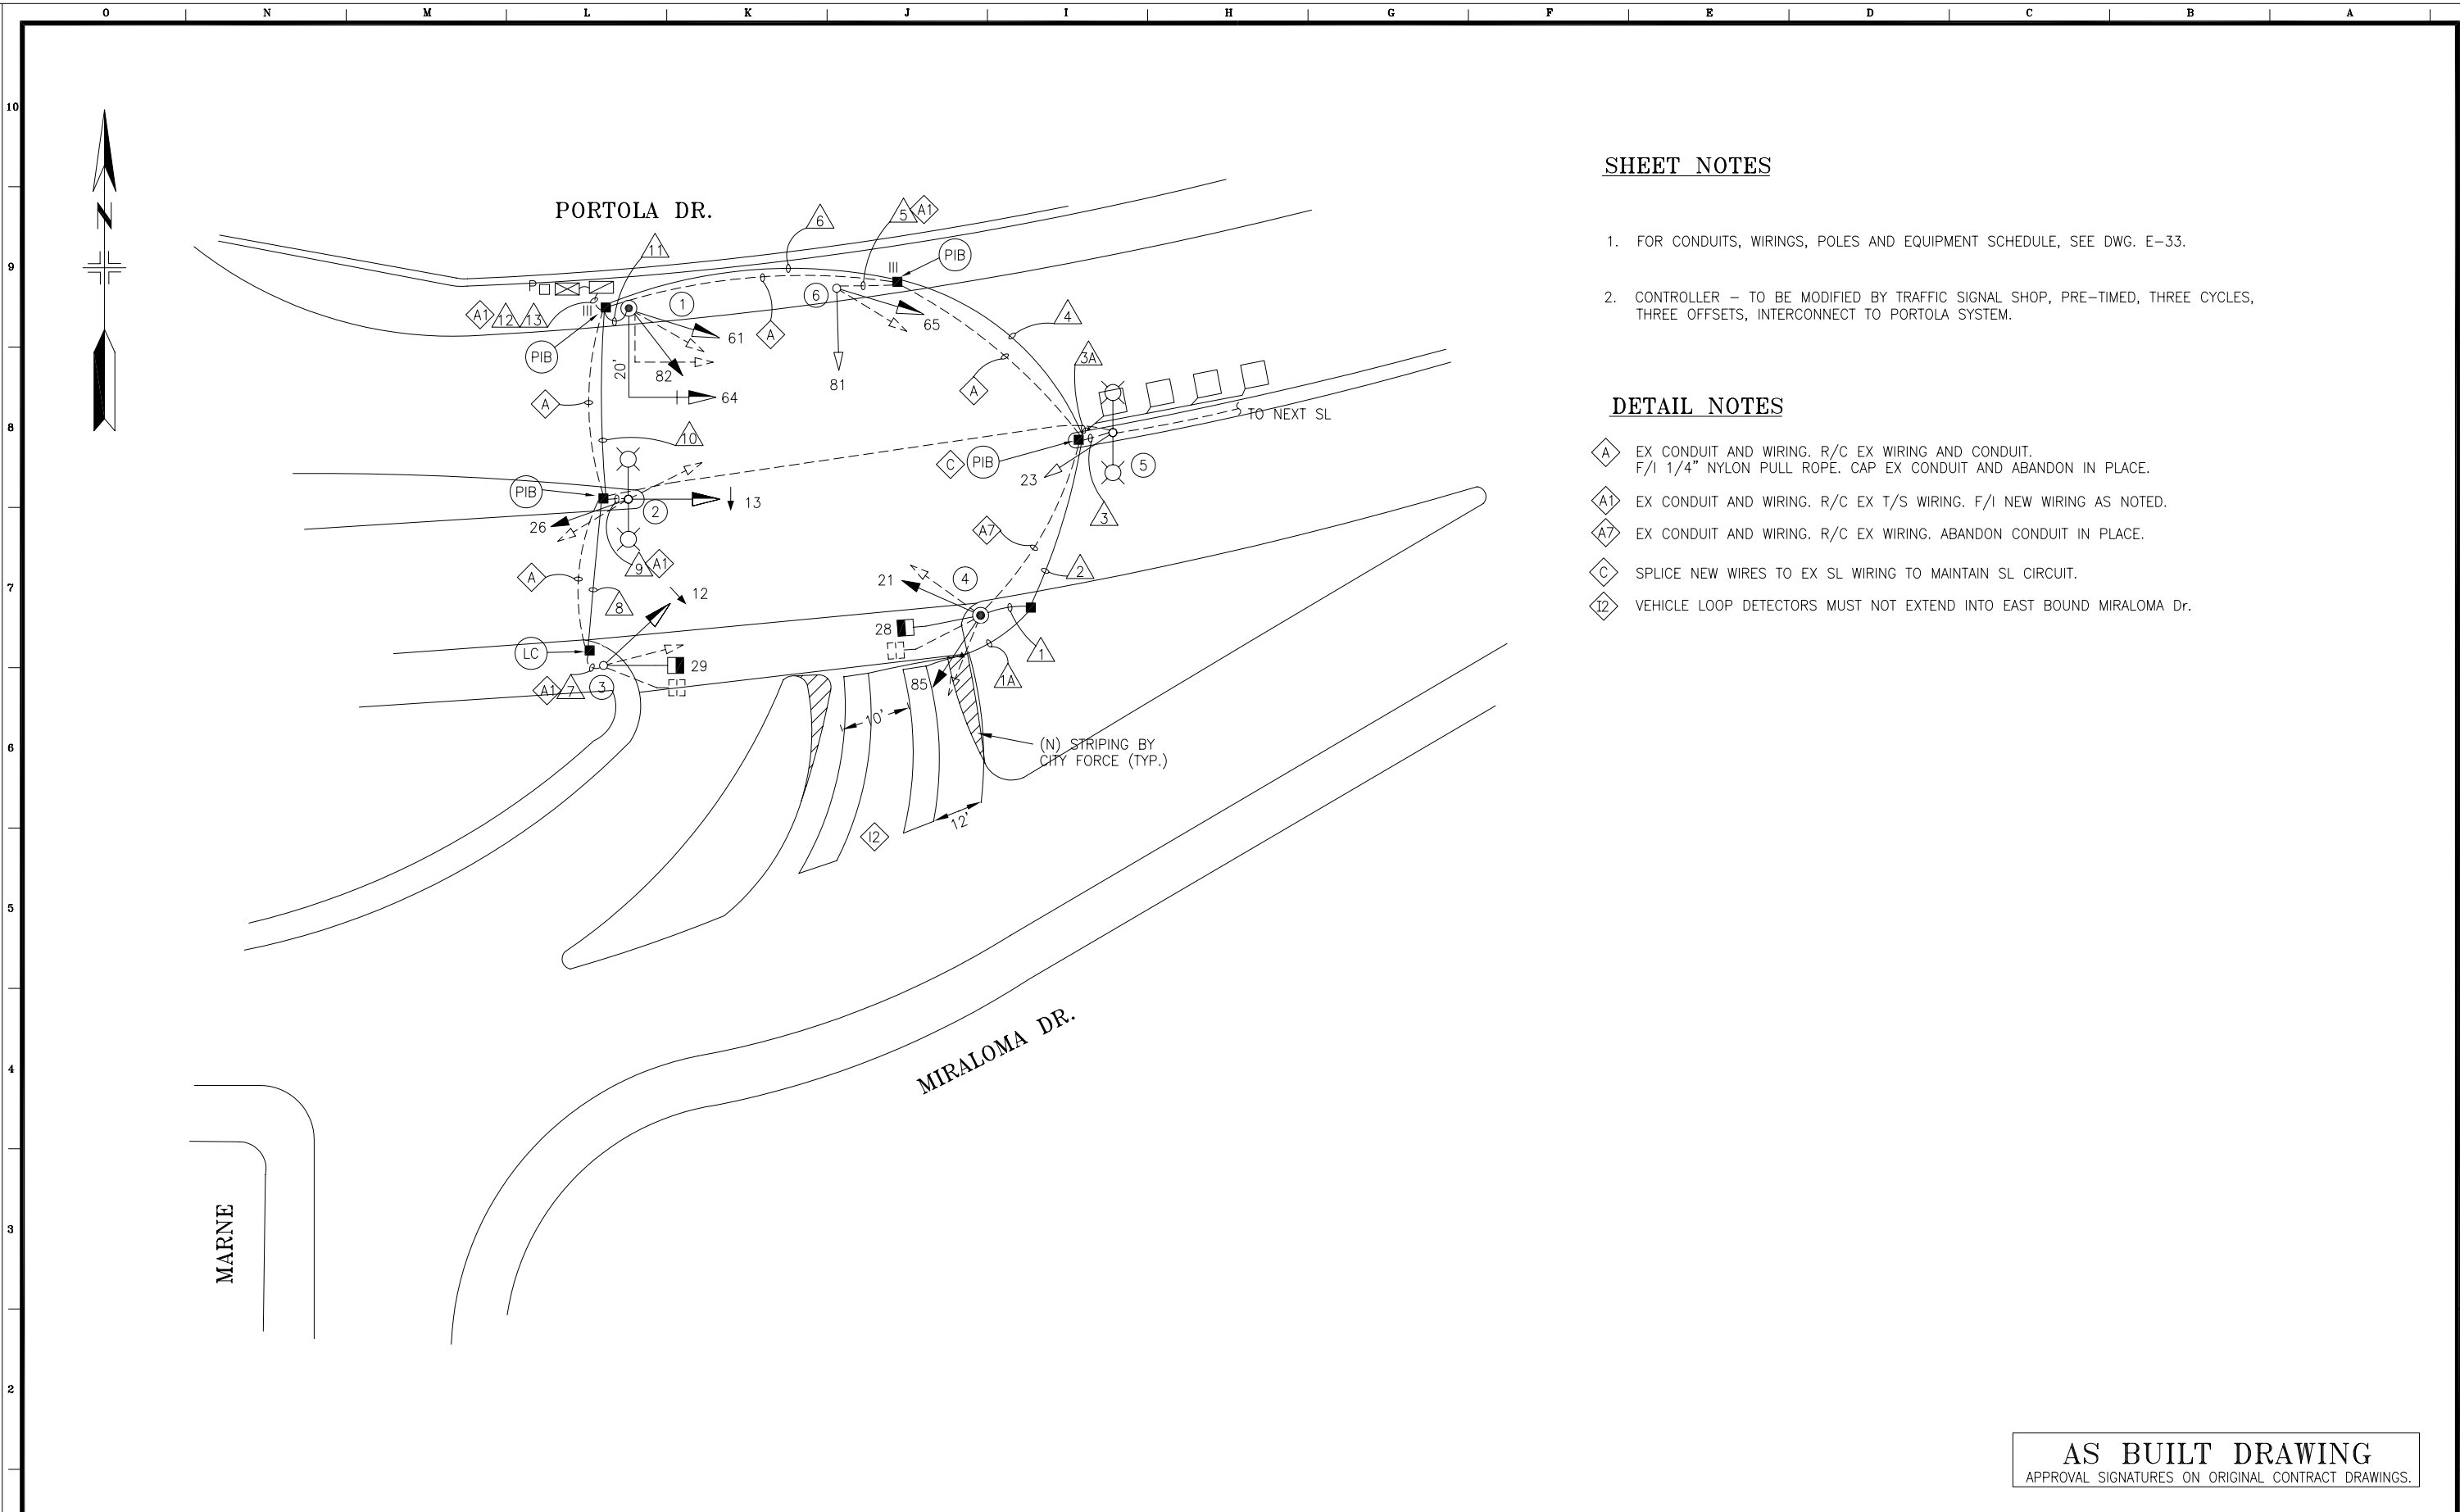

SHEET NOTES

1. FOR CONDUITS, WIRINGS, POLES AND EQUIPMENT SCHEDULE, SEE DWG. E-33.
2. CONTROLLER - TO BE MODIFIED BY TRAFFIC SIGNAL SHOP, PRE-TIMED, THREE CYCLES, THREE OFFSETS, INTERCONNECT TO PORTOLA SYSTEM.

DETAIL NOTES

- A EX CONDUIT AND WIRING. R/C EX WIRING AND CONDUIT. F/I 1/4" NYLON PULL ROPE. CAP EX CONDUIT AND ABANDON IN PLACE.
- A1 EX CONDUIT AND WIRING. R/C EX T/S WIRING. F/I NEW WIRING AS NOTED.
- A7 EX CONDUIT AND WIRING. R/C EX WIRING. ABANDON CONDUIT IN PLACE.
- C SPLICE NEW WIRES TO EX SL WIRING TO MAINTAIN SL CIRCUIT.
- I2 VEHICLE LOOP DETECTORS MUST NOT EXTEND INTO EAST BOUND MIRALOMA Dr.

AS BUILT DRAWING

APPROVAL SIGNATURES ON ORIGINAL CONTRACT DRAWINGS.

REFERENCE INFORMATION & FILE No. OF SURVEYS		TABLE OF REVISIONS		CHECK WITH TRACING TO SEE IF YOU HAVE LATEST REVISION	
NO.	DATE	DESCRIPTION	BY	APP.	
2	5/21/2020	REMOVED PPBS FROM POLES 3 AND 4 PER SRC 2020-151	ALam	BWoo	
1	7/19/00	AS BUILT	AS	SL	



BUREAU OF ENGINEERING
DEPARTMENT OF PUBLIC WORKS
CITY AND COUNTY OF SAN FRANCISCO

DESIGNED:	DATE:
NO/DS	5/97
DRAWN:	DATE:
CS	5/97
CHECKED:	DATE:
CF	5/97

APPROVED	
SECTION MANAGER	DATE:
DIVISION MANAGER	DATE:
CITY ENGINEER	DATE:

SCALE:
1"=20'-0"
SHEET OF SHEETS
32 OF 40

VARIOUS LOCATIONS	
TRAFFIC SIGNAL UPGRADE - CONTRACT 23	
SAN FRANCISCO, CA	
MIRALOMA DR & PORTOLA DR	

SPECIFICATION NO.
1286N
DRAWING NO.
E-32
FILE NO.
66,679
REV. NO.

CONDUIT AND WIRING SCHEDULE

[illegible]

POLE AND EQUIPMENT SCHEDULE

POLE No.	TYPE OF POLE	VEHICLE SIGNAL			PEDESTRIAN SIGNAL			REMARKS
		No.	TYPE	MOUNTING (F/I)	No.	TYPE	MOUNTING (F/I)	
①	16-1-70 WITH 20' SIGNAL ARM	61 82 64	3S12" 3S8" 3S12" 	SV-2-TA MAS				
②	EX MARBELITE STREET LIGHT	13 26	3S12"-LA 3S8"	SV-2				
③	EX T/S POLE	12	3S12"-LA	TV-2	29	IS-IN	SP-1	
④	1-A(10')	85 21	3S8" 3S8"	TV-2-T	28	IS-IN	SP-1	R/C EX 1-A POLE FOUNDATION
⑤	EX MARBELITE STREET LIGHT	23 (EX)						
⑥	EX T/S POLE	65 81 (EX)	3S12"	TV-2-T-SFB				

SHEET NOTE

R/S EX SIGNALS AND EX MOUNTINGS.
F/I (N) SIGNAL AND (N) MOUNTING AS SHOWN
ON PLAN E-32.

DETAIL NOTES

- A** EX CONDUIT AND WIRING. R/C EX WIRING AND CONDUIT. F/I 1/4" NYLON PULL ROPE. CAP EX CONDUIT AND ABANDON IN PLACE.
- A1** EX CONDUIT AND WIRING. R/C EX T/S WIRING. F/I NEW WIRING AS NOTED.
- A7** EX CONDUIT AND WIRING. R/C EX WIRING. ABANDON CONDUIT IN PLACE.
- K** WITH BACK PLATE.

AS BUILT DRAWING

APPROVAL SIGNATURES ON ORIGINAL CONTRACT DRAWINGS.

[illegible]