


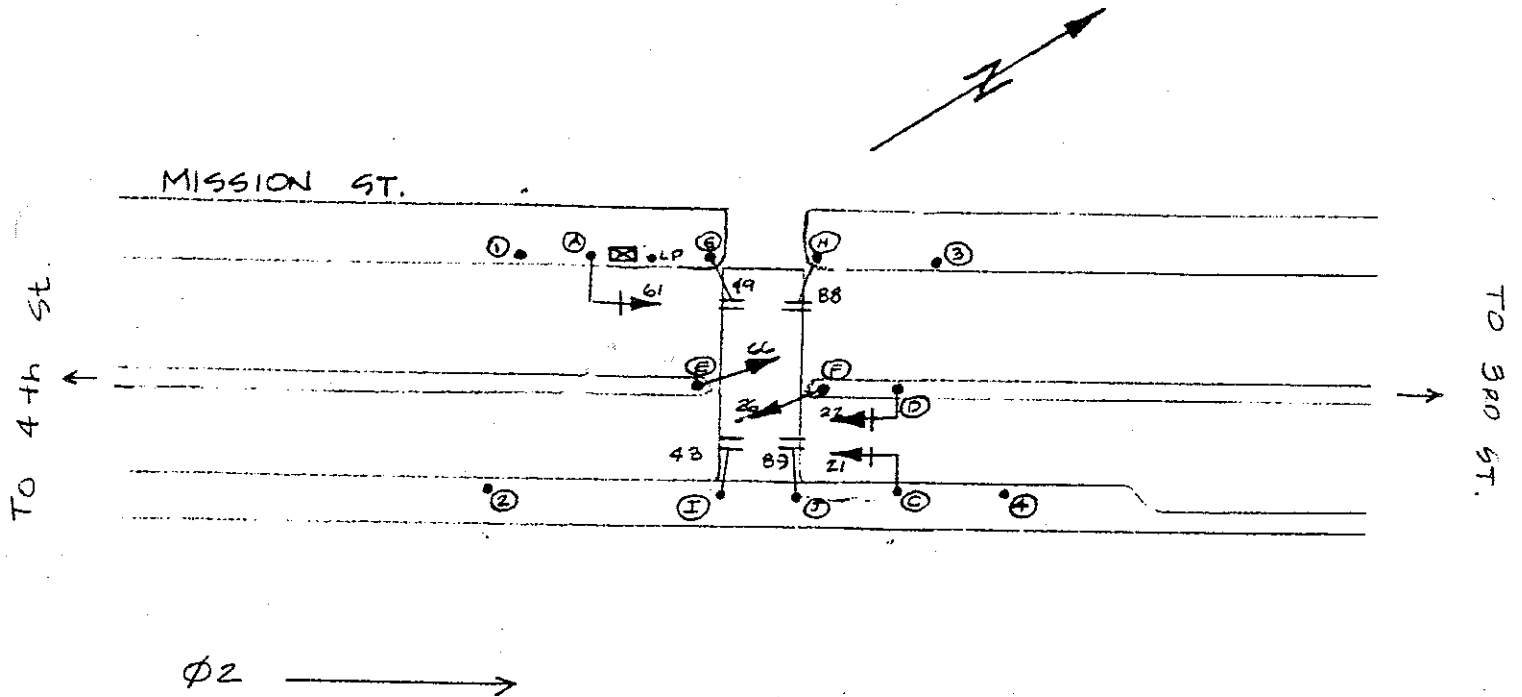

AS OF 8/18/99

POLE	FUNC.	MAT'L	SIGNAL NO.	MAKE	NO. OF SECT.	SIZE	VISOR	B.P. OR LOUVERS	MOUN'T	PED SIGNAL NO.	LEGEND	MESSAGE		MAKE	MOUN'
												ELEMENT	COLOR		
A	S	S	21	TCT	3	12"	FC 8"	BP	MAS	43	I	1S-I	W/OR	ICC	T
			22	TCT	3	12"	FC 8"	BP	MAS	49	I	1S-I	W/OR	ICC	T
C	S	S	26	TCT	3	8"	FC 8"	NO	T	88	I	1S-I	W/OR	ICC	T
D	S	S	61	TCT	3	12"	FC 8"	BP	MAS	89	I	1S-I	W/OR	ICC	T
E	L	S													
F	S	S	66	TCT	3	12"	FC 8"	NO	S						
G	S	S													
H	S	S													
I	S	S													
J	S	S													
1	L	S													
2	L	S													
3	L	S													
4	M	S													

CONTROLLER CABINET SIZE : ORDINARY BASE CABINET: YES

COMMENTS :

Remove Pole B/Signal #62 , CHANGE #66 to 12"