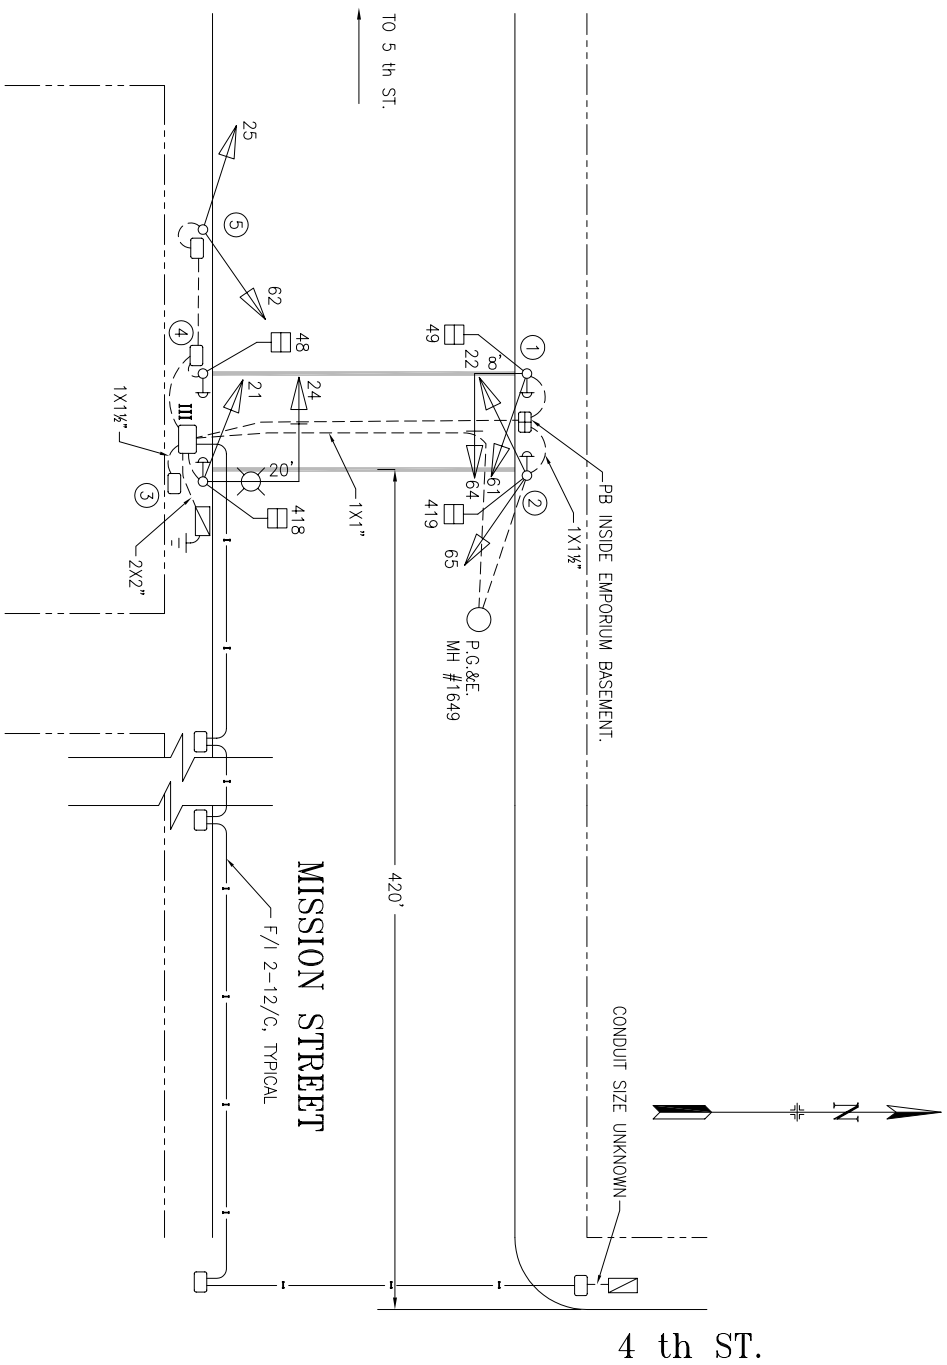


[illegible]

NOTE:

CABINET FOUNDATION TYPE: STD



TABLE OF REVISIONS				COMPLETION DATE / ELECTRICIAN INITIAL
NO.	DATE	DESCRIPTION	BY APP.	
1	07/95	SIGNAL MODIFICATION CT22.	CXL BW	
CHECK WITH TRACING TO SEE IF YOU HAVE LATEST REVISION				



DEPARTMENT OF PARKING AND TRAFFIC
DIVISION OF TRAFFIC ENGINEERING
CITY AND COUNTY OF SAN FRANCISCO

DRAWN:	DATE:	SCALE:	TRAFFIC SIGNAL INVENTORY DIAGRAM MISSION ST MID-BLOCK BETWEEN 4TH ST & 5TH ST	CNN. NO.
CXL	07/09/93	1" = 40'		9096000
CHECKED:	DATE:	SHEET OF SHEETS 1 OF 1		REV. NO.