

NO.	DATE	DESCRIPTION	BY	APP.
0	9/20/18	SIGNAL UPGRADE BY 2774J, CONVERTED FROM CT PLN/AS-BL1	DYeung	GdeLeon
TABLE OF REVISIONS				
CHECK WITH TRACING TO SEE IF YOU HAVE LATEST REVISION				

REFERENCE INFORMATION & FILE NO. OF SURVEYS



SAN FRANCISCO MUNICIPAL TRANSPORTATION AGENCY
CITY AND COUNTY OF SAN FRANCISCO

DRAWN:	DATE:
DYeung	3/2020
CHECKED:	DATE:
GdeLeon	3/2020

SCALE:
AS SHOWN
SHEET OF SHEETS
1 OF 3


TRAFFIC SIGNAL INVENTORY DIAGRAM
MISSION STREET, NIAGARA AVENUE, POPE STREET, AND ROLPH STREET

CNN NO.
21485000
REV NO.
0

POLE AND EQUIPMENT SCHEDULE											
POLE No.	TYPE OF POLE	LUMINAIRE VOLTAGE/ WATTAGE	VEHICLE SIGNAL					PEDESTRIAN SIGNAL			REMARKS
			No.	TYPE	MOUNTING	VISORS	LOUVERS	No.	TYPE	MOUNTING	
①	16-2-100 W/ 10' MAST ARM		94	PV3S12"	MAS ②	T					BACKPLATE
②	MUNI W/ 6' LUMINAIRE ARM		91	PV3S12"	SV-1-T	T		98	1S-COUNT	SP-1	APS 2-W EXTERNAL CONDUIT ④
③	1-A (10')		85	3S12"	TV-1-T	T		89	1S-COUNT	SP-1	MOUNT AT 13' APS 2-W
④	PPBP										APS 2-W
⑤	1-A (10')		62	3S12"	TV-1-T	T		99	1S-COUNT	SP-1	
⑥	16-2-100 W/ 8' MAST ARM		21 24	3S12" 3S12"	SV-1-T (24") MAS ②	T T					APS 2-W BACKPLATE
⑦	1-A (10')							28 129	1S-COUNT 1S-COUNT	SP-1 SP-1 (22")	APS 2-W
⑧	SL W/ 6'LA ①	LED 53 W						48	1S-COUNT	SP-1	APS 2-W
⑨	1-A (10')		25 142	3S12" PV4S12"GLA	TV-2-T-SFA	T T		29	1S-COUNT	SP-1	APS 2-W
⑩	17-2-100 W/ 8' MAST ARM, 6 LUMINAIRE	LED 139 W	111 144	PV3S12" PV4S12"GLA	SV-1-T MAS ②	T T		49	1S-COUNT	SP-1	MOUNT 111 AT 13' APS 2-W BACKPLATE
⑪	SL W/ 6'LA		22	3S12"	SV-1-T	T		128	1S-COUNT	SP-1	APS 2-W
⑫	1-A (7')							118	1S-COUNT	TP-1	APS 2-W
⑬	1-A (7')							119	1S-COUNT	TP-1	APS 2-W
⑭	17-2-100 W/ 8' MAST ARM, 6 LUMINAIRE	LED 139 W	82 64	3S12" 3S12"	SV-1-T MAS ②	T T					BACKPLATE MOUNT 82 AT 13'
⑮	MUNI		92 81 65	PV3S12" 3S12" 3S12"	SV-3-TA ⑤	T T T		88	1S-COUNT	SP-1 (22")	APS 2-W EXTERNAL CONDUIT ④

SHEET NOTES:

- ① POLE FOUNDATION WAS CHIPPED TO BRING (N) CONDUIT INTO POLE BASE
- ② MAST ARM PLUMBIZER IS MOUNTED BETWEEN YELLOW AND GREEN SIGNAL HEAD
- ③ SIGNAL IS MOUNTED ON SAME POLE QUADRANT AS THE APS BUTTON
- ④ EXTERNAL RISER ENTERS POLE VIA AN "LB" CONDULET LOCATED OPPOSITE HAND HOLE
- ⑤ NIPPLE LENGTHS FOR PV HEAD 92 ARE SLIGHTLY LONGER THAN NORMAL TO ALLOW HEAD TO ROTATE

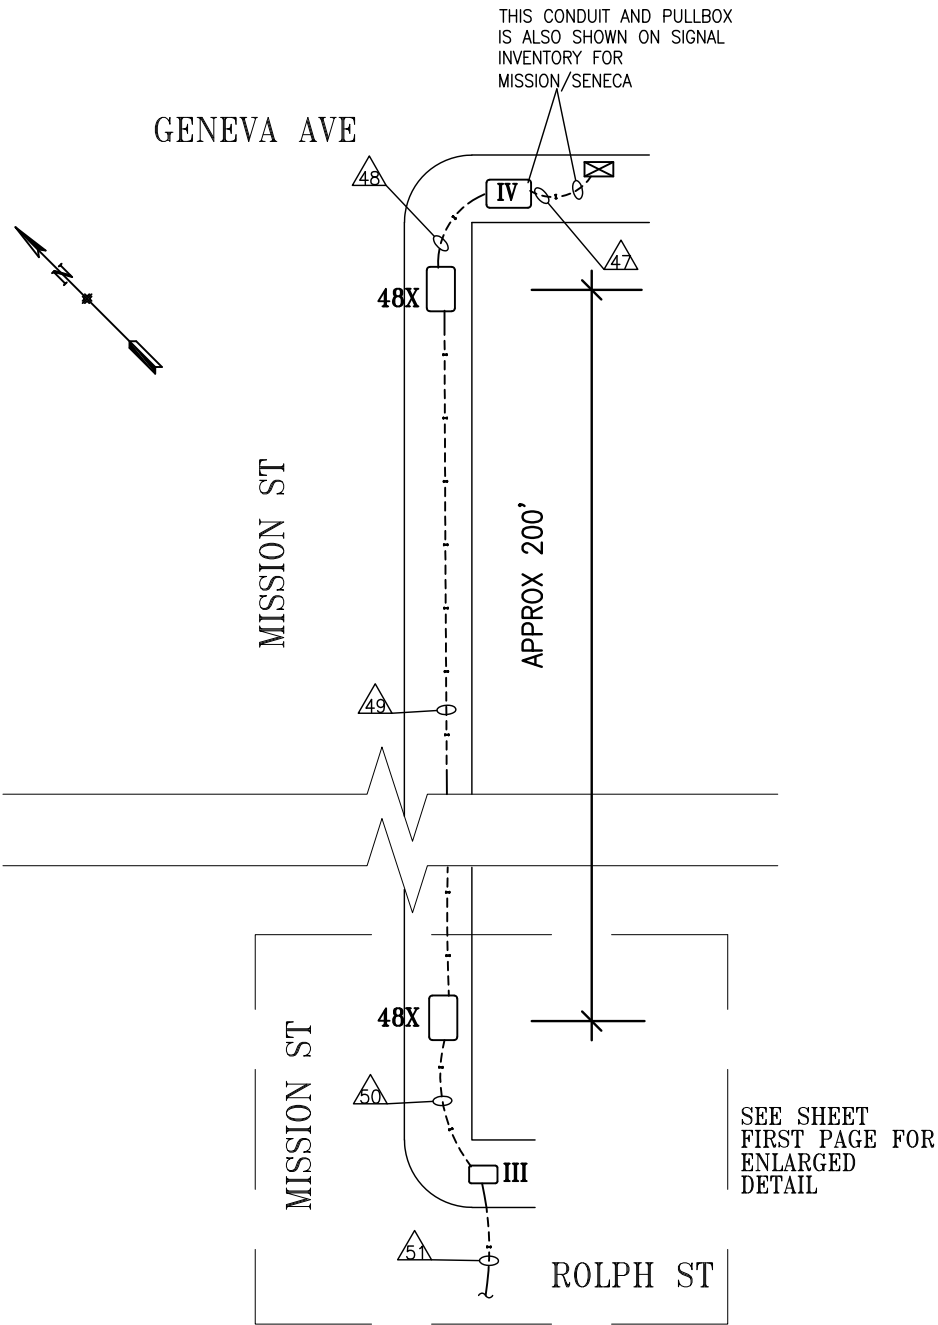

INTERCONNECT WIRING DETAIL
NOT TO SCALE

										REFERENCE INFORMATION & FILE NO. OF SURVEYS		 <div>SAN FRANCISCO MUNICIPAL TRANSPORTATION AGENCY CITY AND COUNTY OF SAN FRANCISCO</div>										<div>DRAWN: DATE: DYeung 3/2020</div> <div>CHECKED: DATE: GdeLeon 3/2020</div>				SCALE: AS SHOWN		TRAFFIC SIGNAL INVENTORY DIAGRAM		CNN NO. 21485000					
O 9/20/18 SIGNAL UPGRADE BY 2774J, CONVERTED FROM CT PLN/AS-BLT										DYeung		GdeLeon														SHEET OF SHEETS		MISSION STREET, NIAGARA AVENUE, POPE STREET, AND ROLPH STREET		REV NO. 0					
NO.		DATE		DESCRIPTION						BY		APP.														2 OF 3									
TABLE OF REVISIONS										CHECK WITH TRACING TO SEE IF YOU HAVE LATEST REVISION																									

				REFERENCE INFORMATION & FILE NO. OF SURVEYS		 SAN FRANCISCO MUNICIPAL TRANSPORTATION AGENCY CITY AND COUNTY OF SAN FRANCISCO				SCALE:		TRAFFIC SIGNAL INVENTORY DIAGRAM		CNN NO.	
										NONE				21485000	
O 9/20/18 SIGNAL UPGRADE BY 2774J, CONVERTED FROM CT PLN/AS-BLT DYeung GdeLeon								DRAWN: DATE: DYeung 3/2020		SHEET OF SHEETS		MISSION STREET, NIAGARA AVENUE, POPE STREET, AND ROLPH STREET CONDUIT & WIRING SCHEDULE		REV NO.	
NO. DATE DESCRIPTION BY APP.								CHECKED: DATE: GdeLeon 3/2020		3 OF 3				0	
TABLE OF REVISIONS CHECK WITH TRACING TO SEE IF YOU HAVE LATEST REVISION															