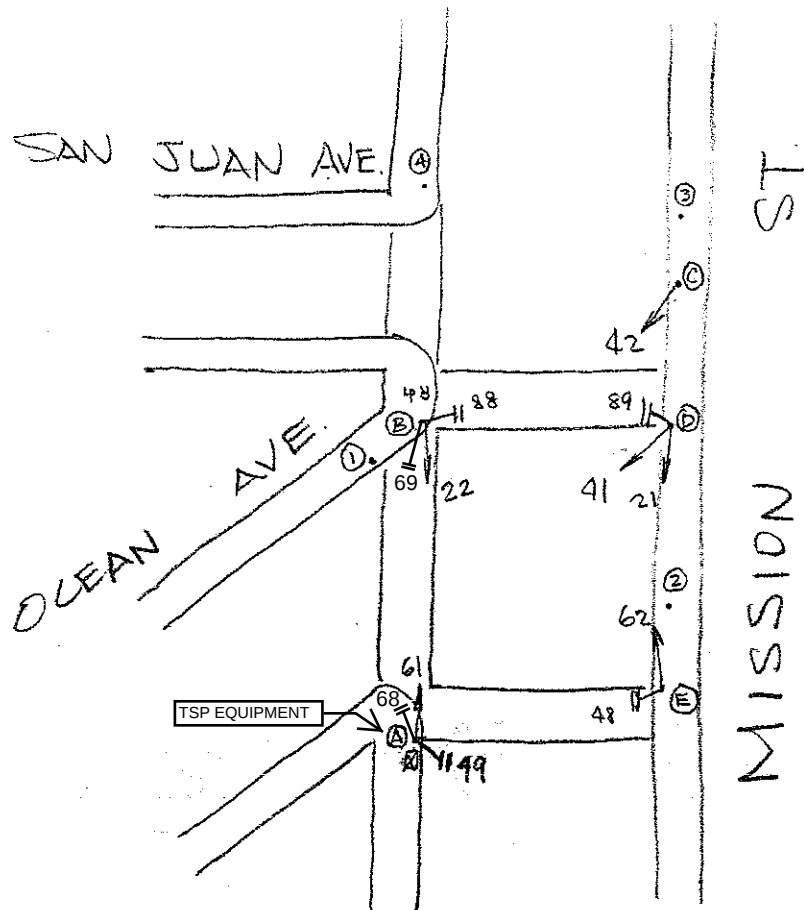


[illegible]

CONTROLLER CABINET SIZE : ORDINARY BASE CABINET: NO

COMMENTS: Added Ped #49
Removed #82

UPDATE PER FIELD: 3S12", PED #68, PED #69, AND TSP EQUIPMENT. - ECT
5/3/2021