


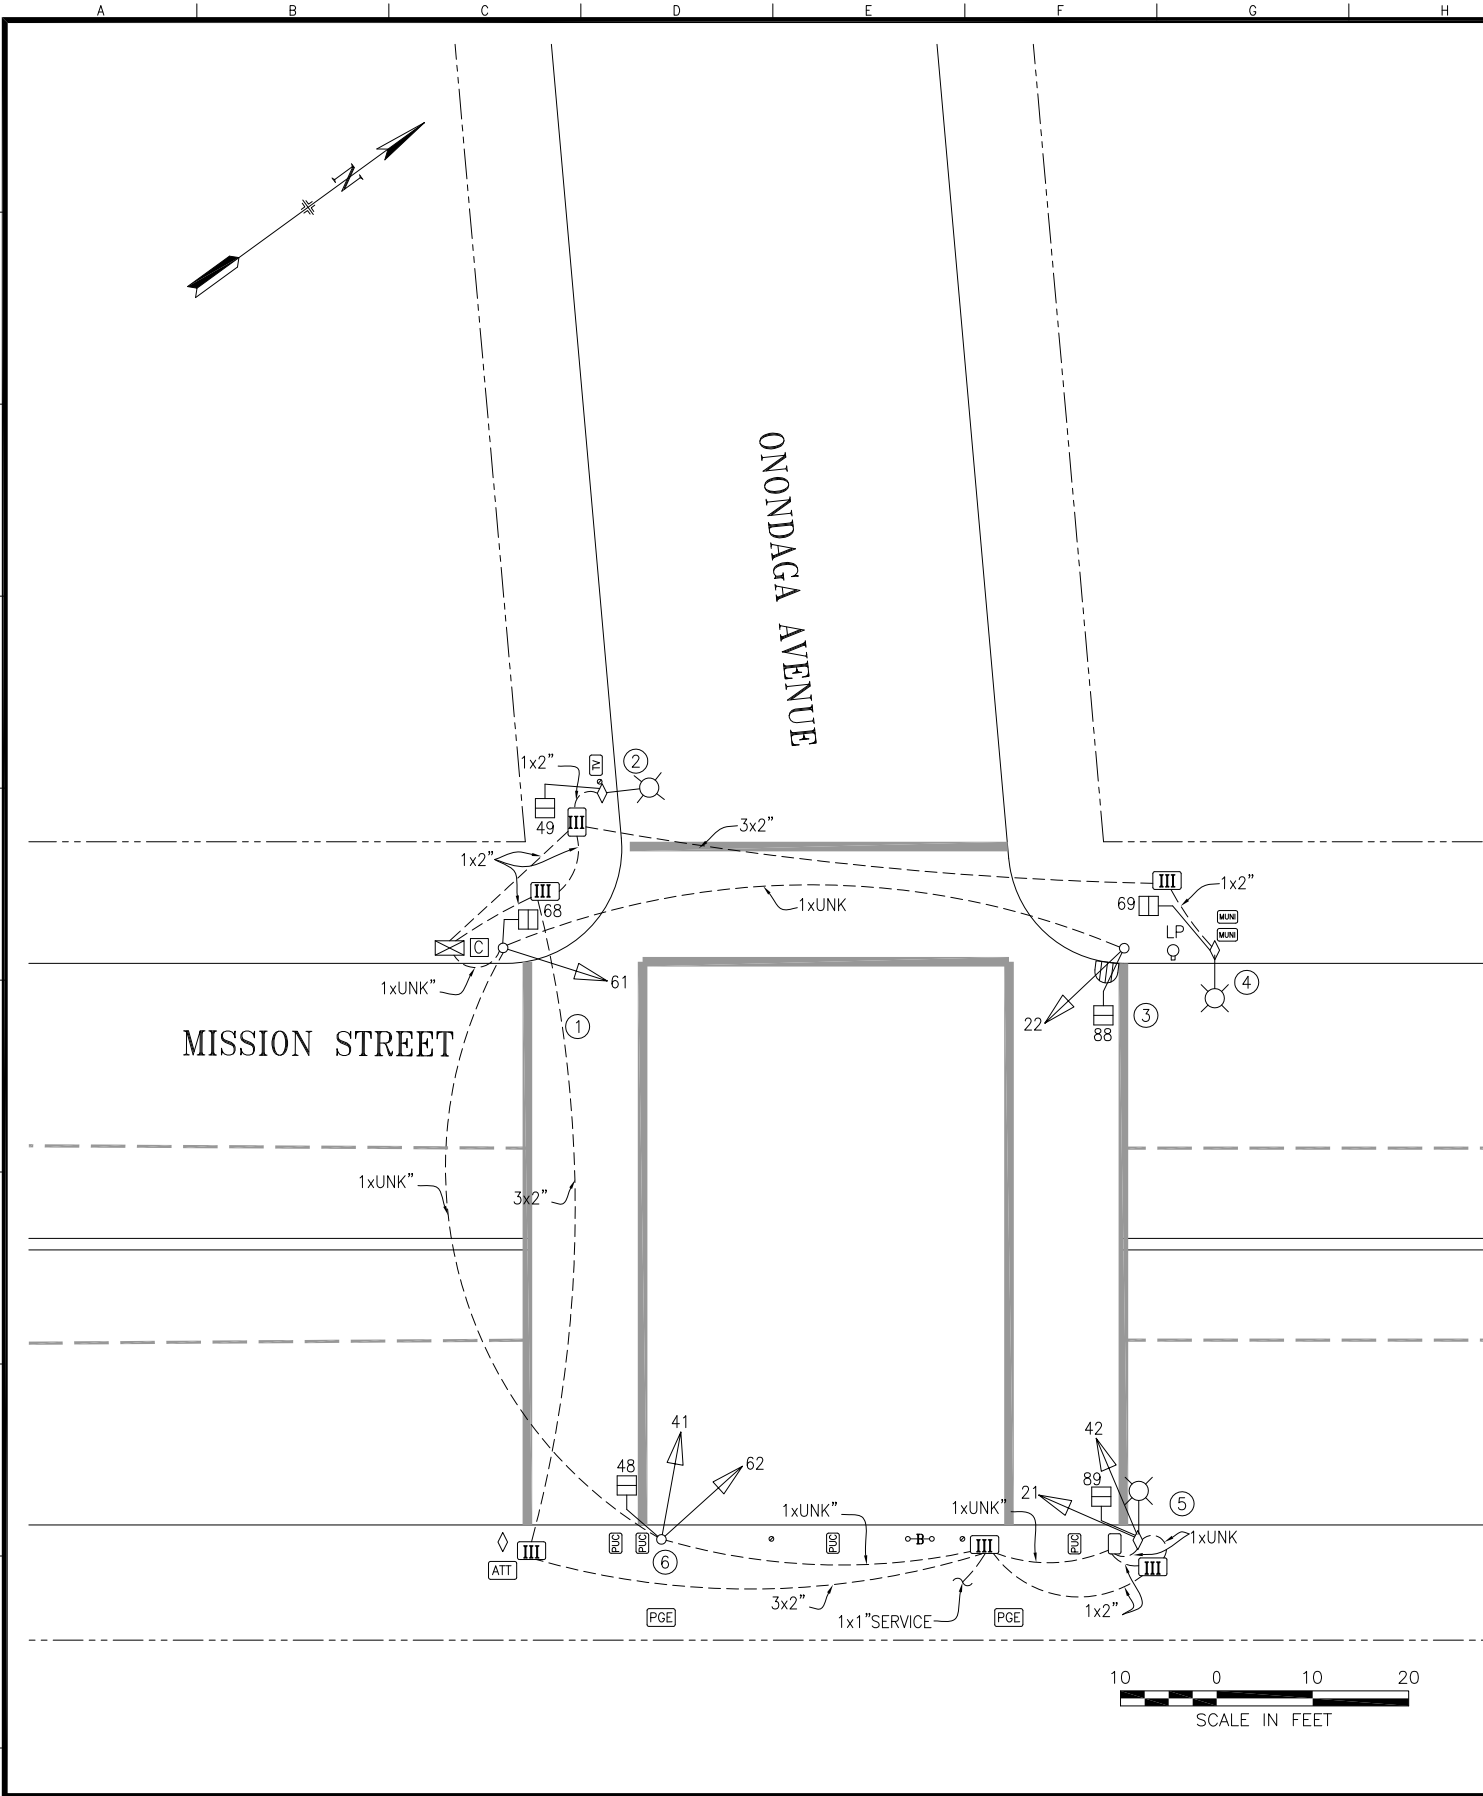

POLE AND EQUIPMENT SCHEDULE										
POLE No.	TYPE OF POLE	LUMINAIRE VOLTAGE/WATTAGE	VEHICLE SIGNAL					PEDESTRIAN SIGNAL		
			No.	TYPE	MOUNTING	VISORS	LOUVERS	No.	TYPE	MOUNTING
①	PEDESTAL SIGNAL POLE (10')		61	3S12"	TV-1-T	T		68	1S-COUNT	SP-1-SF (12")
②	MUNI POLE W/ 6' LA							49	1S-COUNT	SP-1
③	PEDESTAL SIGNAL POLE (10')		22	3S12"	TV-1-T	T		88	1S-COUNT	SP-1-SF (12")
④	MUNI POLE W/ 6' LA							69	1S-COUNT	SP-1
⑤	MUNI POLE W/ 6' LA		21 42	3S12" 3S12"	SV-2-TC	T T		89	1S-COUNT	SP-1
⑥	PEDESTAL SIGNAL POLE (10')		41 62	3S12" 3S12"	TV-2-T-SFA	T T		48	1S-COUNT	SP-1
										REMARKS
										MOUNT SIGNAL 61 ON BUILDING SIDE OF POLE
										MOUNT SIGNAL 22 ON BUILDING SIDE OF POLE
										TRANSIT SIGNAL PRIORITY EQUIPMENT

2	10/12/16	ADD PCS 68 & 69. RELOCATE 49 TO POLE 2	DYeung	CDelon	
1	05/09/16	PER FIELD CHECK - NEW CONDUITS ADDED. RENUMBER POLES	DYeung	MVelasco	
0	08/06/15	2543J PUNCHLIST WALKTHROUGH, UPGRADE TO 12", ADD PCS XING MISSION	DYeung	MVelasco	
NO.	DATE	DESCRIPTION	BY	APP.	
TABLE OF REVISIONS					
CHECK WITH TRACING TO SEE IF YOU HAVE LATEST REVISION					

REFERENCE INFORMATION & FILE NO. OF SURVEYS



SAN FRANCISCO MUNICIPAL TRANSPORTATION AGENCY

CITY AND COUNTY OF SAN FRANCISCO

DRAWN:	DATE:
AScales	12/2015
CHECKED:	DATE:
MVelasco	12/2015

SCALE:
AS SHOWN
SHEET OF SHEETS
1 OF 1

TRAFFIC SIGNAL INVENTORY DIAGRAM
MISSION STREET AND ONONDAGA AVENUE

CNN NO.
21751000
REV NO.
2