


MISSION & PERSIA

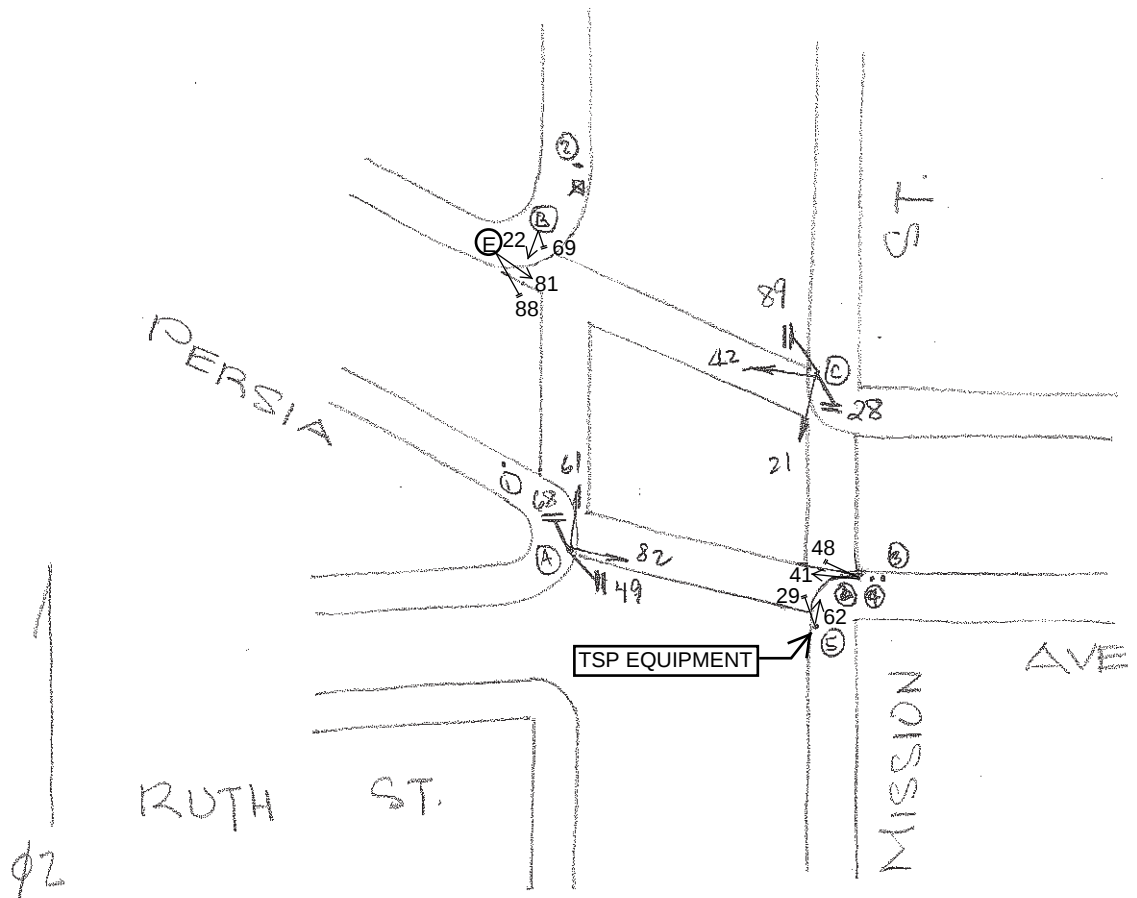

5/3/21

POLE	FUNC.	MAT'L	SIGNAL NO.	MAKE	NO. OF SECT.	SIZE	VISOR	B.P. OR LOUVERS	MOUNT	PED SIGNAL NO.	LEGEND	MESSAGE	MAKE	MOUNT
A	M	S	92	EC	3	12"	FC 12"	No	S	28	COUNT	LED	WH/OR	Dialight
B	S	S	61	EC	3	12"	FC 12"	No	S	89	COUNT	LED	WH/OR	Dialight
C	S	S	22	EC	3	12"	FC 12"	No	T	48	COUNT	LED	WH/OR	Dialight
D	S	S	81	EC	3	12"	FC 12"	No	T	49	COUNT	LED	WH/OR	Dialight
E	S	S	42	EC	3	12"	FC 12"	No	T	68	COUNT	LED	WH/OR	Dialight
			21	EC	3	12"	FC 12"	No	T	69	COUNT	LED	WH/OR	Dialight
			62	EC	3	12"	FC 12"	No	T	88	COUNT	LED	WH/OR	Dialight
			41	EC	3	12"	FC 8"	No	T	89	COUNT	LED	WH/OR	Dialight
1	M	S												
2	M	S												
3	M	S												
4	U	W												
5	U	S												

CONTROLLER CABINET SIZE : ORDINARY BASE CABINET: NO

COMMENTS: ADDED 8 COUNTDOWN PED SIGNALS (2/22/04)
SRC 2011-MB-upgrade signal heads to 12" (only 21 & 42 - 11/10/11)

UPDATE PER FIELD: 3S12"; ADD POLE E & TSP EQUIP.; RELOCATE SIGNAL #62 AND PED #29 TO POLE 5. - ECT 5/3/2021