


MISSION STREET AND RICHLAND AVENUE

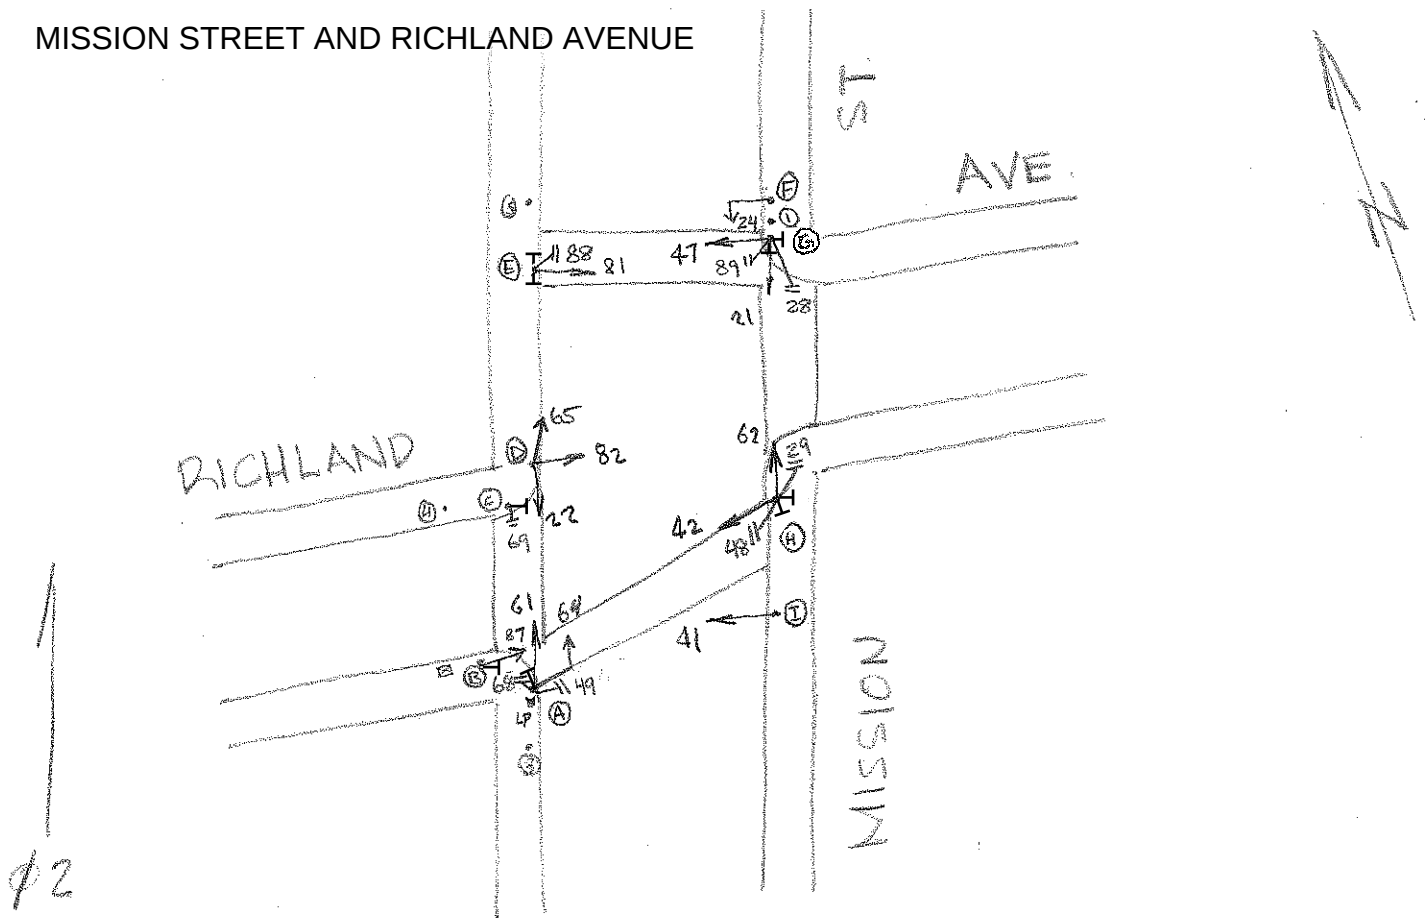

* Pole H: TSP EQP

01/22/2022

POLE	FUNC.	MAT'L	SIGNAL NO.	MAKE	NO. OF SECT.	SIZE	VISOR	B.P. OR LOUVERS	MOUN'T	PED SIGNAL NO.	LEGEND	MESSAGE		MAKE	MOUN'T
												ELEMENT	COLOR		
A	S	S	61	CH	3	8"	T	No	S	49	I	IS-I	W/OR	ICC	S
B	L	S	64	CH	3	12"	T	BP	MAS	68	I	IS-I	W/OR	ICC	S
C	S	S	87	CH	3	8"	T	No	S	69	I	IS-I	W/OR	ICC	S
D	M	S	22	CH	3	8"	T	No	S	88	I	IS-I	W/OR	ICC	S
E	S	S	82	CH	3	8"	T	No	S	89	I	IS-I	W/OR	ICC	S
F	S	S	65	CH	3	8"	T	No	S	28	I	IS-I	W/OR	ICC	T
G	S	S	81	CH	3	12"	T	No	T	29	I	IS-I	W/OR	ICC	S
H*	M/L	S	24	CH	3	12"	T	BP	MAS	48	I	IS-I	W/OR	ICC	S
I	S	S	47	CH	3	12"	T	Louvers	T						
1	M	W	21	CH	3	12"	T	No	T						
			62	CH	3	8"	T	No	S						
3	M/L	S	42	CH	3	8"	T	No	S						
4	U	W	41	CH	3	8"	T	No	T						
5	M/L	S													

CONTROLLER CABINET SIZE : Standard BASE CABINET: Yes

COMMENTS : Install APS per SRC 2021-138, E. Luu
Per field: 21, 81 to 3S12"
Add TSP Equipment note