


03/2017

TRANSPORTATION OF THE PROPERTY OF THE STATE OF THE STATE

TRAFFIC SIGNAL WORK

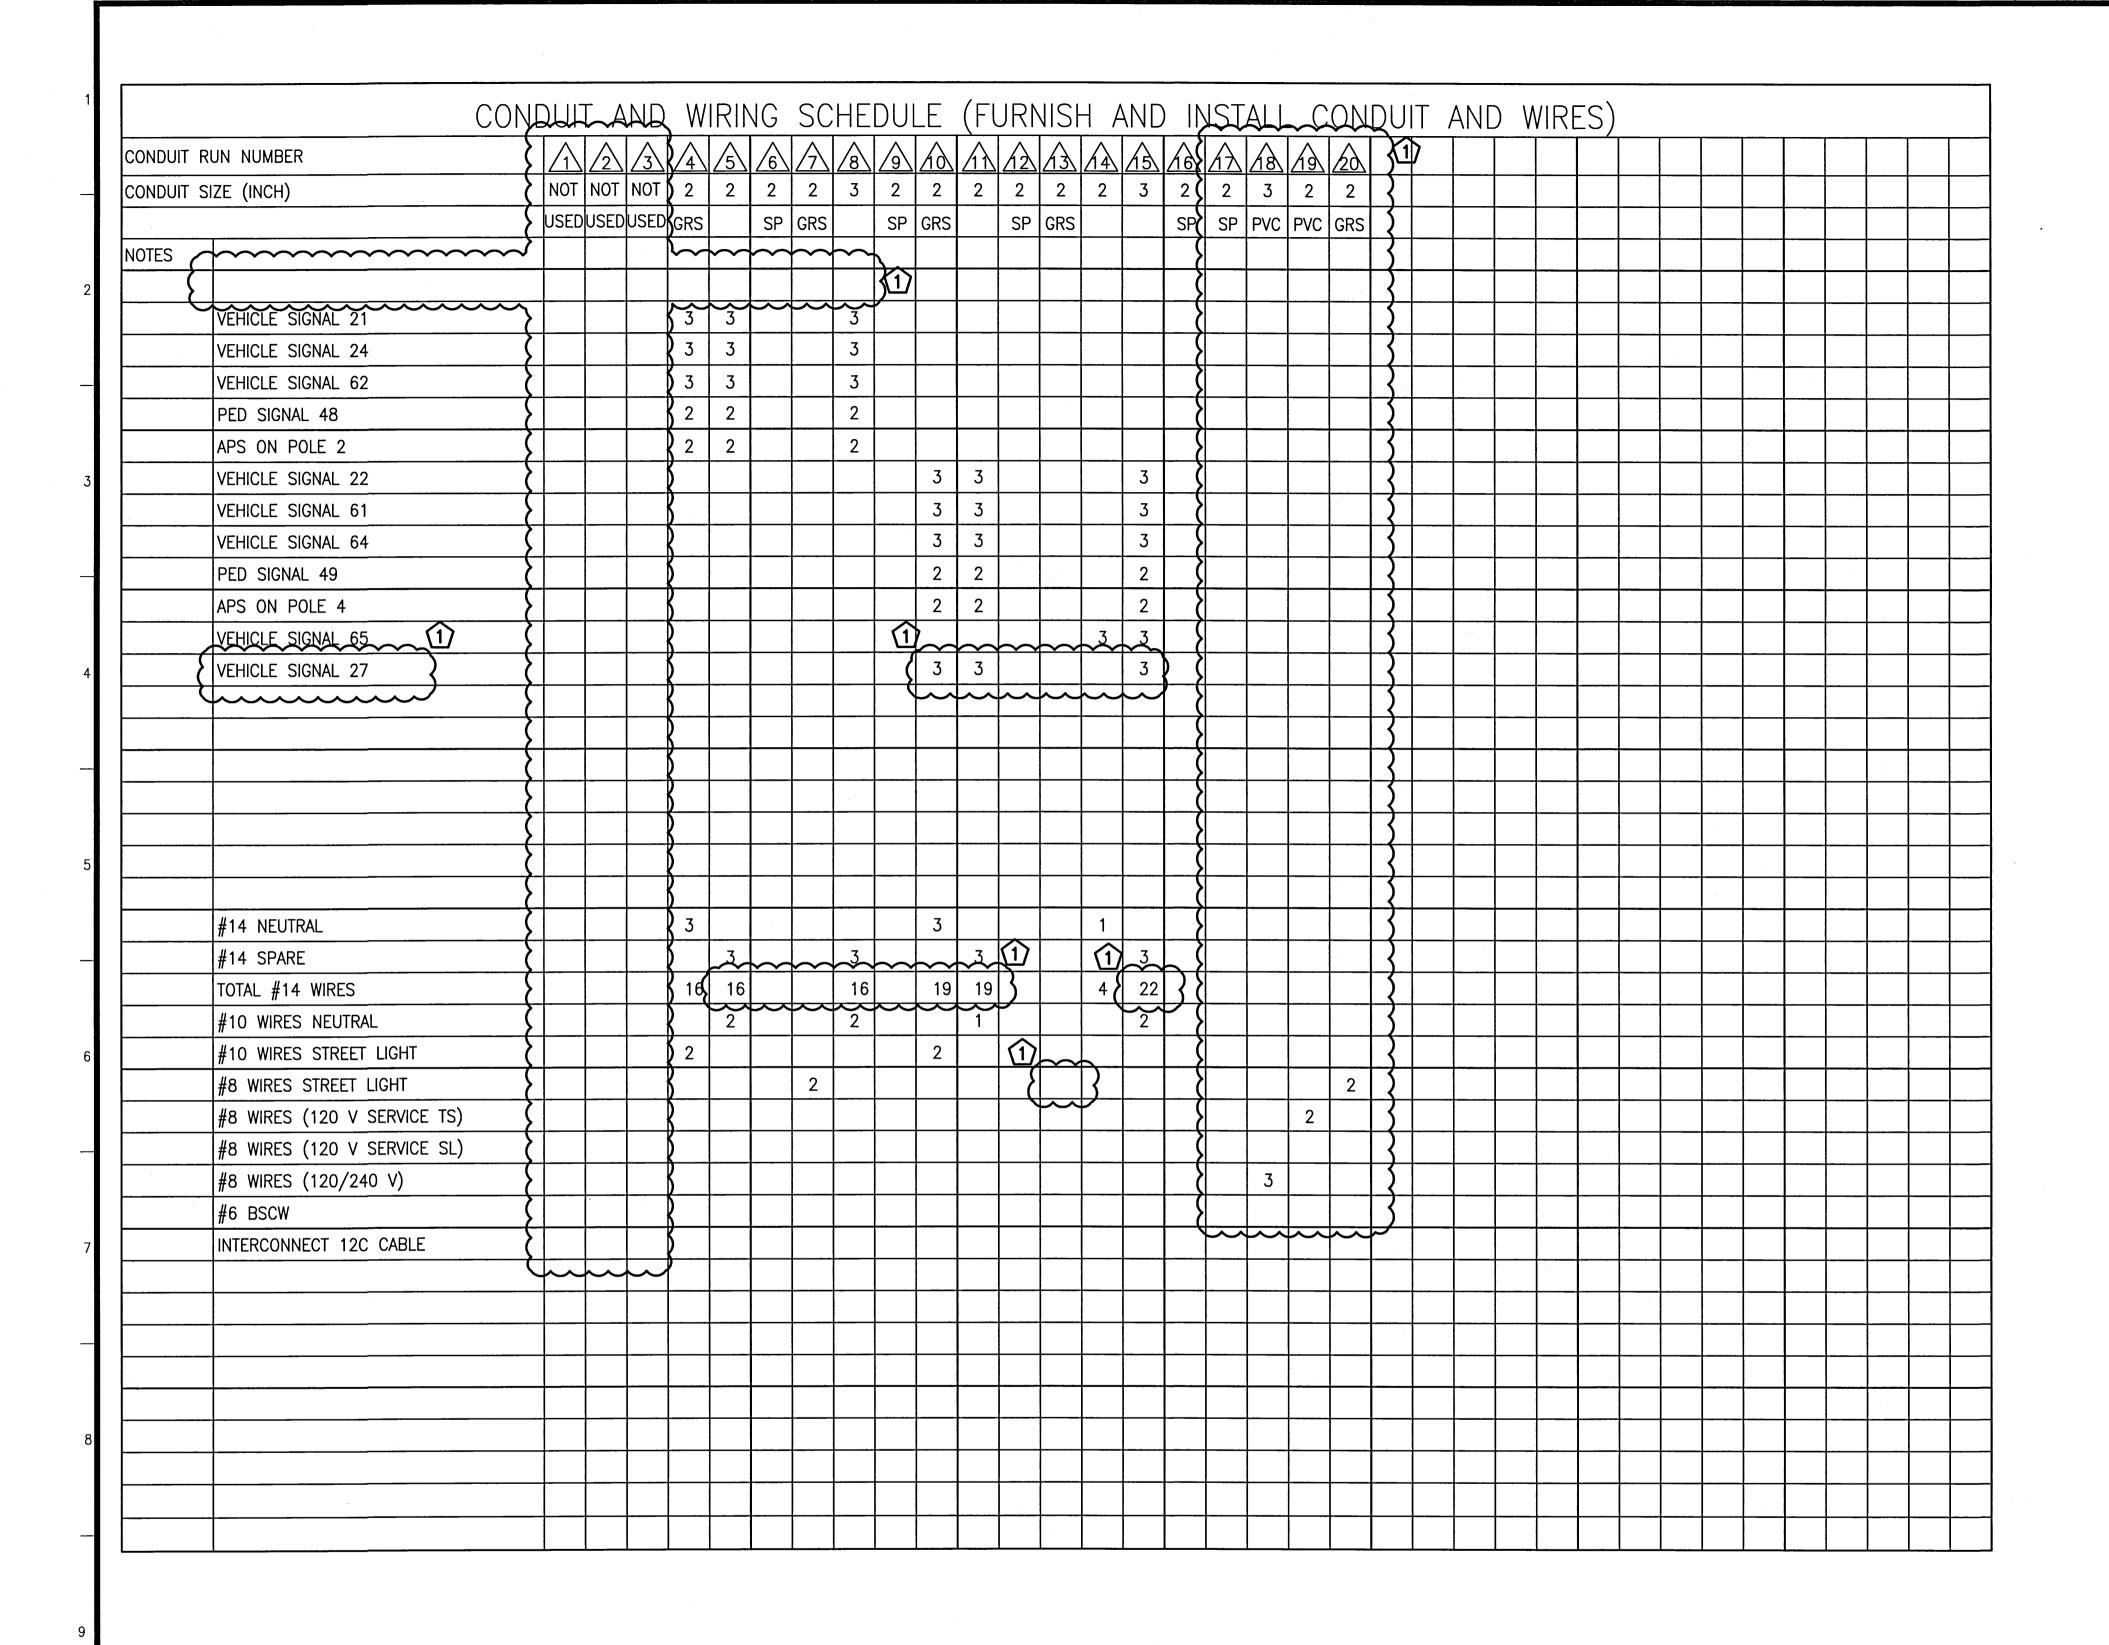

THIS AUTOCAD DRAWING HAS BEEN REVISED AND REPLOTTED SUBSEQUENT TO INTERNAL ENGINEERING APPROVAL AND SIGN-OFF. FOR THOSE SIGNATURES, SEE THE DRAWING PLOTTED AND ISSUED PREVIOUSLY DURING BIDDING. THE SIGNED DRAWING REMAINS VALID EXCEPT FOR THE CHANGES ONLY AS CLEARLY MARKED ON THIS DRAWING AND ISSUED UNDER THIS LATEST REVISION NUMBER AS SHOWN IN THE TABLE OF REVISIONS LOCATED AT THE LOWER LEFT CORNER OF THE DRAWING. ALL ISSUED REVISIONS SUBSEQUENT TO PREVIOUSLY PLOTTED DRAWING DURING BIDDING REMAIN VALID UNLESS SUPERSEDED BY LATER ISSUED REVISIONS. CHECK ALL ISSUED REVISIONS OF THIS DRAWING.

					REFERENCE INFORMATION & FILE NO. OF SURVEYS
(1)	8/15	PCO 1: SHAW ALLEY			
		TRAFFIC SIGNAL CHANGES	DG	SL	
NO.	DATE	DESCRIPTION	BY	APP.	
THIS	DRAWING \	TABLE OF REVISIONS WAS LAST MODIFIED: 08/17/17 11:28, E			





DESIGN & **ENGINEERING** CITY & COUNTY OF SAN FRANCISCO SAN FRANCISCO PUBLIC WORKS 30 VAN NESS AVENUE, 5TH FLOOR SAN FRANCISCO, CA 94102 - 6028

		Date:	DESIGNED:	DATE:
ection Mgr:	PHILIP THWIN		ET/DG	03/201
eputy Division Mgr:	IQBALBHAI DHAPA		DRAWN: SW/DG	DATE: 03/201
vision Mgr:	PATRICK RIVERA		CHECKED:	DATE: 03/201

** ** ** ** ** ** ** ** ** ** ** ** **	PROFESSION T. LANDERS OF THE VEN T. LANDERS OF THE VEN T. LANDERS OF THE VENT	N I N F F D
	TE OF CALIFORNIA	19

	SCALE:	
N CIN	NO	
EER *	SHEET OF	•
103 g	0	Į

TRANSBAY TRANSIT CENTER STREETSCAPE PHASE 1 SHEETS

CONTRACT NO. 2862J DRAWING NO. E-1.1 FILE NO.

MISSION STREET AND SHAW ALLEY CONDUIT AND WIRING SCHEDULE

107.938 REV. NO.