


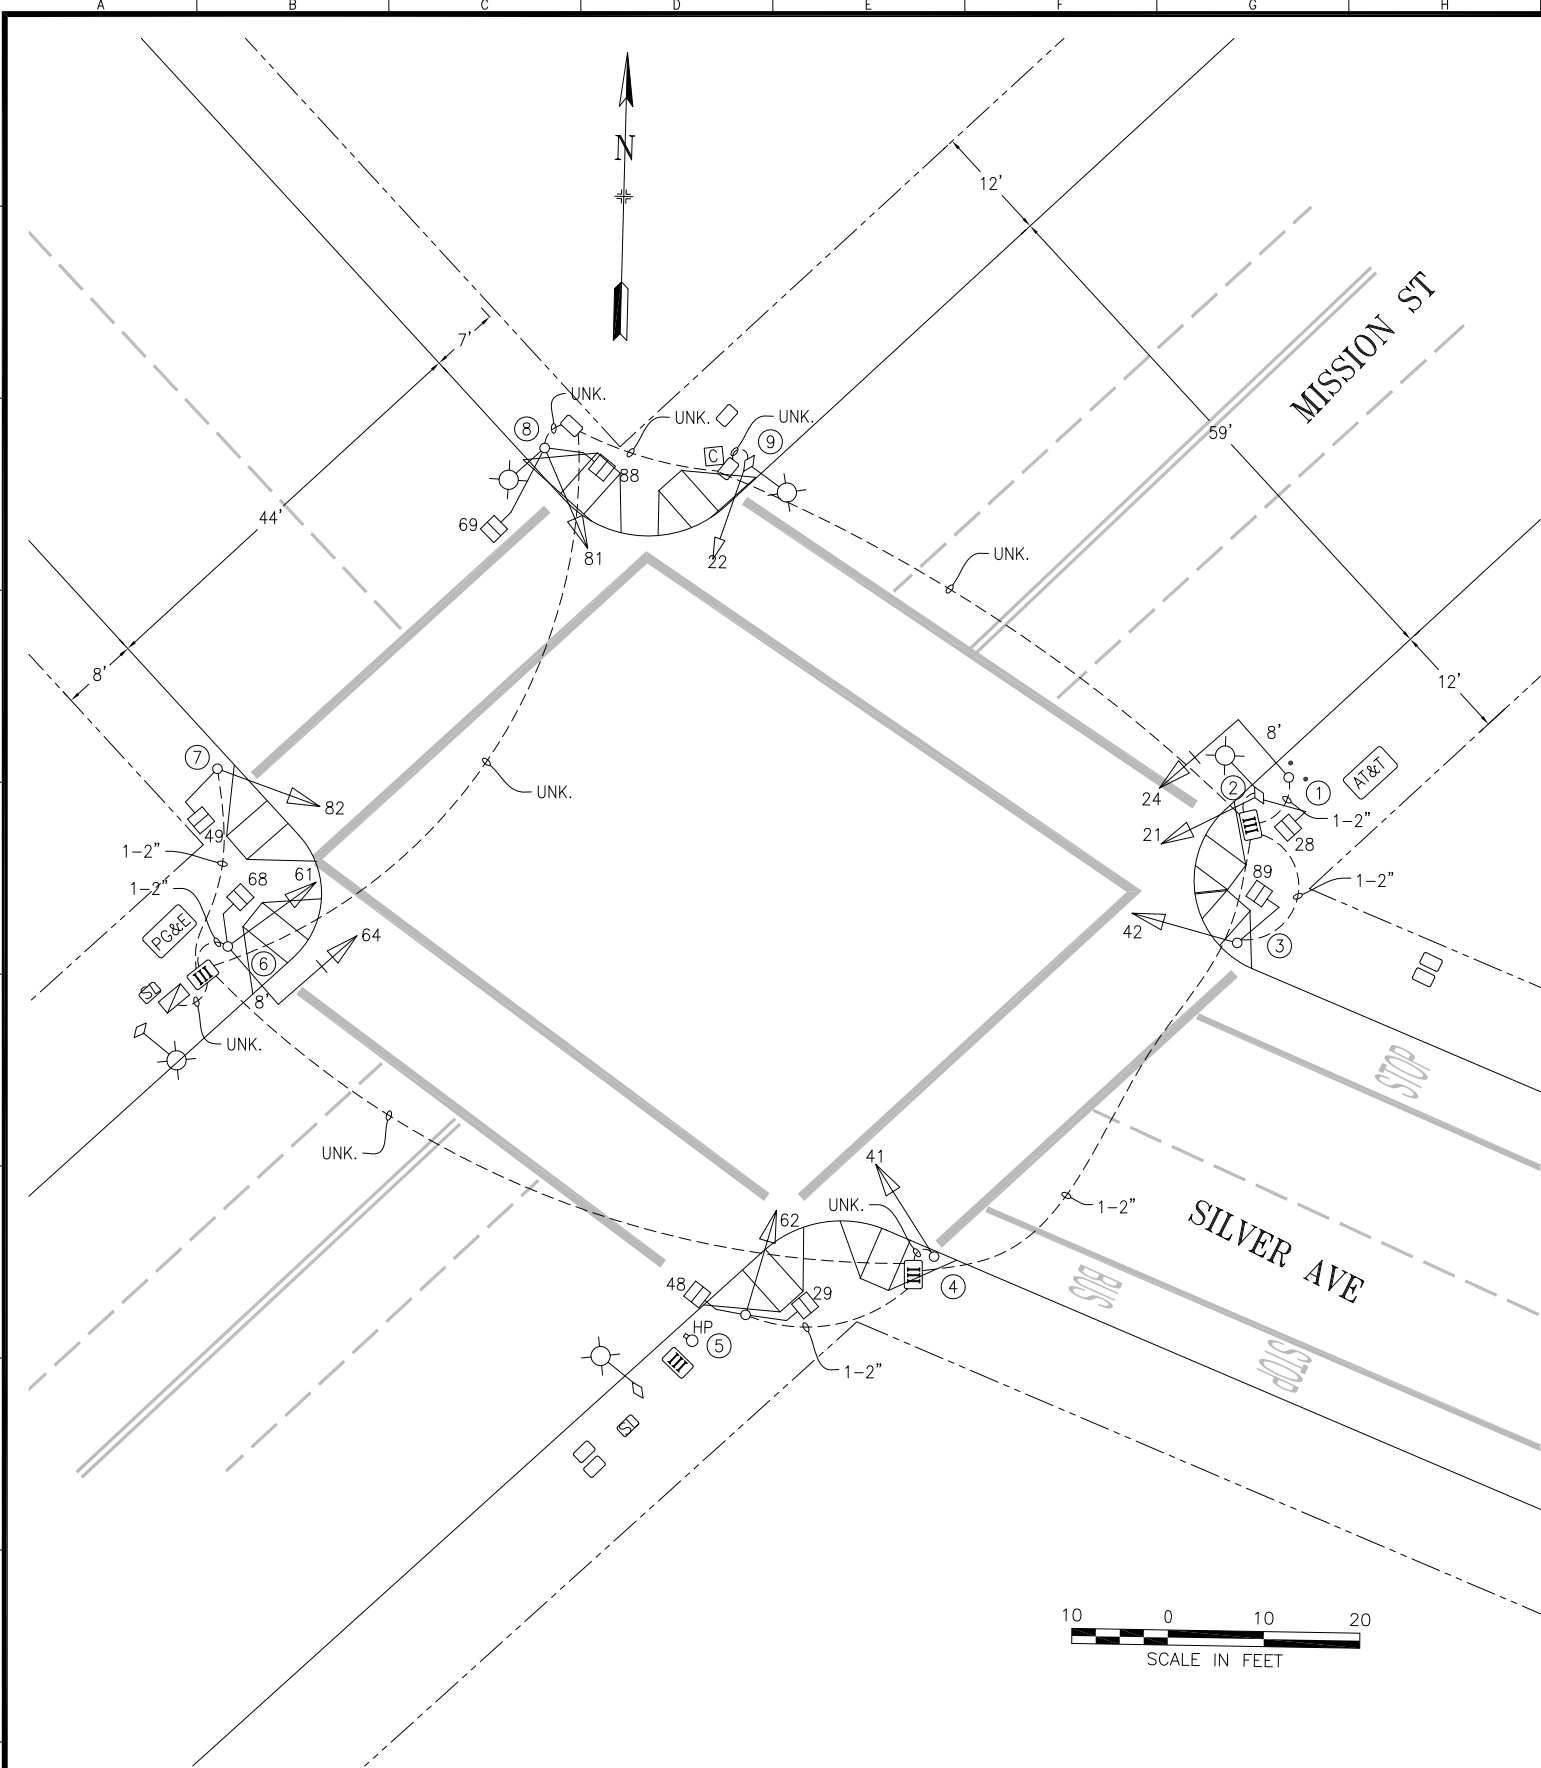

POLE AND EQUIPMENT SCHEDULE										
POLE No.	TYPE OF POLE	VEHICLE SIGNAL					PEDESTRIAN SIGNAL			REMARKS
		No.	TYPE	MOUNTING	VISORS	LOUVERS	No.	TYPE	MOUNTING	
①	16-1-100 W/ 8' MAST ARM	24	3S12"	MAS	T					BACKPLATE
②	MUNI W/ LUMINAIRE	21	3S12"	SV-1-T	T		28	IS-COUNT	SP-1	
③	1-A (10')	42	3S12"	TV-1-T	T		89	IS-COUNT	SP-1	
④	1-A (10')	41	3S12"	TV-1	T					
⑤	1-A (10')	62	3S12"	TV-1-T	T		29 48	IS-COUNT IS-COUNT	SP-1 SP-1	
⑥	16-1-100 W/ 8' MAST ARM	61 64	3S12" 3S12"	SV-1-T MAS	T T		68	1S-COUNT	SP-1	BACKPLATE
⑦	1-A (10')	82	3S12"	TV-1-T	T		49	1S-COUNT	SP-1	
⑧	STREETLIGHT	81 88	3S12"	SV-1-T	T		69 88	1S-COUNT 1S-COUNT	SP-1 SP-1	
⑨	MUNI W/LUMINAIRE	22	3S8"	SV-1-T	FC					EXTERNAL CONDUIT

4	11-16-15	SIGNALS 42 & 81 UPGRADED TO 12" PER SRC 2015-369	JH	MV
3	06-30-15	NEW POLES 1, 5, 6, 7 BY 2183J; 41 TO 12" PER FIELD.	JH	MV
2	01-18-14	POLE & EQUIPMENT SCHEDULE REVISED PER FIELD CHECK	JH	GD
1	06-16-11	PED SIGNALS FOR XING SILVER ACTIVATED VIA SRC #11-73	GD	HQ
NO.	DATE	DESCRIPTION	BY	APP.

TABLE OF REVISIONS
CHECK WITH TRACING TO SEE IF YOU HAVE LATEST REVISION

REFERENCE INFORMATION
& FILE NO. OF SURVEYS



SAN FRANCISCO MUNICIPAL TRANSPORTATION AGENCY
CITY AND COUNTY OF SAN FRANCISCO

DRAWN: GD
CHECKED:

DATE: 04/11
DATE:

SCALE:
AS SHOWN

SHEET OF SHEETS
1 OF 1

TRAFFIC SIGNAL INVENTORY DIAGRAM

MISSION ST AND SILVER AVE

CNN NO.
21765000

REV NO.
4