


MISSION & SPEAR

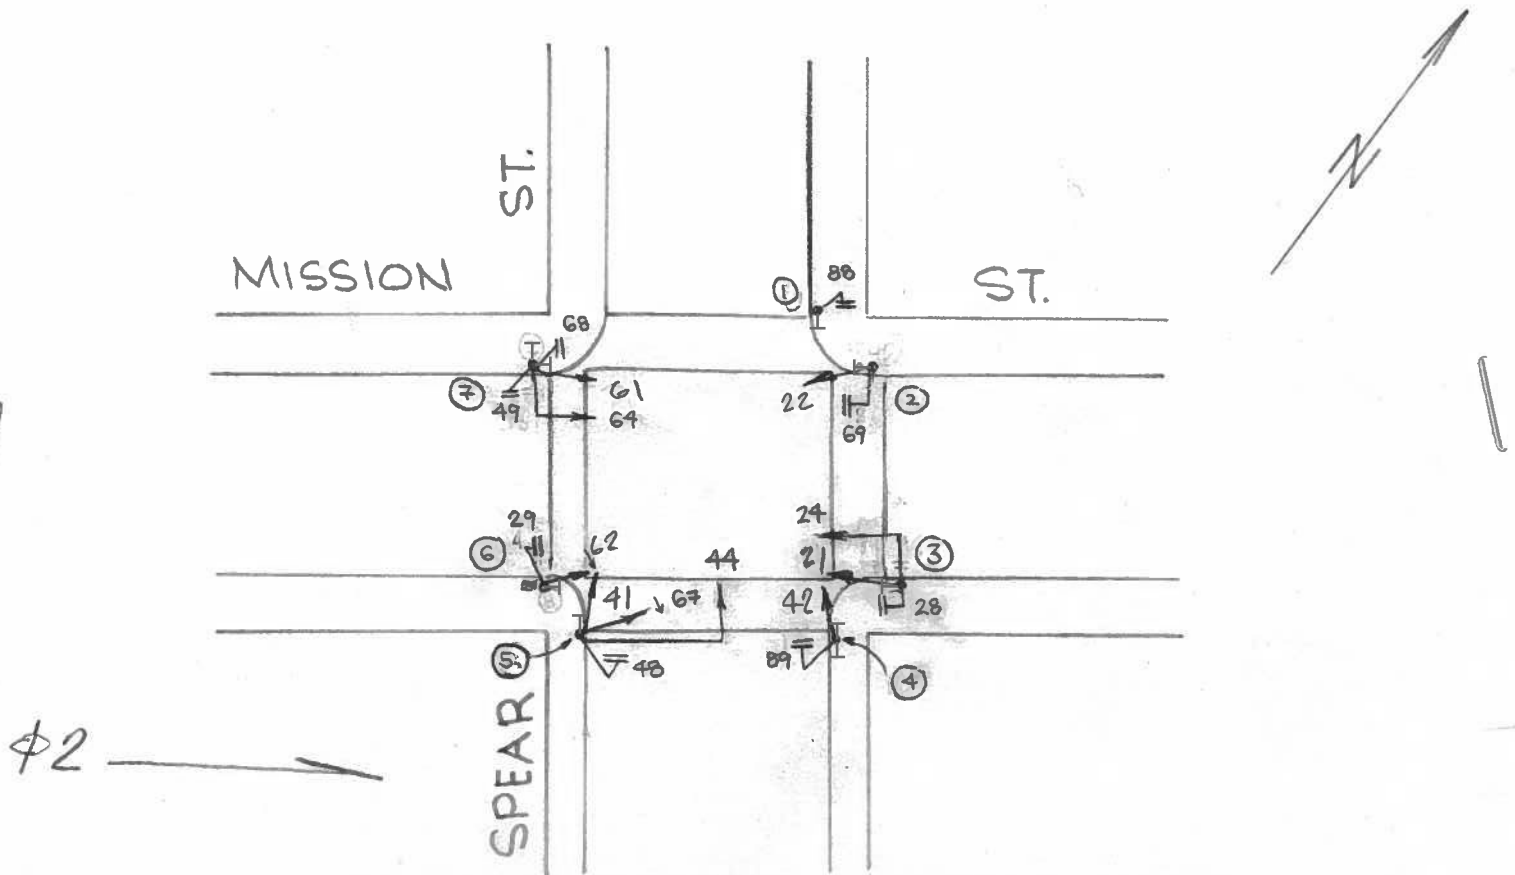

10/19/2021

POLE	FUNC.	MAT'L	SIGNAL NO.	MAKE	NO. OF SECT.	SIZE	VISOR	B.P. OR LOUVERS	MOUNT	PED SIGNAL NO.	LEGEND	MESSAGE		MAKE	MOUNT
												ELEMENT	COLOR		
1	M	S	22	EC	3	12"	FT"	NO	TV-1-T	88	COUNT	GRD	W/O	ED	SP-1
2	I-A	S	21	EC	3	12"	FTB"	NO	SV-1-T	69	COUNT	GRD	W/O	ED	SP-1
3	SL	S	24	EC	3	12"	FTB"	BP	MAS	28	COUNT	GRD	W/O	ED	SP-1
4	M	S	42	EC	3	8"	FTB"	NO	SV-1-T	89	COUNT	GRD	W/O	ED	SP-1
5	SL	S	41	EC	3	8"	FTB"	NO	S	48	COUNT				SP-1
6	M	S	44	EC	3	12"	FTB"	BP	MAS	29	COUNT				SP-1
7	M	S	67		4	12"	FT	NO	S	49	COUNT				SP-1
			62		4	12"	FT	NO	SV-1-T	68	COUNT				SP-1
			61		3	12"	T		SV-1-T						
			64		3	12"	T	BP	MAS						

CONTROLLER CABINET SIZE : MSFIARY BASE CABINET : YES

COMMENTS : Install APS Units per plans. E. Luu (SRC 2021-053)