


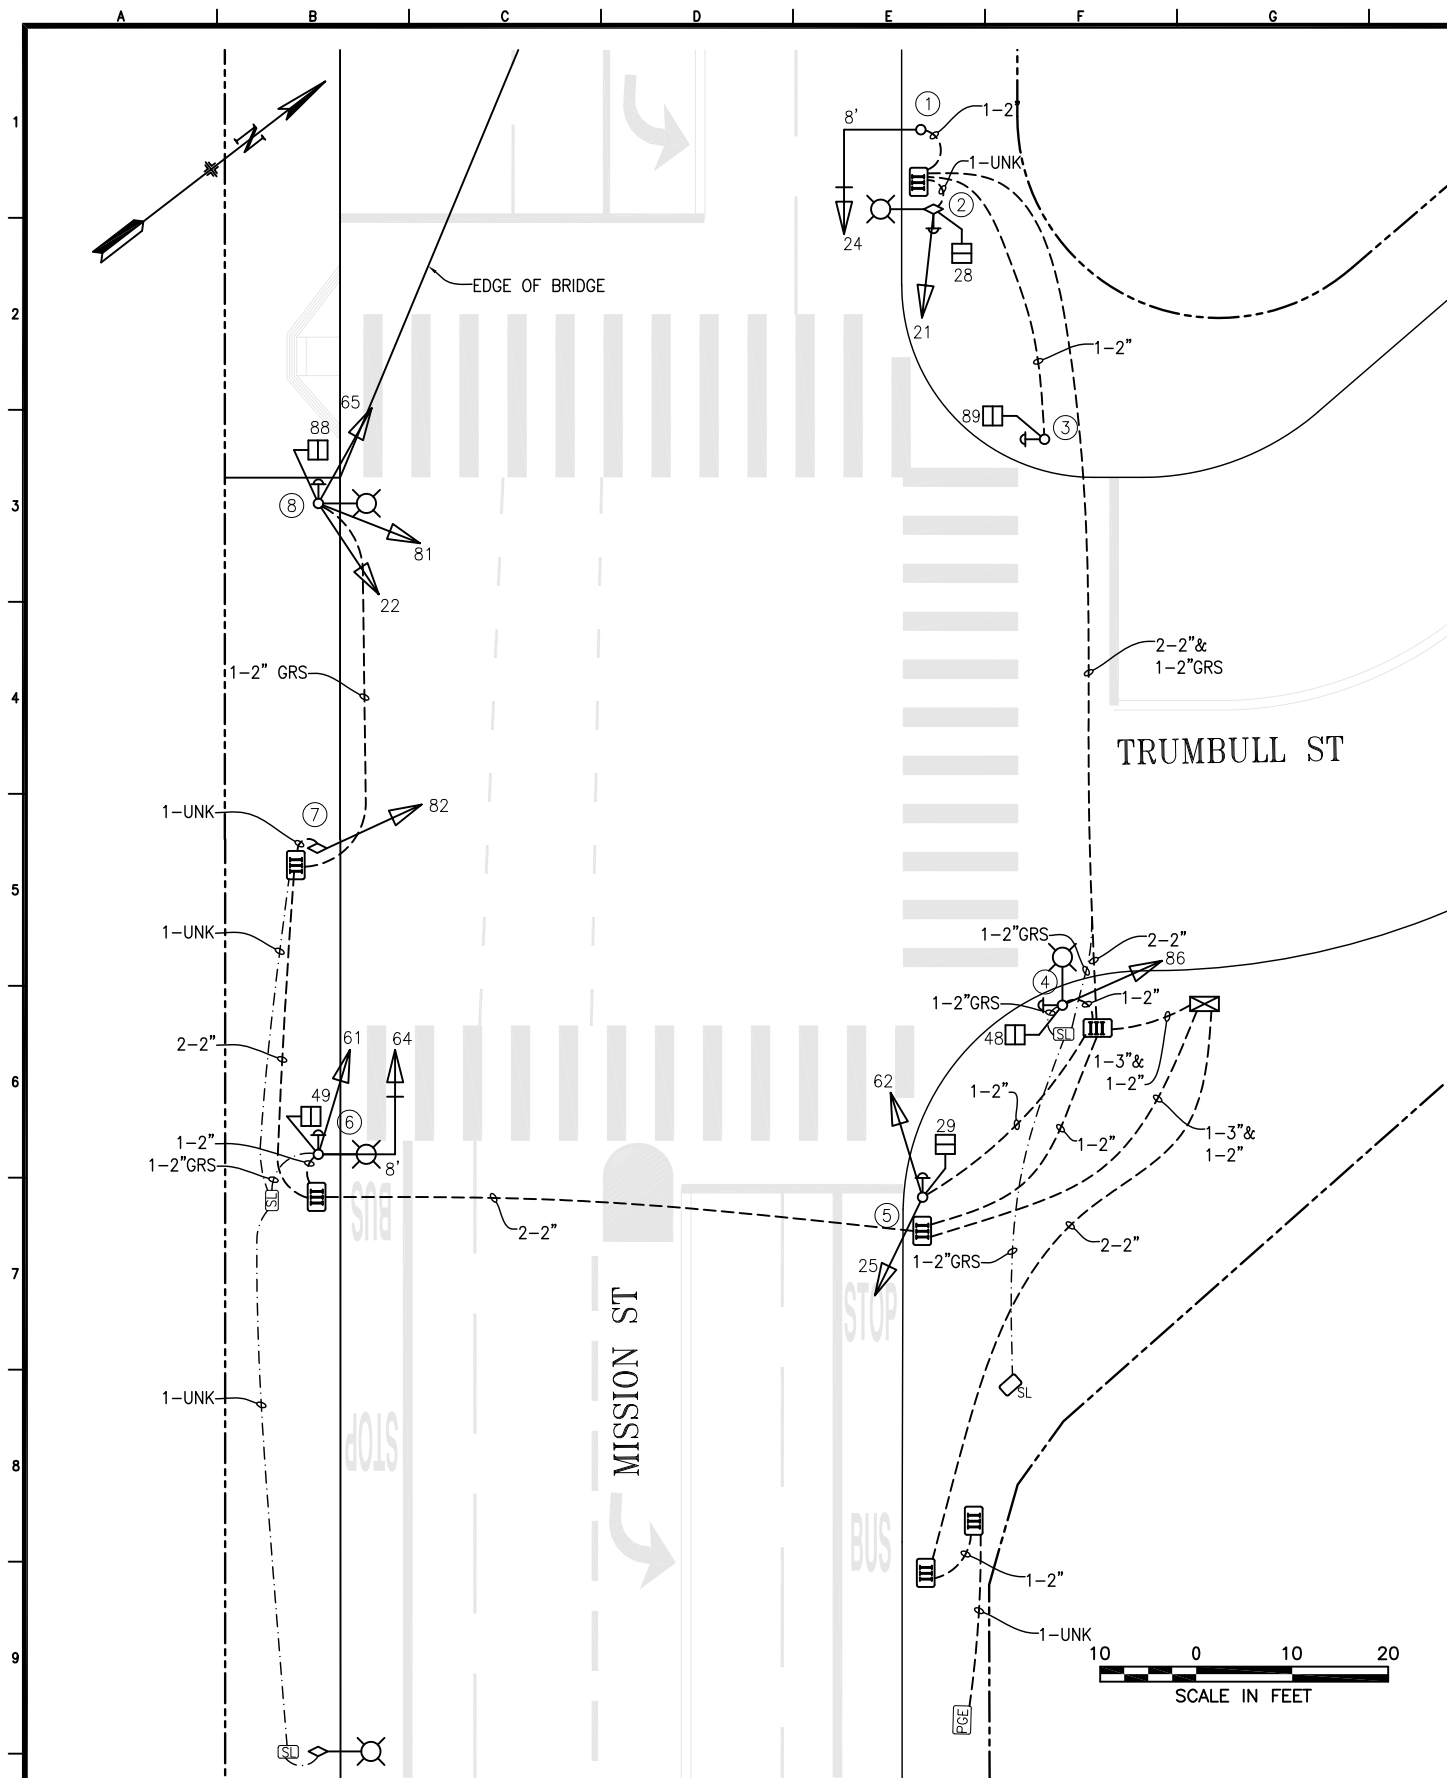

POLE AND EQUIPMENT SCHEDULE											
POLE No.	TYPE OF POLE	LUMINAIRE VOLTAGE/WATTAGE	VEHICLE SIGNAL					PEDESTRIAN SIGNAL			REMARKS
			No.	TYPE	MOUNTING	VISORS	LOUVERS	No.	TYPE	MOUNTING	
①	16-1-100 W/ 8' MAST ARM		24	3S12"	MAS 	T					BACKPLATE
②	EX. MUNI POLE WITH 6' LA	108W LED	21	3S12"	SV-1-T	T		28	1S-COUNT	SP-1	APS - 2W
③	1-A (7')							89	1S-COUNT	TP-1	APS - 2W
④	CITY STANDARD STREET LIGHT	108W LED	86	3S12"	SV-1-T	T		48	1S-COUNT	SP-1	APS - 2W
⑤	1-A (10')		62 25	3S12" 3S12"	TV-2-T	T T		29	1S-COUNT	SP-1	APS - 2W
⑥	19-1-100 W/ 8' MAST ARM & 6' L.A.	108W LED	61 64	3S12" 3S12"	SV-1-T MAS 	T T		49	1S-COUNT	SP-1	APS - 2W BACKPLATE
⑦	EX. MUNI POLE		82	3S12"	SV-1-T	T					
⑧	CITY STANDARD STREET LIGHT W/ CUSTOM FOUNDATION	108W LED	22 65 81	3S12" 3S12" 3S12"	SV-3-TA	T T T		88	1S-COUNT	SP-1	APS - 2W EXTERNAL RISER TO LB CONDULET

SHEET NOTES:

① INSTALL MAS MOUNTING BETWEEN YELLOW AND GREEN SECTIONS.

TABLE OF REVISIONS		CHECK WITH TRACING TO SEE IF YOU HAVE LATEST REVISION	
NO.	DATE	DESCRIPTION	BY APP.
1	8/23/18	APS INSTALLED PER SRC 2017-367	JH GD
0	10/17/17	UPGRADE BY 2534J; CONVERTED FROM CONTRACT PLANS	JH GD

REFERENCE INFORMATION & FILE NO. OF SURVEYS



SAN FRANCISCO MUNICIPAL TRANSPORTATION AGENCY
CITY AND COUNTY OF SAN FRANCISCO

DRAWN:	DATE:
JH	3/2018
CHECKED:	DATE:
GD	3/2018

SCALE:
AS SHOWN
SHEET OF SHEETS
01 OF 01

TRAFFIC SIGNAL INVENTORY DIAGRAM
MISSION STREET AND TRUMBULL STREET

CNN NO.
21703000
REV NO.
1