


PINE & MONTGOMERY

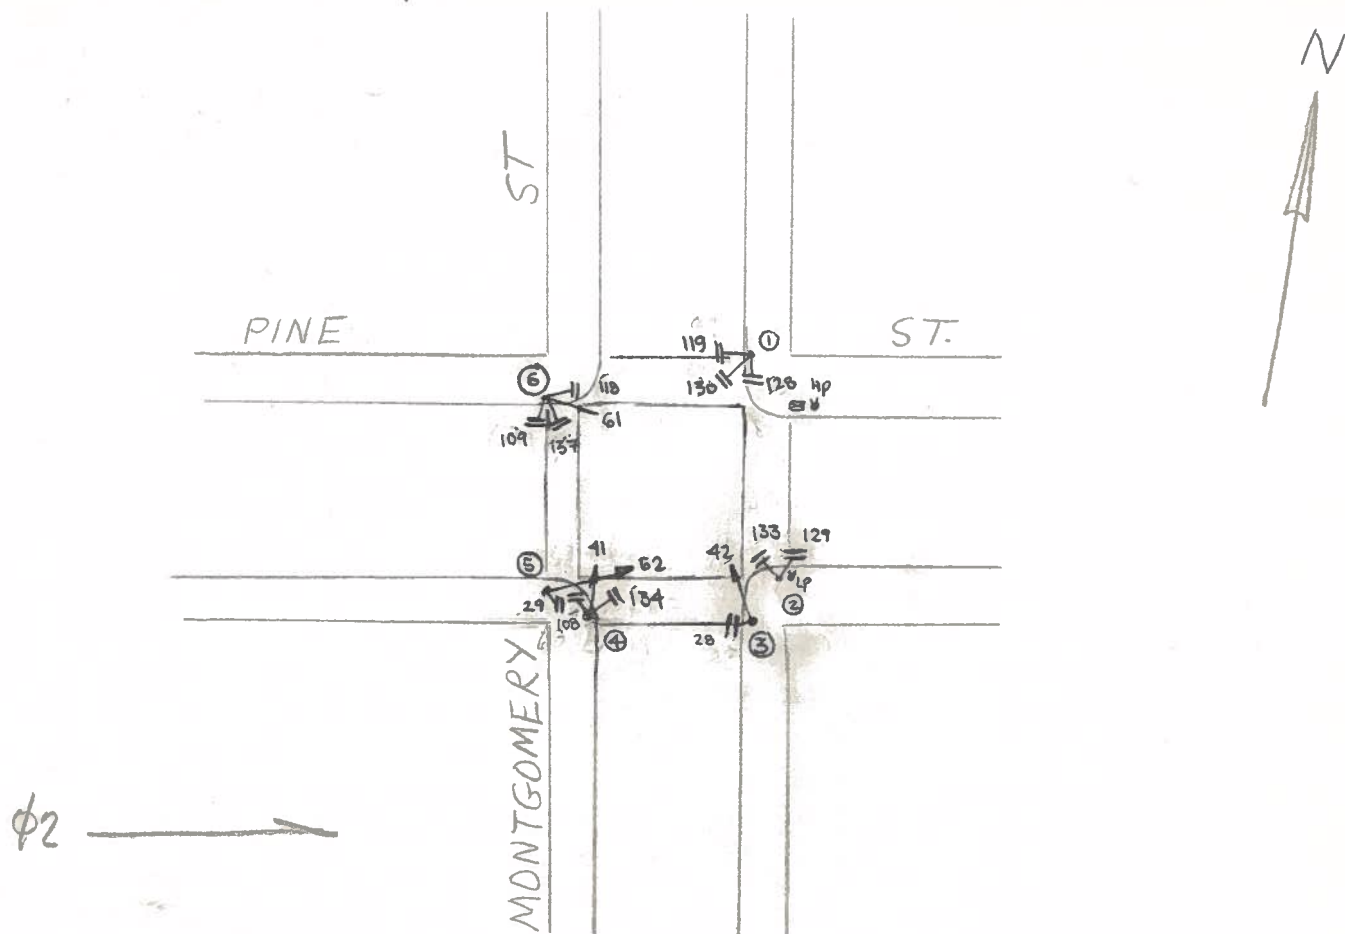

09/29/2019

POLE	FUNC.	MAT'L	SIGNAL NO.	MAKE	NO. OF SECT.	SIZE	VISOR	B.P. OR LOUVERS	MOUN'T	PED SIGNAL NO.	LEGEND	MESSAGE		MAKE	MOUN'T
												ELEMENT	COLOR		
1	L	S	42	EG	3	12"	FT	NO	TV-T	119	COUNT	1S	W/OR	100	S
2	L	S	41	EC	3	12"	FT	NO	S	128	COUNT	1S	W/OR	100	S
3	S	S	62	EG	3	12"	FT	NO	TV-T	130	COUNT	1S	W/OR	100	S
4	L	S	61	EG	3	12"	FT	NO	S	129	COUNT	1S	W/OR	100	SP-2-T
5	S	S			3		FT	NO		133	COUNT	1S	W/OR	100	SP-2-T
6	L	S			3		FT	NO		28	COUNT	1S	W/OR	100	SP-1
					3		FT	NO		108	COUNT	1S	W/OR	100	S
					3		FT	NO		134	COUNT	1S	W/OR	100	S
										29	COUNT	1S	W/OR	100	SP-1
										109	COUNT	1S	W/OR	100	S
										118	COUNT	1S	W/OR	100	S
										137	COUNT	1S	W/OR	100	S

CONTROLLER CABINET SIZE : ORDINARY BASE CABINET : NO

COMMENTS : Signals #61, 62, 81, 82 upgraded to 12" for SP-2-T

NOMA-SOMA RETIMING : UPDATE PED PHASE LABEL (SRC 2019-281)
UPDATE VEH PHASE LABEL AS PER TIMING CARD - C SPERRIT